#448664

15-00-035-000 ??

15-00-035-A

LAUNDON • SIMON • CAHL & ASSOC., INC.
CONSULTING ENGINEERS & SURVEYORS
1110 MIDDLE AVE., ELYRIA, O. 44035

SURVEY FOR
BOARD OF PUBLIC AFFAIRS OF
THE VILLAGE OF LAGRANGE
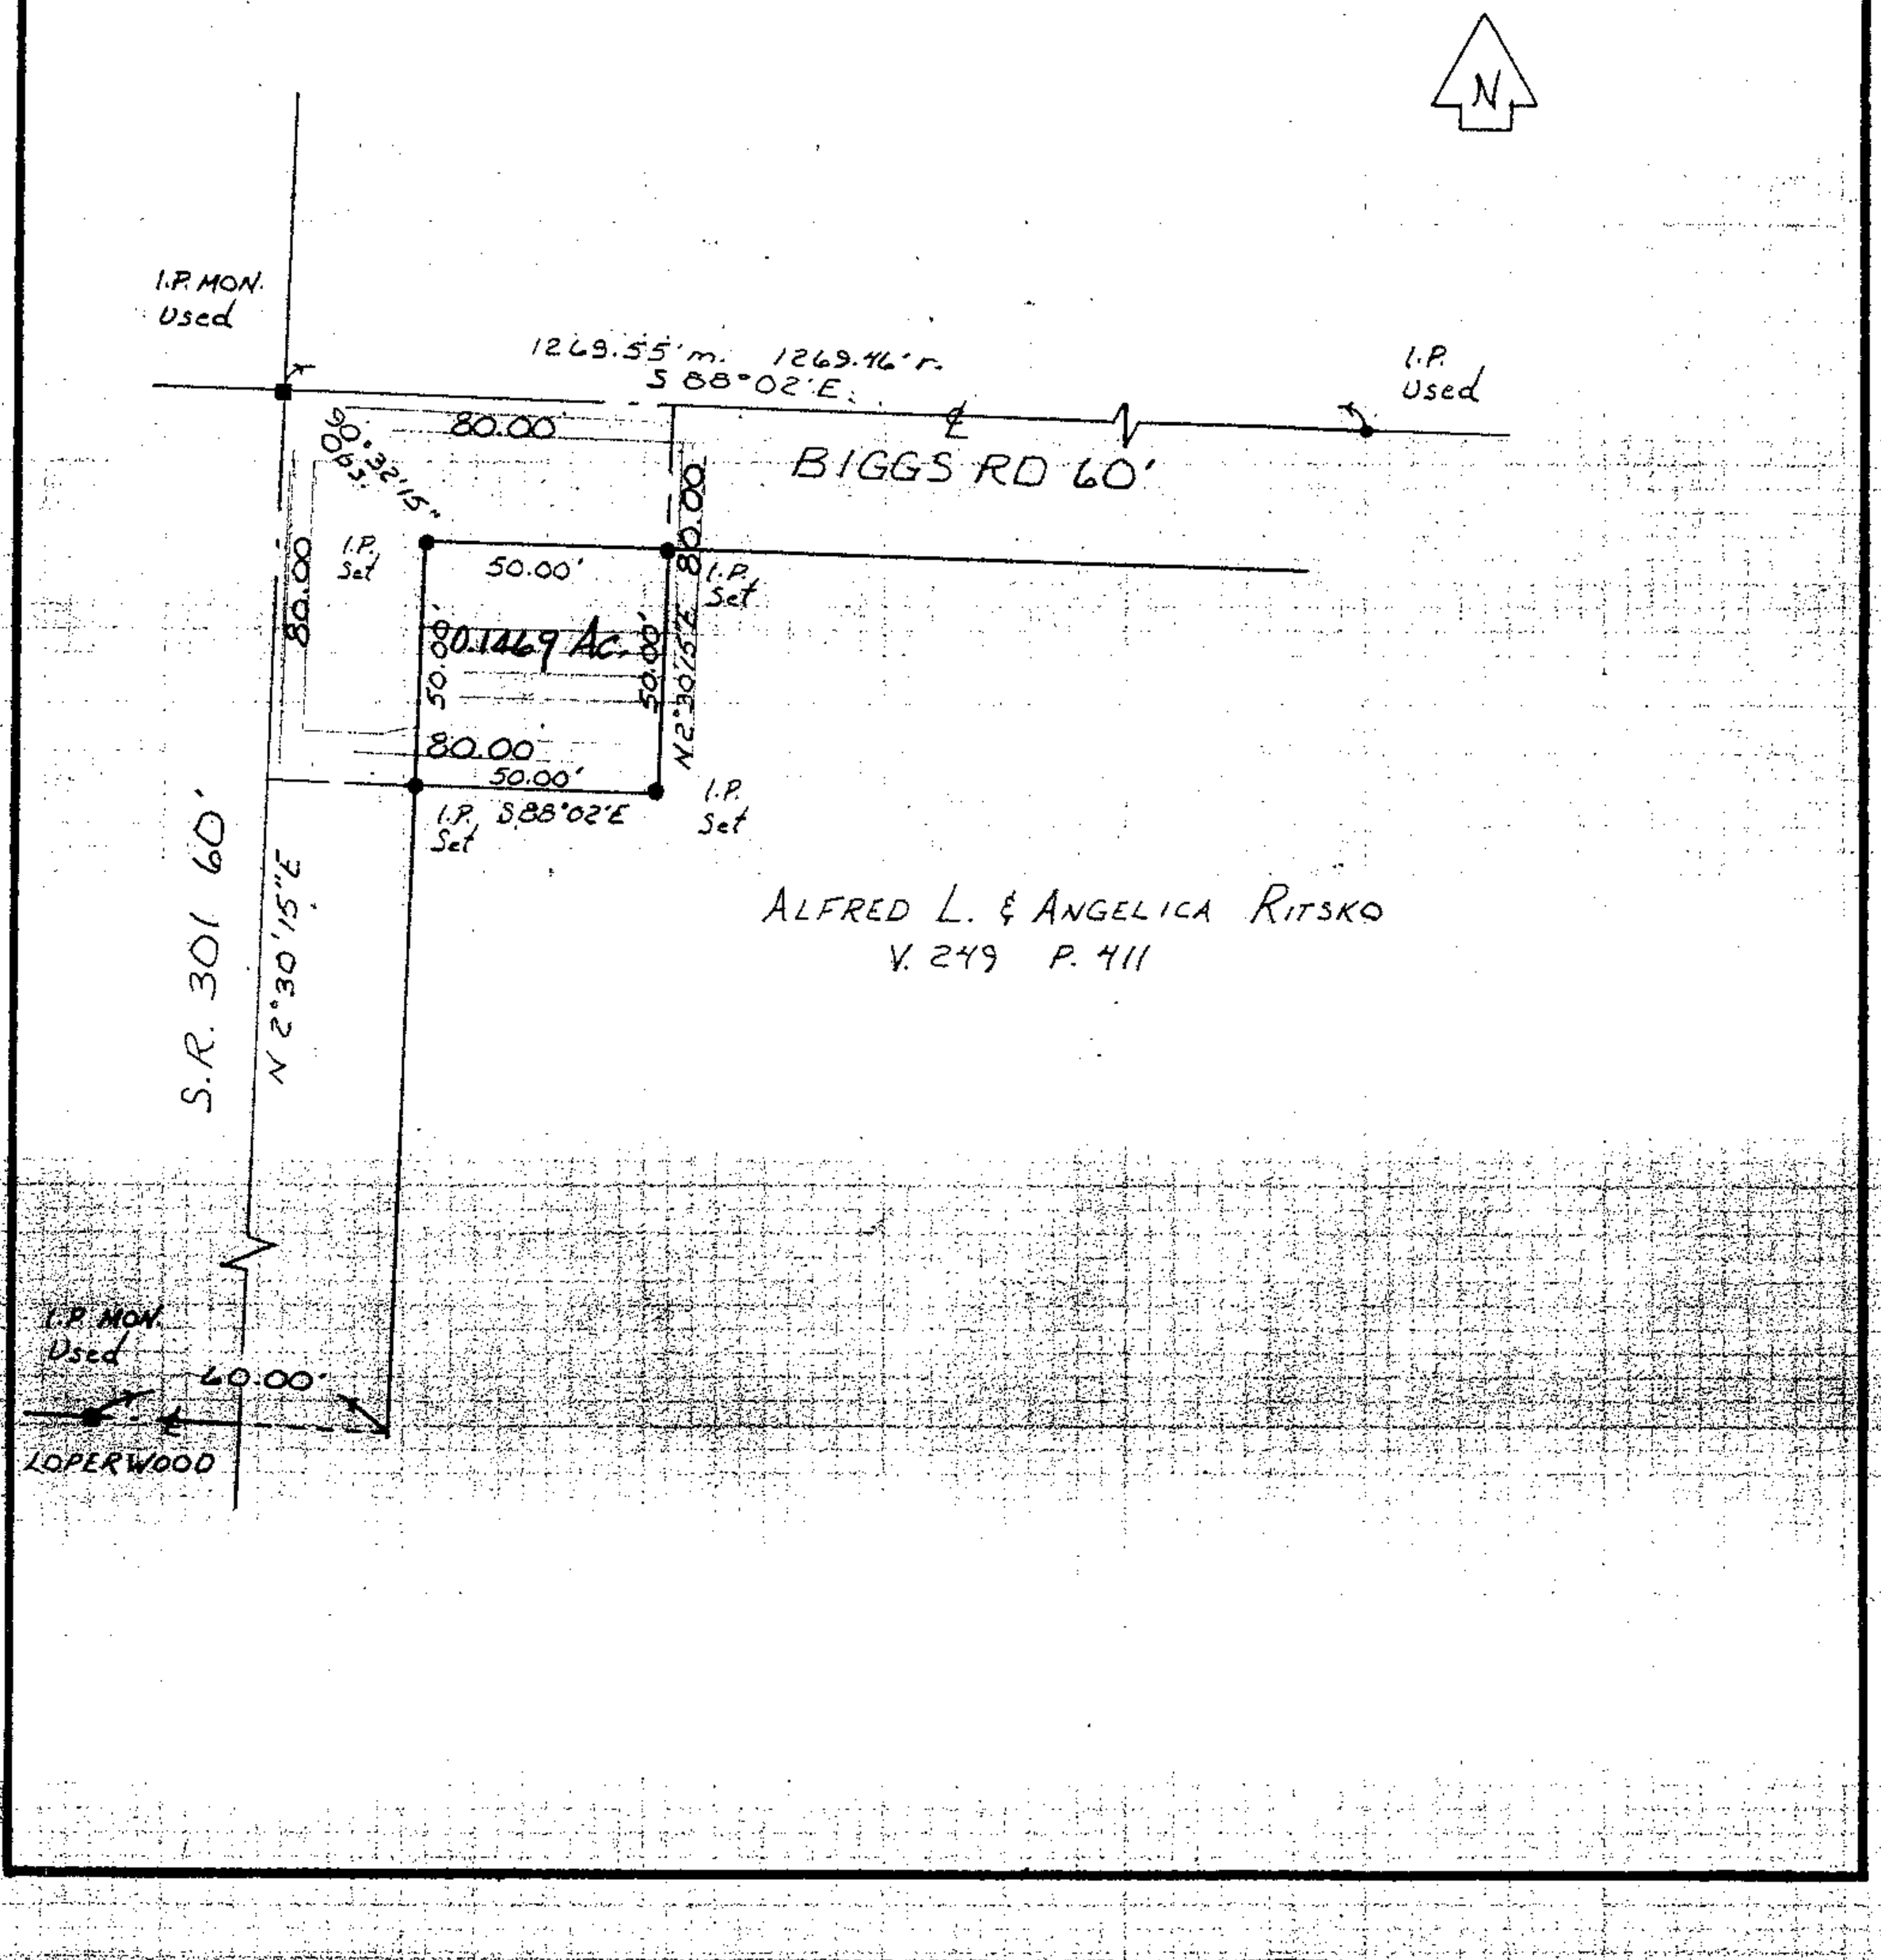
Orig. Lot 35	City of	Date 12-20-91 Scale 1"=50'
Orig. Sec	Village of	Dwn. by RC Chkd. by RS
Tract	County of LORAIN	Job No. 91-2132 F.B. 222/44
Township of LAGRANGE	State of OHIO	Printed