#44872

15-00-046-104-???
15-00-046-A

LAUNDON • SIMON • CAHL & ASSOC., INC.
CONSULTING ENGINEERS & SURVEYORS
110 MIDDLE AVE., ELYRIA, O. 44035

SURVEY FOR
ALLTELL CORPORATION
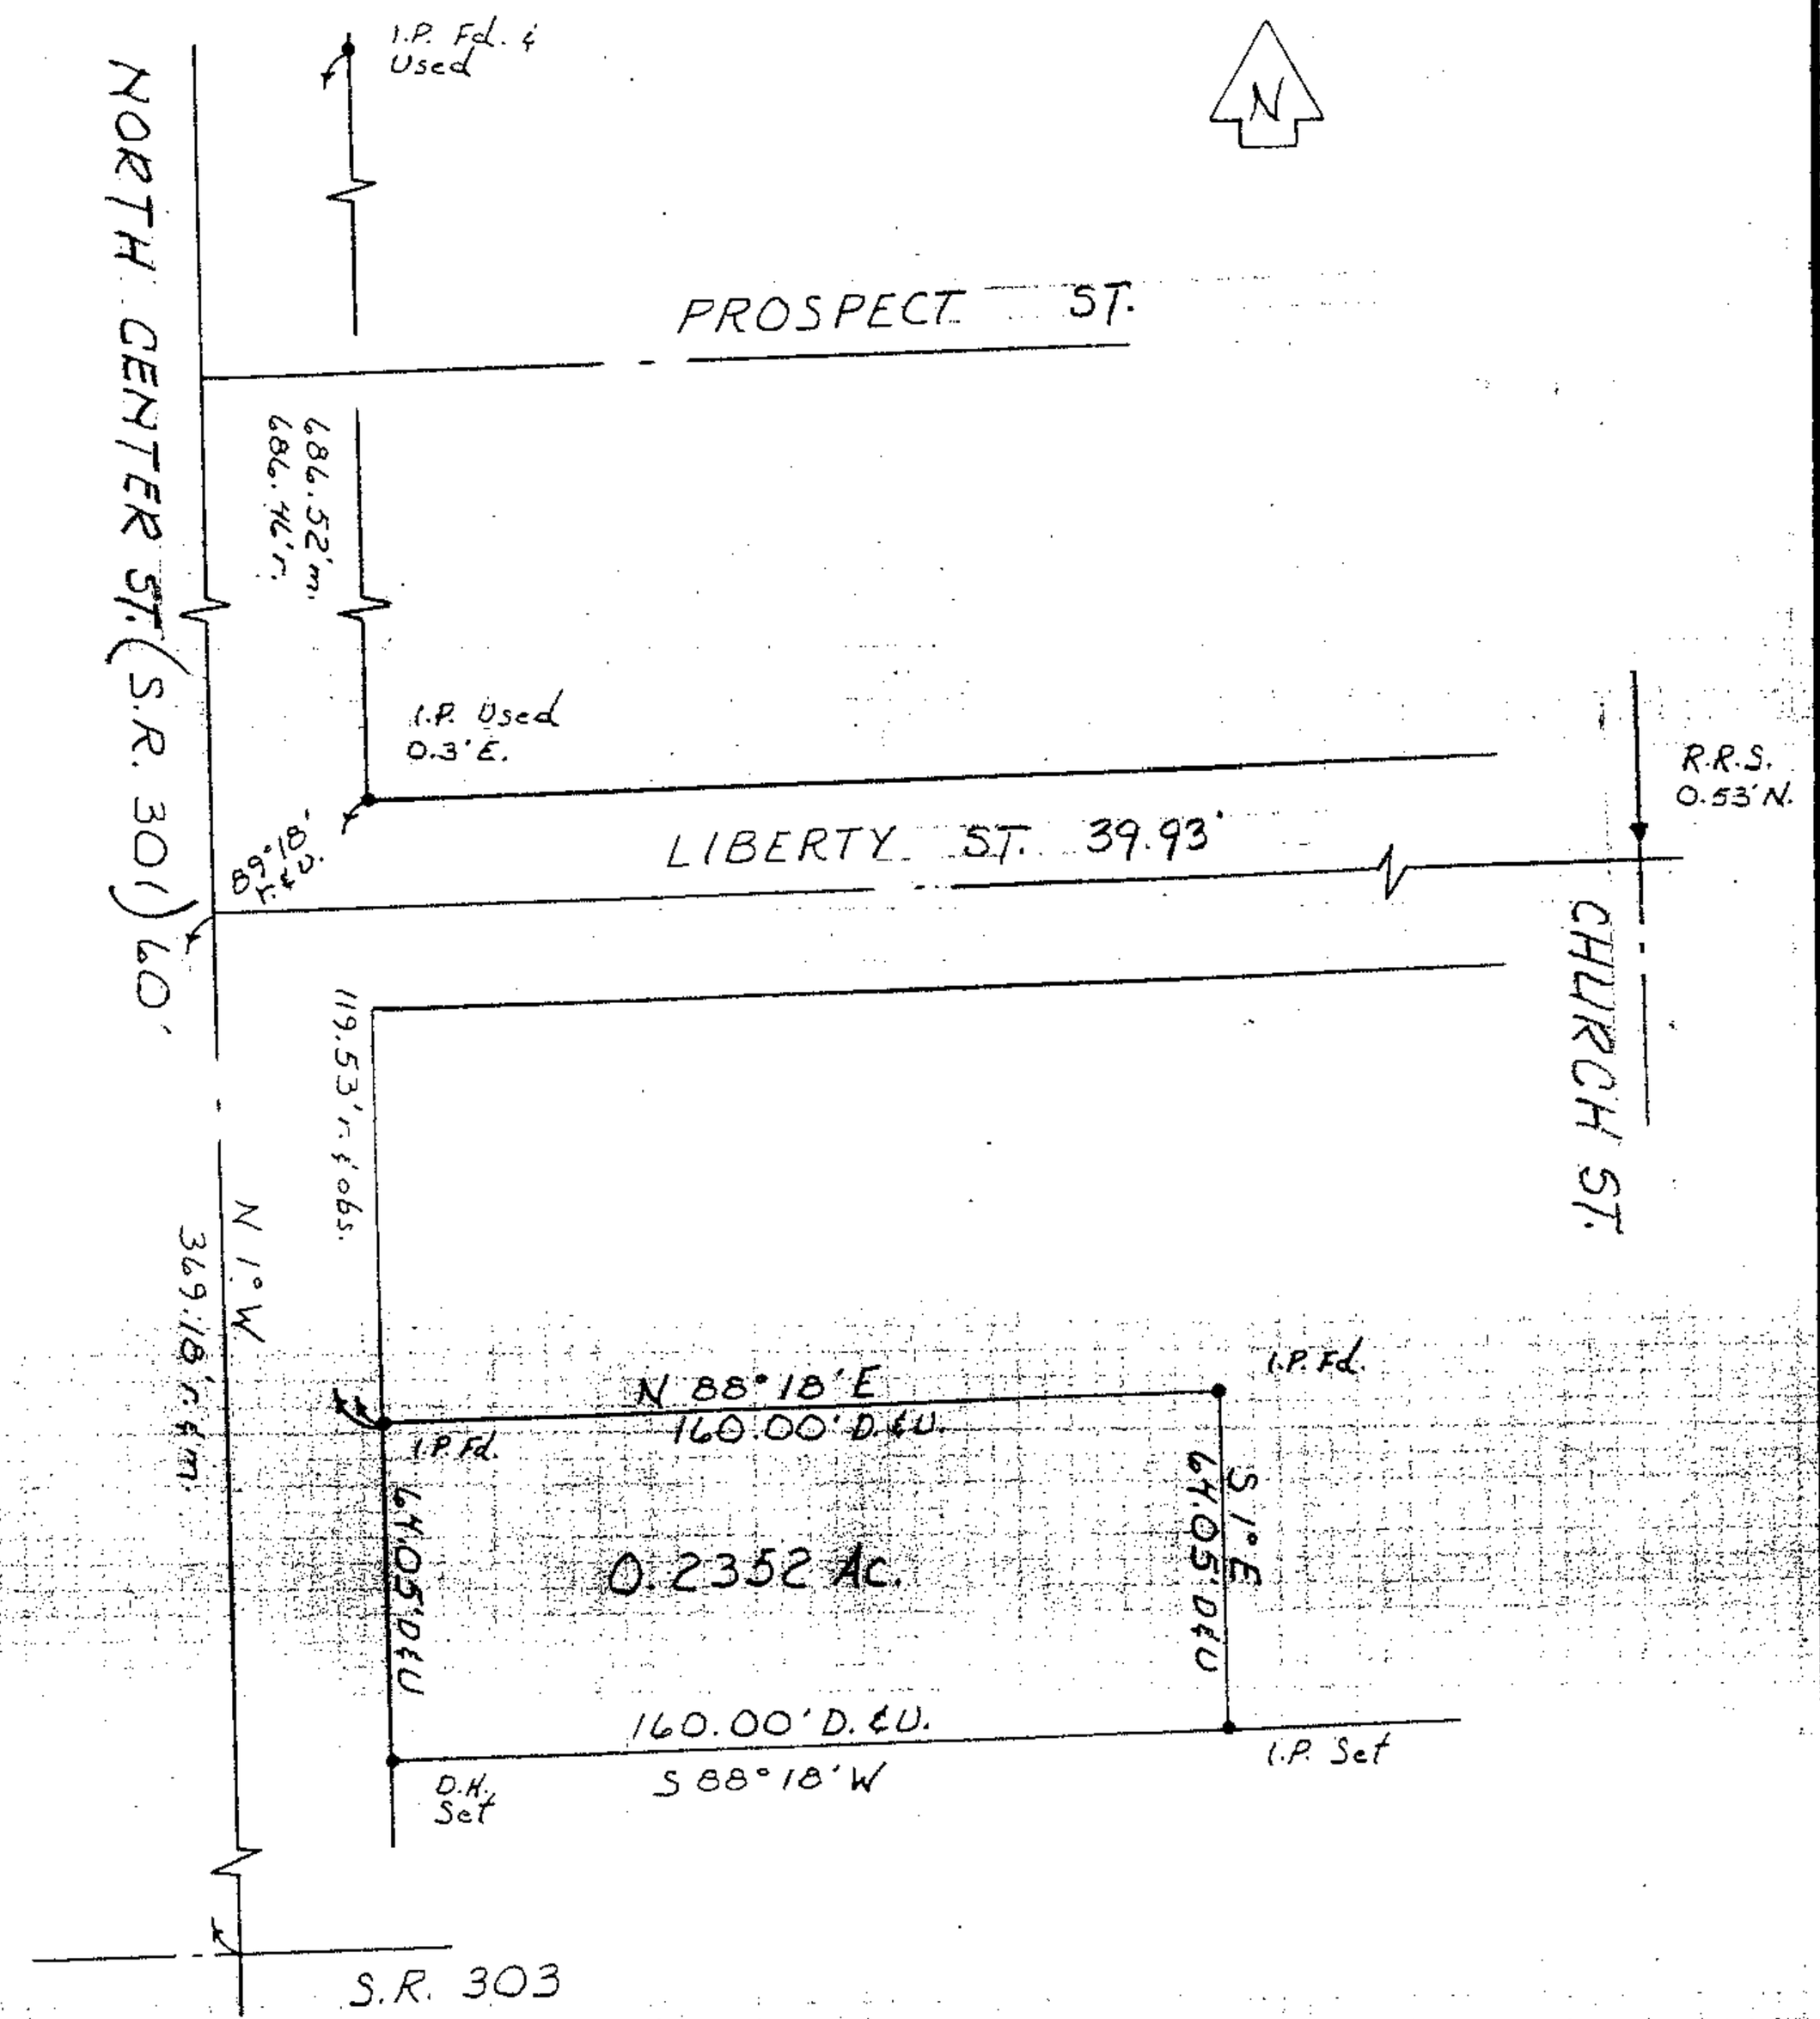
Orig. Lot 46	City of	Date 12-6-91 Scale 1"=50'
Orig. Sec	Village of LAGRANGE	Dwn. by RC Chkd. by RS
Tract	County of LORAIN	Job No. 91-2116 F.B. 222/34
Township of LAGRANGE	State of OHIO	Printed