#4494

06-25-174-103-005
004

LAUNDON . SIMON . CAHL & ASSOC. INC.
CONSULTING ENGINEERS & SURVEYORS
[redacted] ELYRIA, OHIO 44035

SURVEY FOR: 6-51

MATT McGUIRE
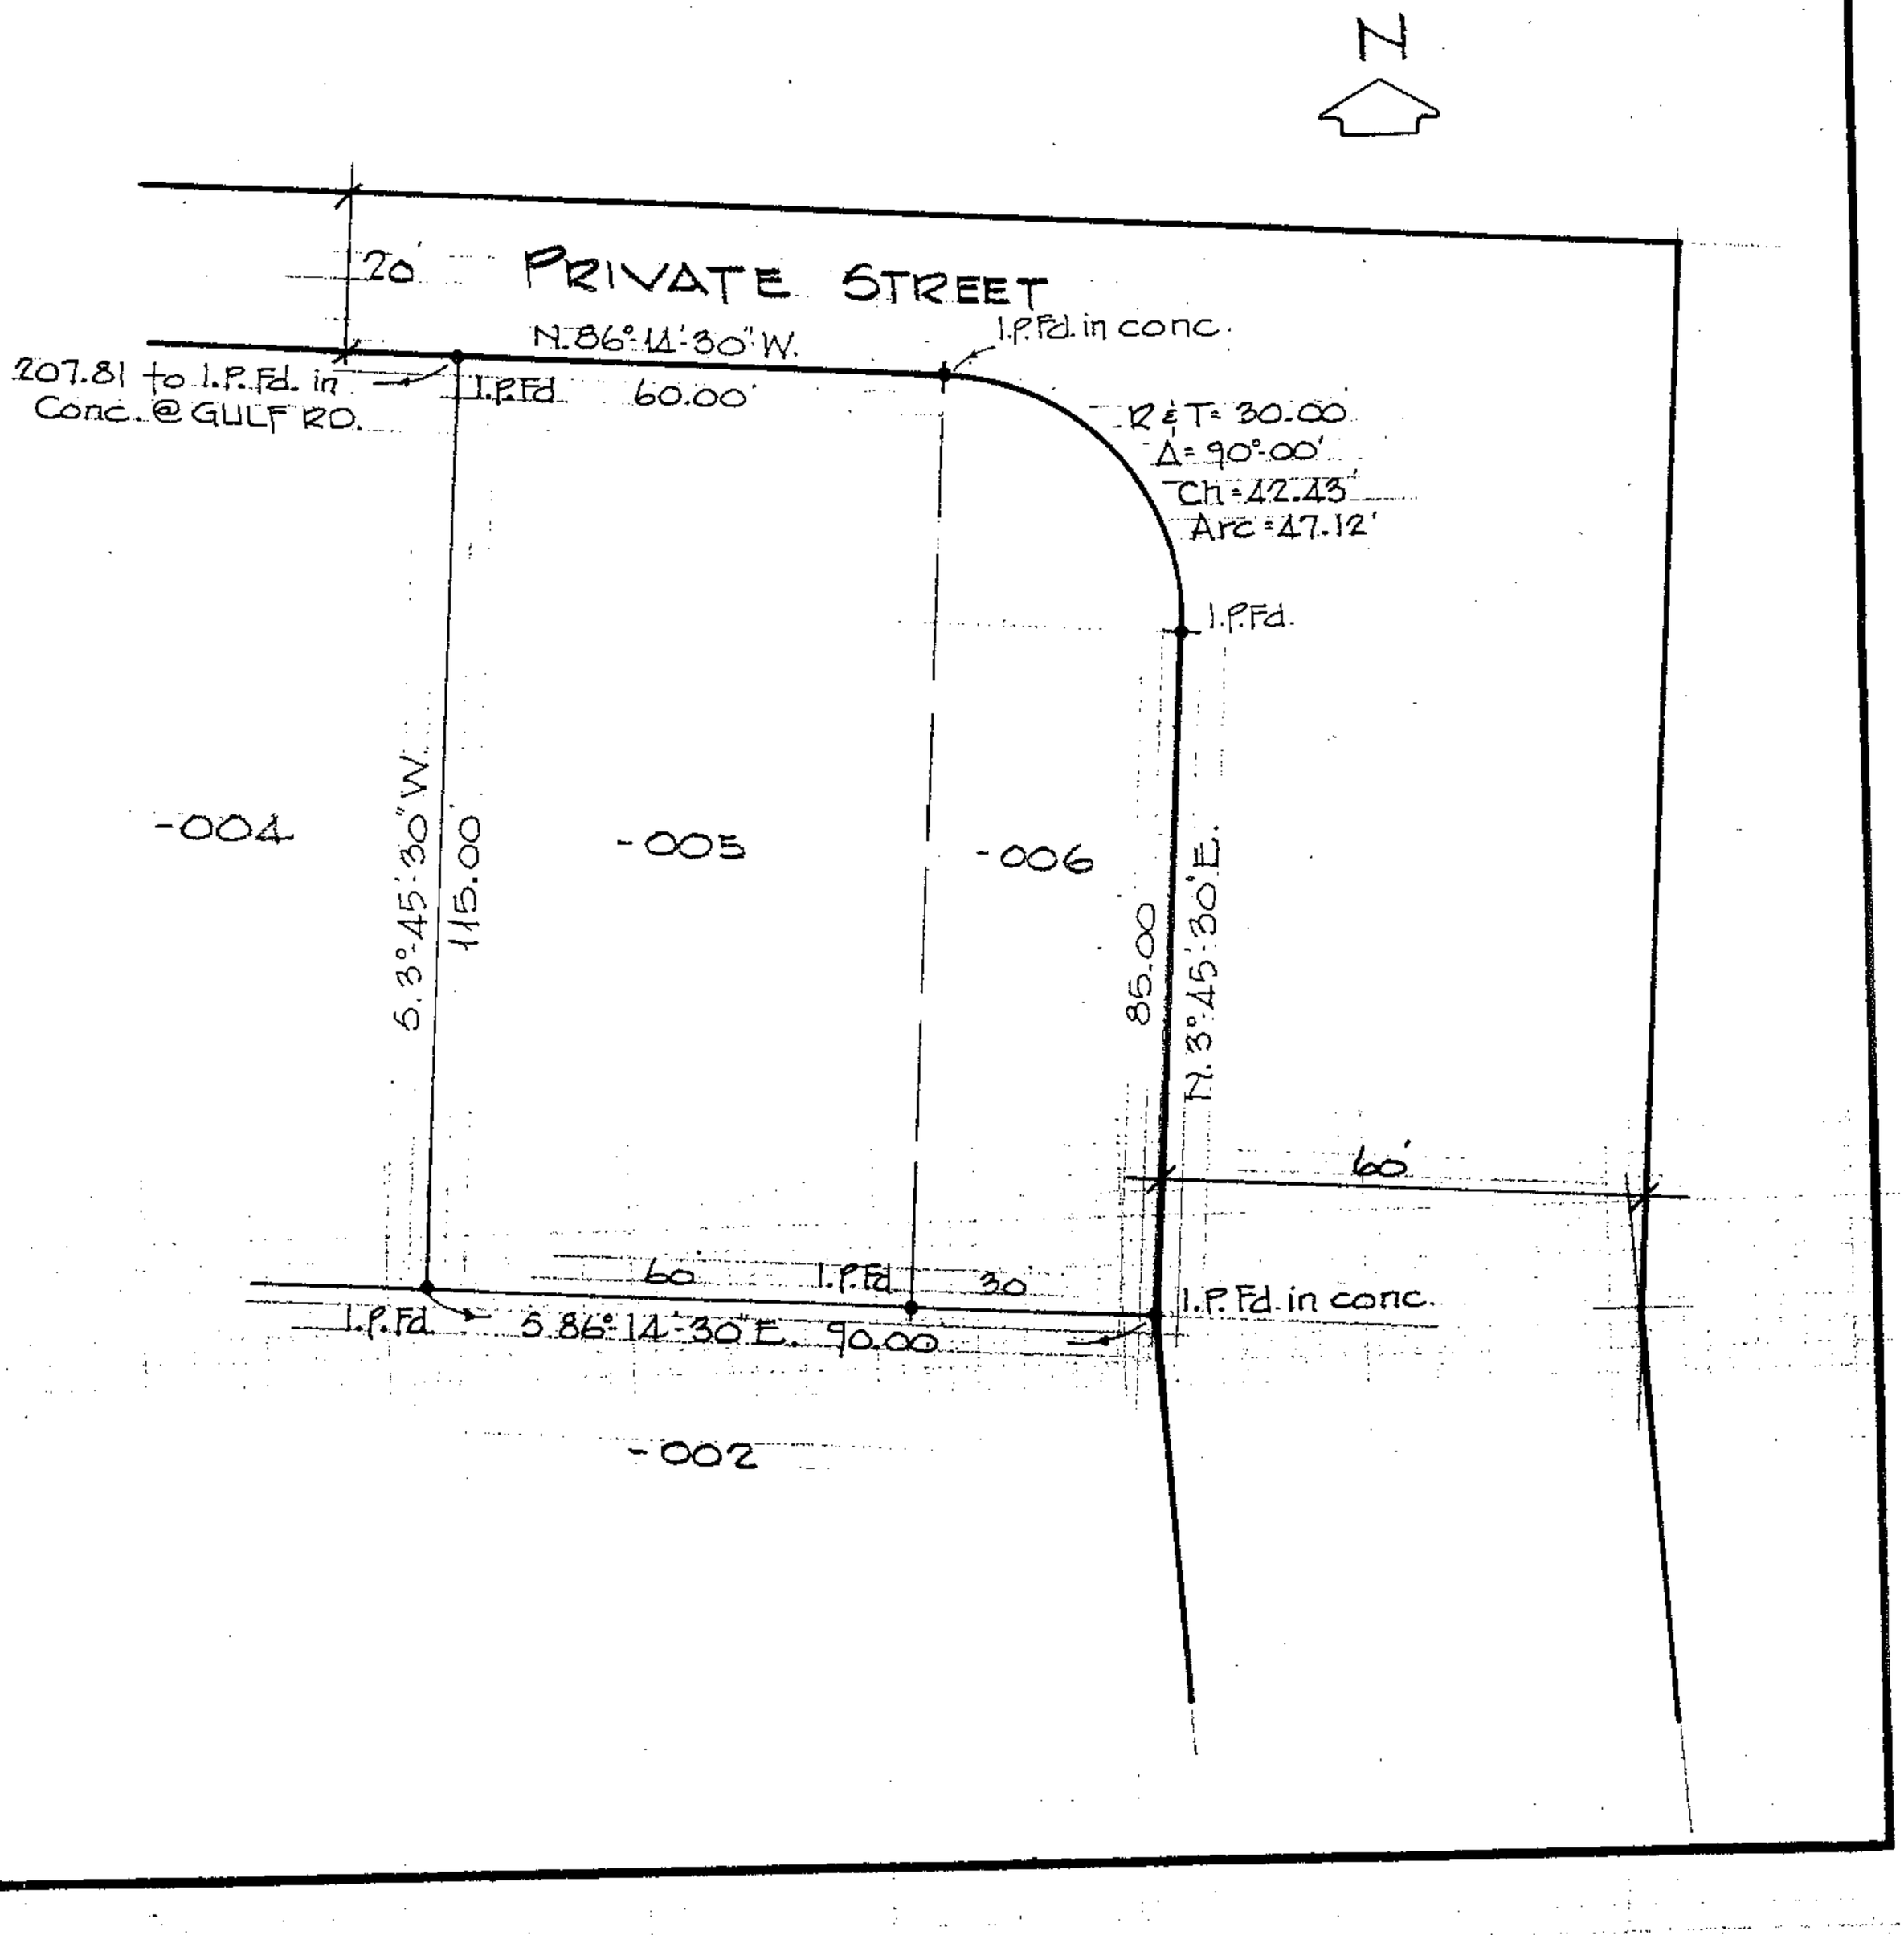
| | | |
|---|---|---|
| Orig. Lot 174 | City of ELYRIA | Date OCT. '90 Scale 1"=30' |
| Orig. Sec | Village of | Dwn. by R.G.S. Chkd. by K.D. |
| Tract EAST of RIVER | County of LORAIN | Job No. 90-1975 F.B. |
| Township of ELYRIA | State of OHIO | Printed |