#44917

10-00-004-143-002

LAUNDON · SIMON · CAHL & ASSOC. INC.
CONSULTING ENGINEERS & SURVEYORS
219 COURT ST. ELYRIA, OHIO 44035

SURVEY FOR: 10-00-004-H

ANNA M. WILSON
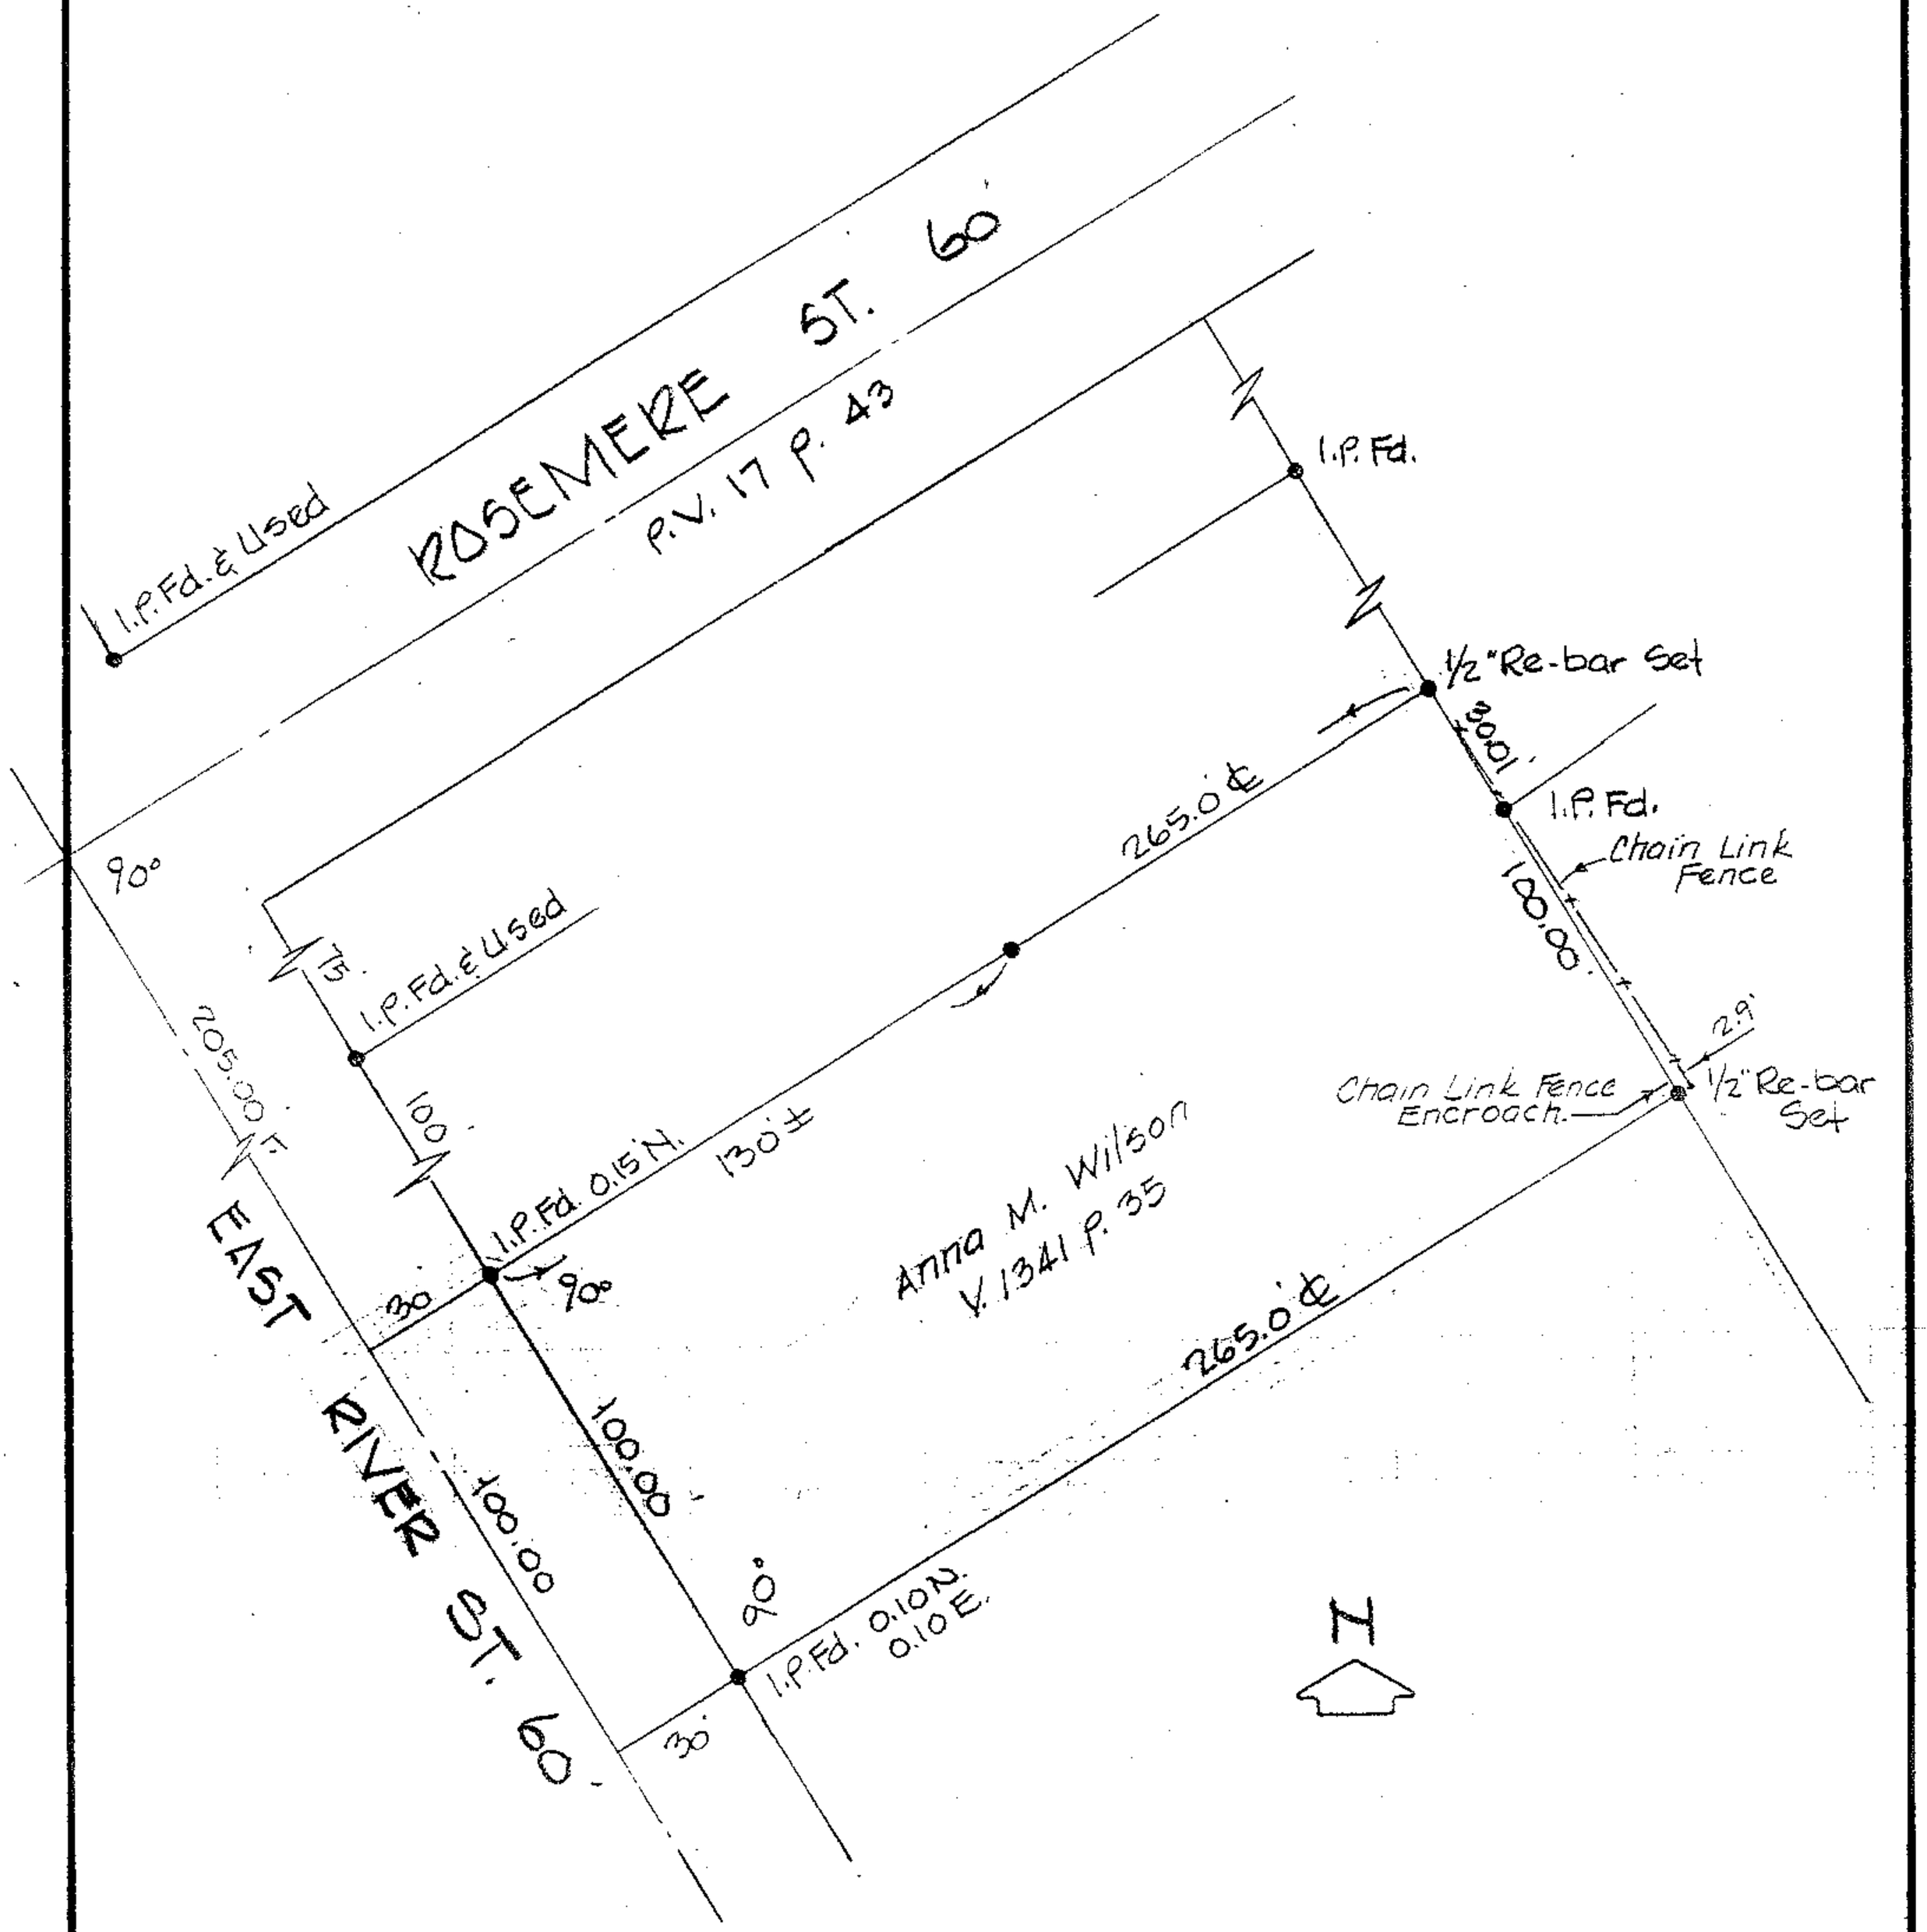
Orig. Lot	City of	Date SEPT. '90 Scale 1"=50'
Orig. Sec. 4	Village of	Dwn. by R.G.S. Chkd. by
Tract	County of LORAIN	Job No. 90-1966 F.B.
Township of CARLISLE	State of OHIO	Printed