44927

07-00-048-000-023
7-E

LAUNDON . SIMON . CAHL & ASSOC. INC.
CONSULTING ENGINEERS & SURVEYORS
219 COURT ST. ELYRIA, OHIO 44035

SURVEY for HUNTER REALTY
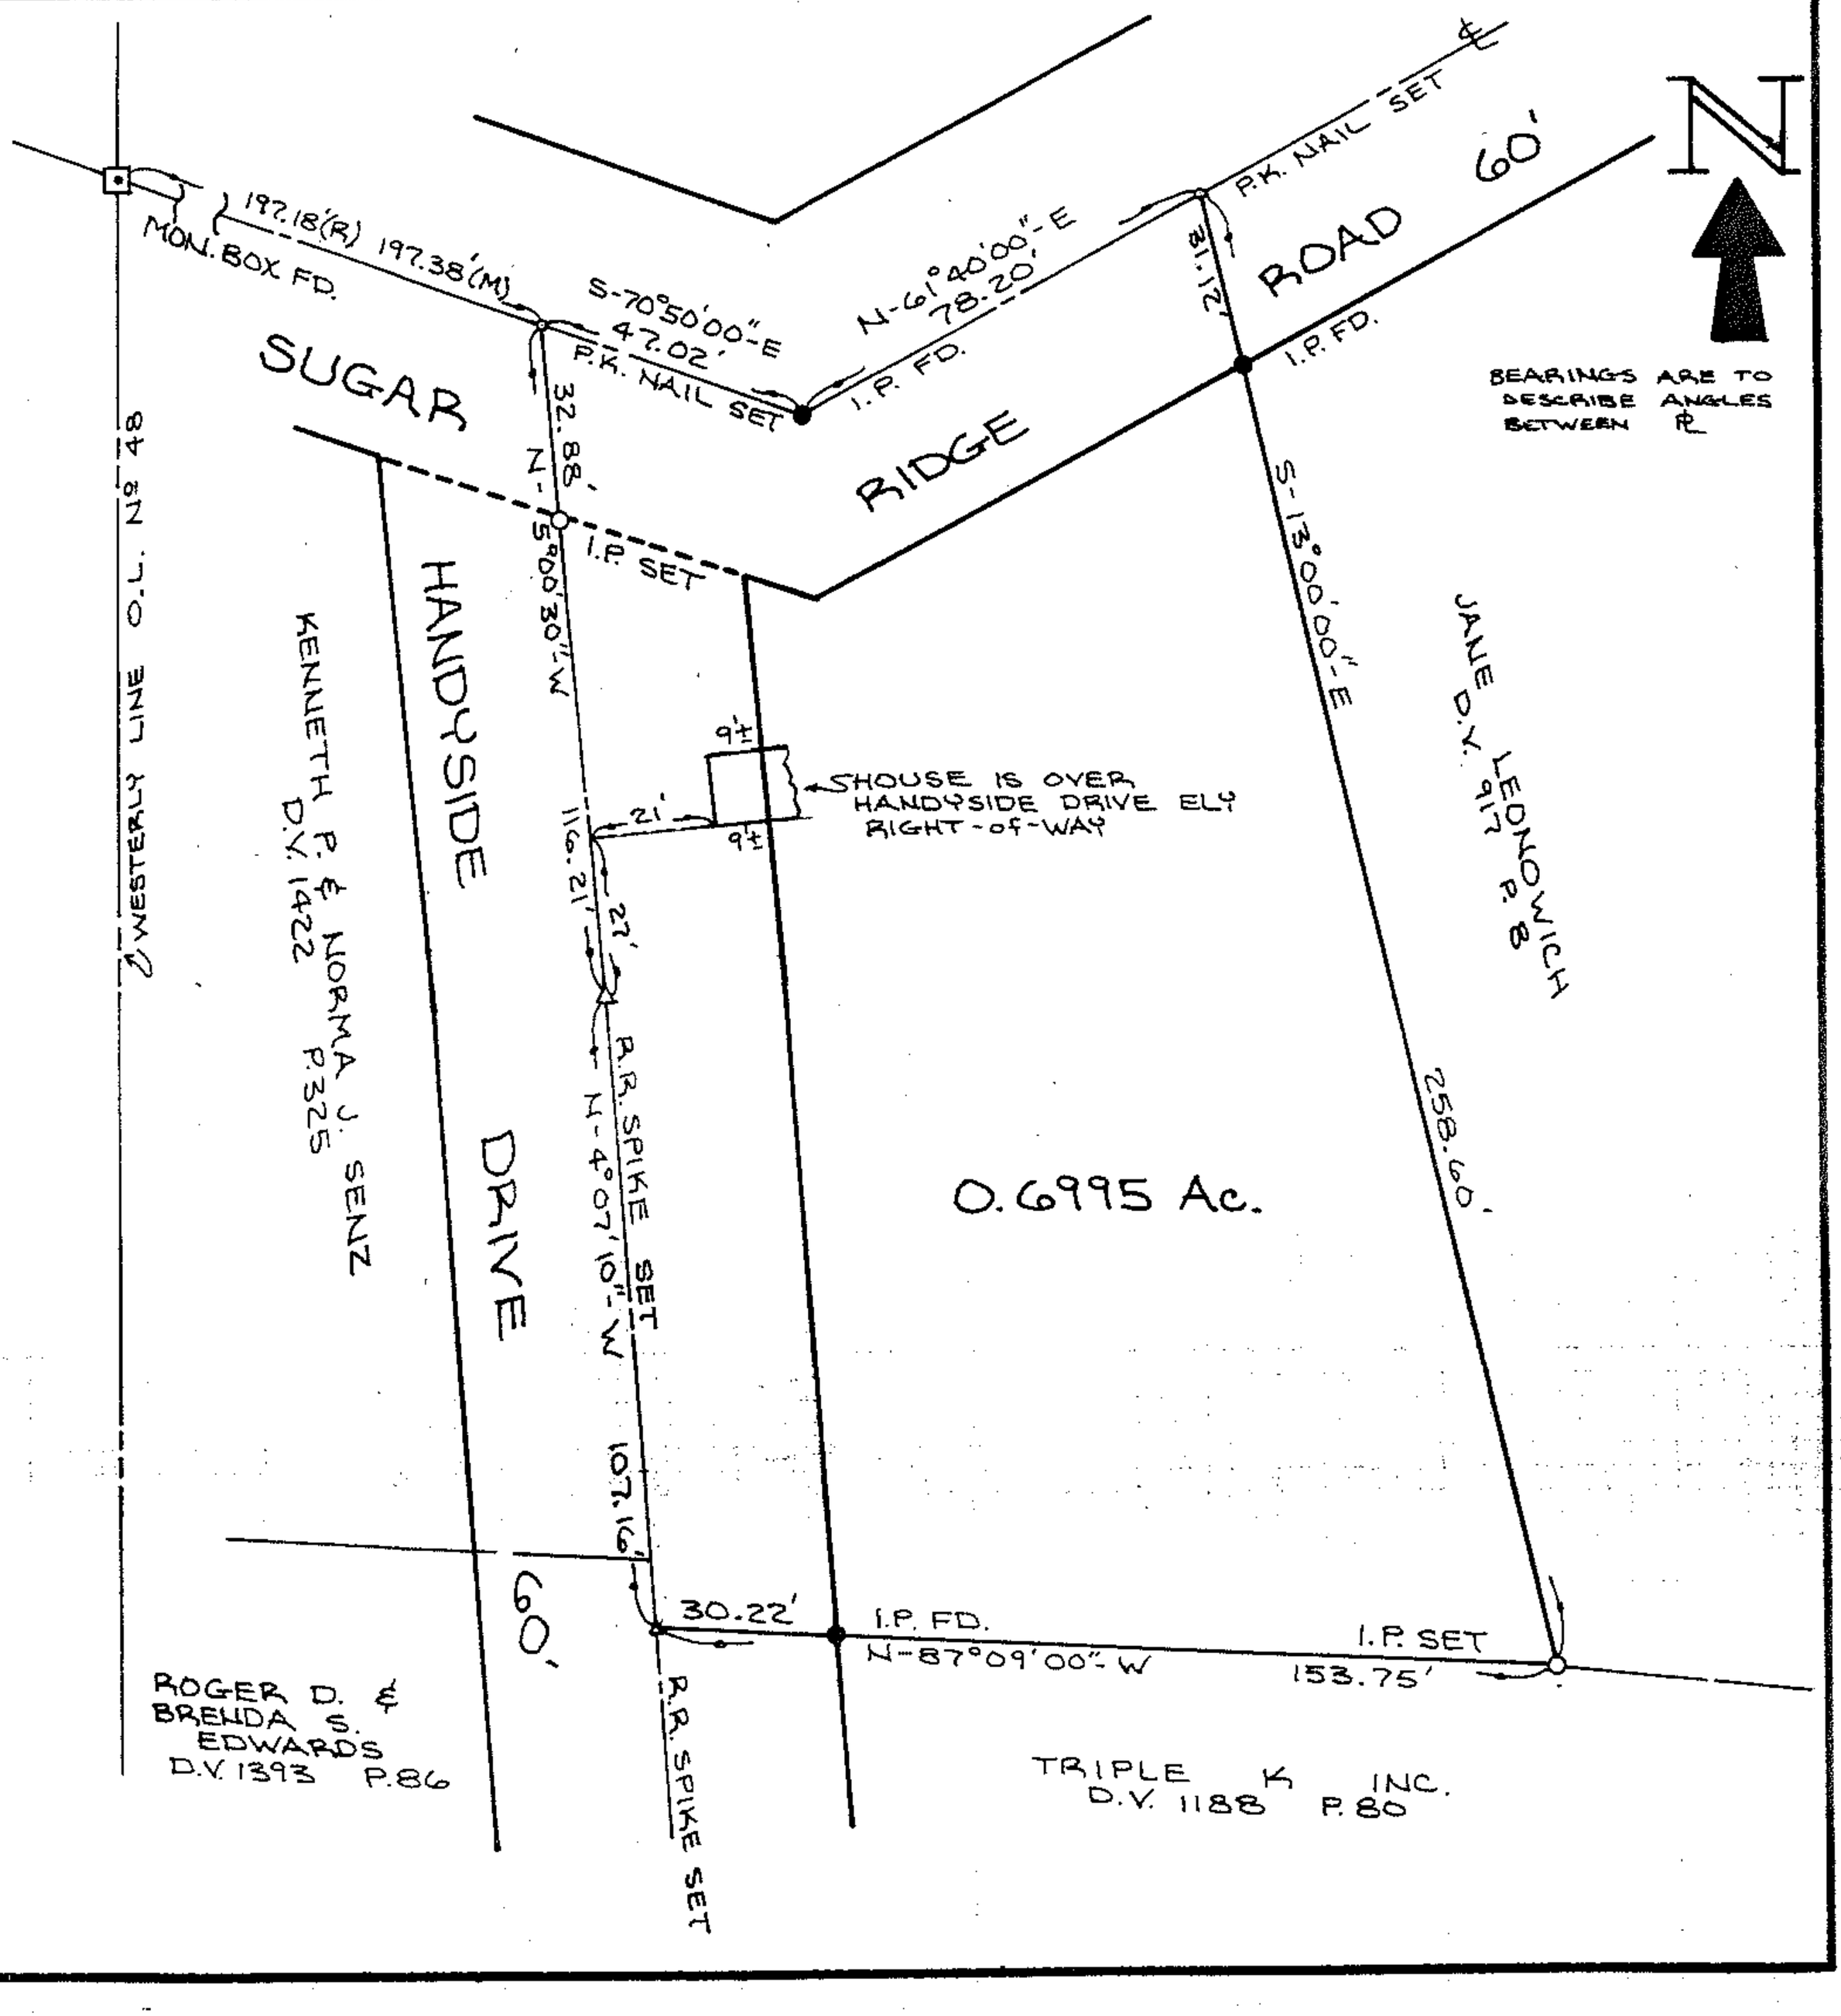
Orig. Lot 48	City of NORTH RIDGEVILLE	Date 9-12-89 Scale 1"= 40'
Orig. Sec	Village of	Dwn. by K.R.B. Chkd. by
Tract	County of LORAIN	Job No. 89-1859 F.B.
Township of RIDGEVILLE	State of OHIO	Printed