#44942 12-00-064-101-035

SURVEY FOR: 12-00-064-A

LAUNDON . SIMON . CAHL & ASSOC. INC.
CONSULTING ENGINEERS & SURVEYORS
219 COURT ST. ELYRIA, OHIO 44035

GREGORY A. & MAURA KRYSA
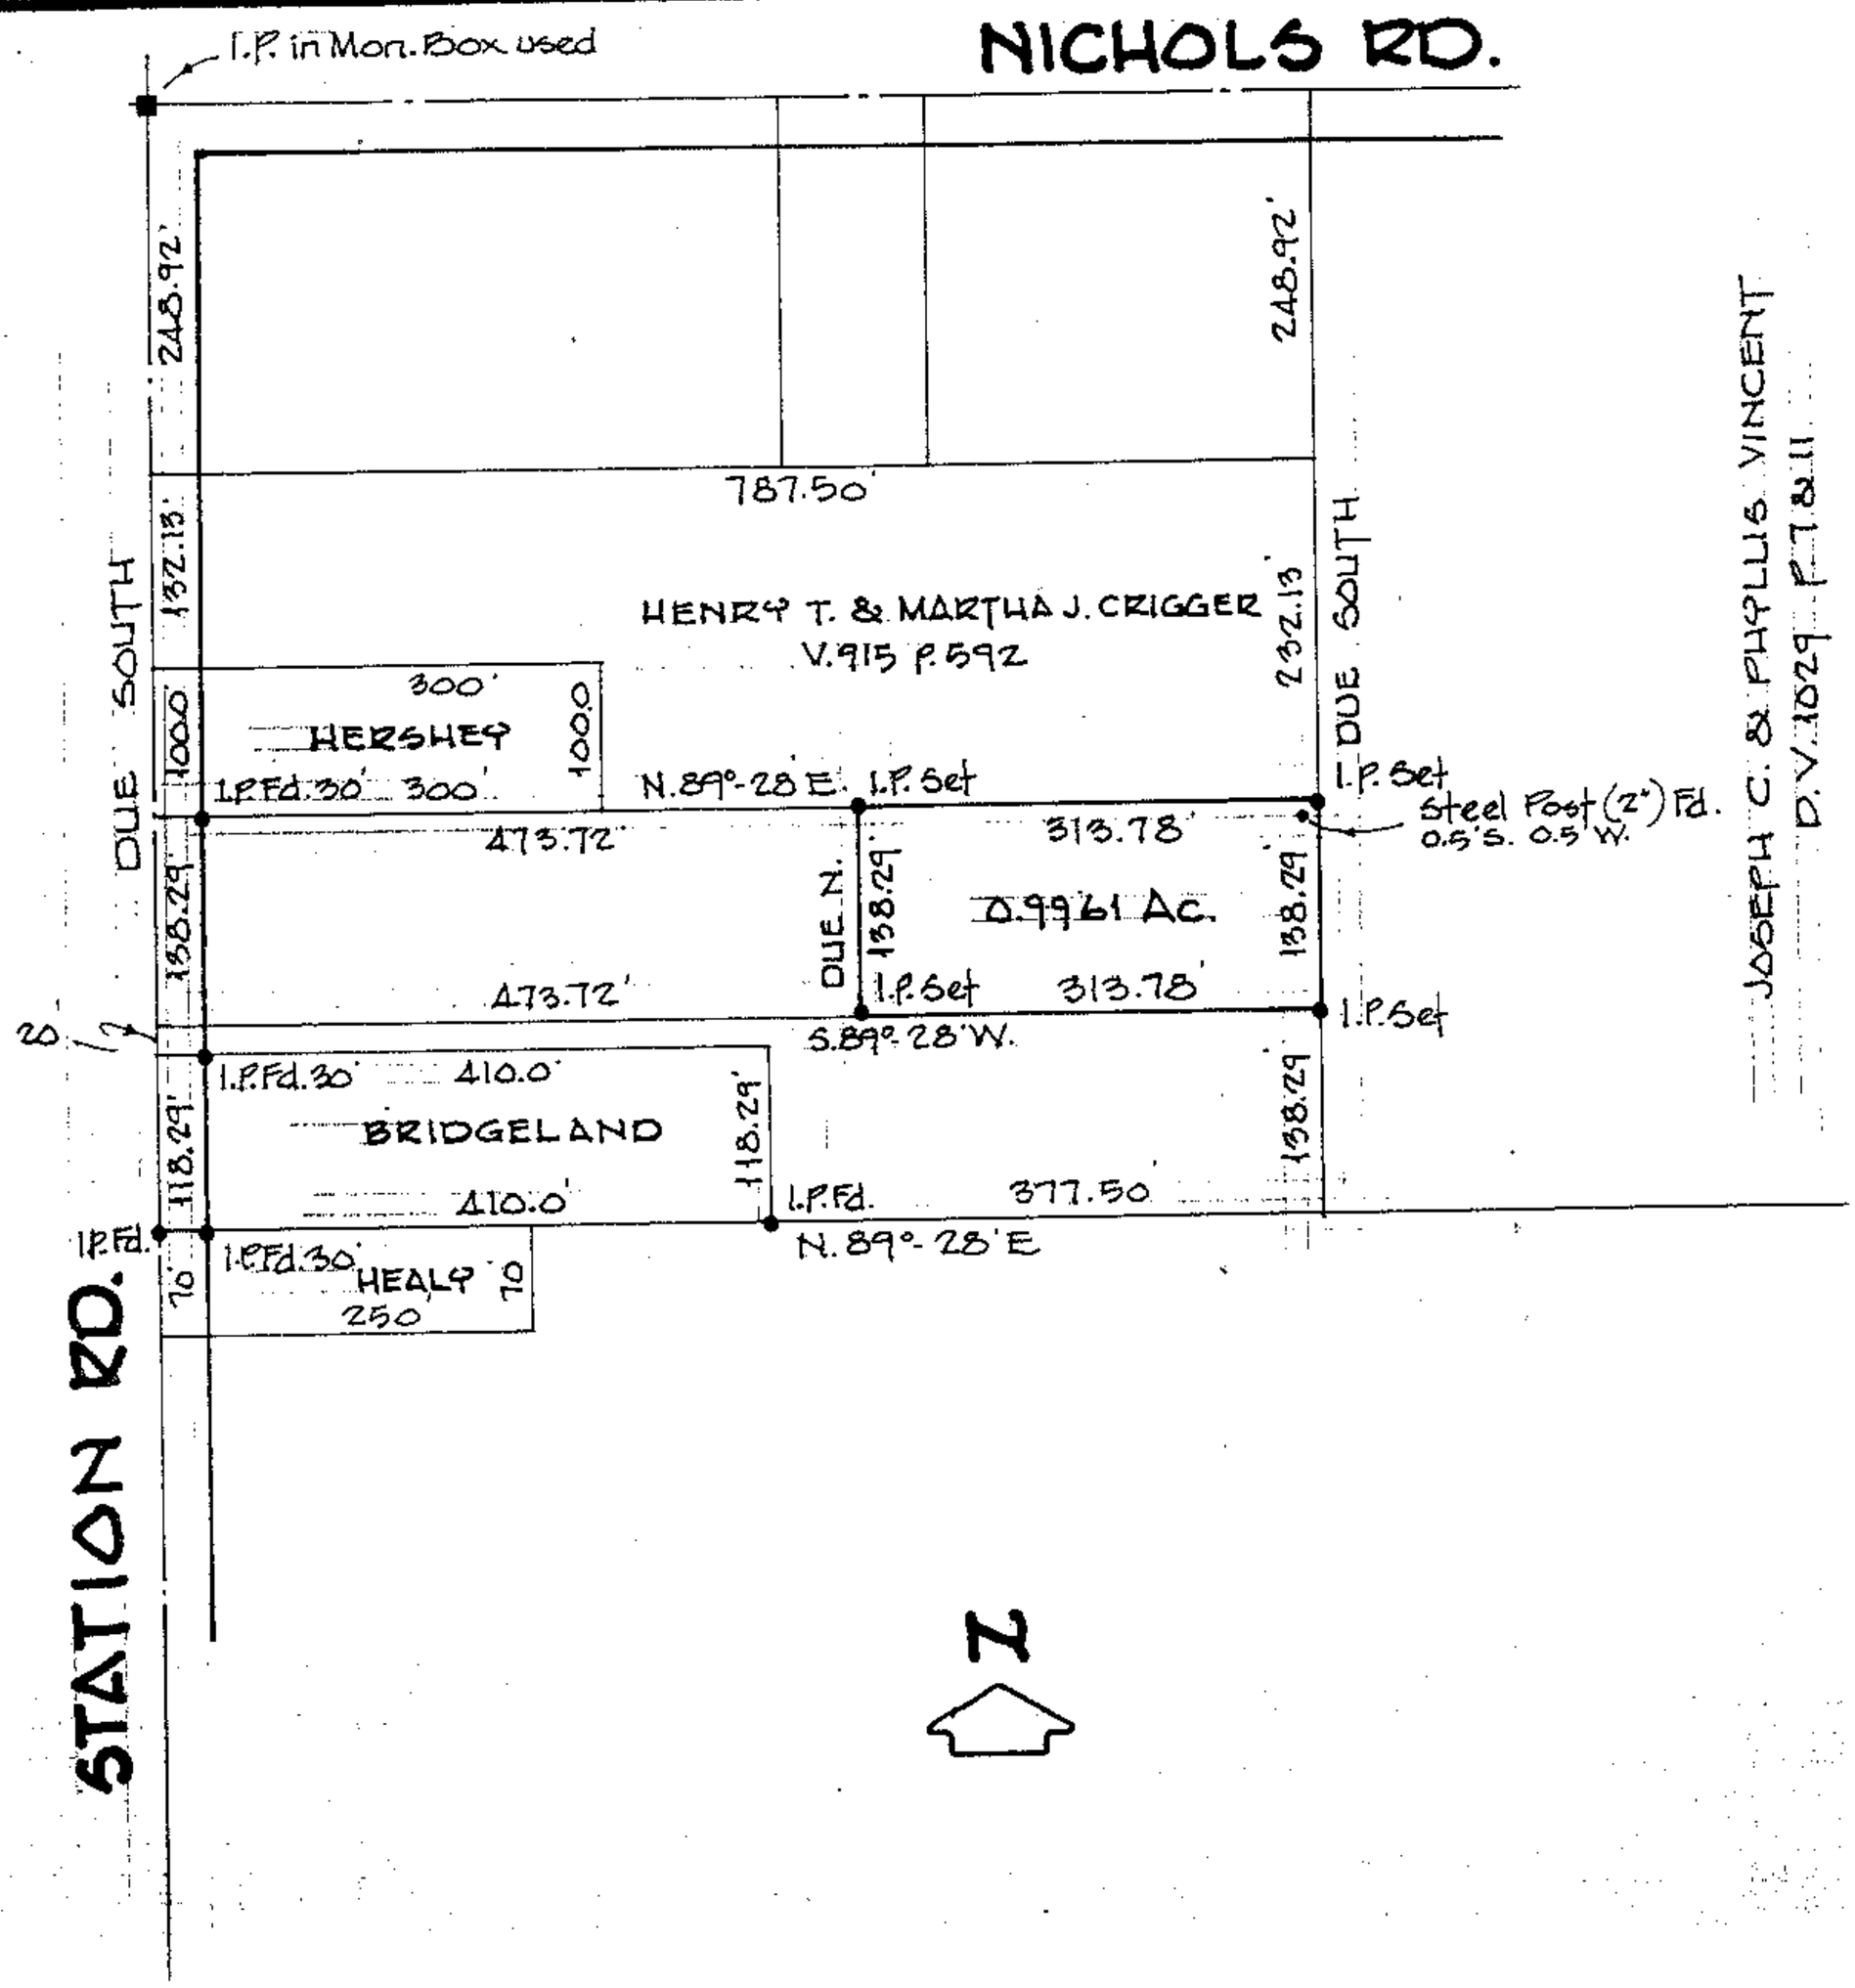
Orig. Lot 64	City of	Date SEPT. 15, '88 Scale 1"=200'
Orig. Sec	Village of	Dwn. by R.G.S. Chkd. by C.J.
Tract	County of LORAIN	Job No. 88-1741 F.B.
Township of COLUMBIA	State of OHIO	Printed