#44953

06-26-022-101-009

6-138

LAUNDON . SIMON . CAHL & ASSOC. INC.
CONSULTING ENGINEERS & SURVEYORS
219 COURT ST. ELYRIA, OHIO 44035

SURVEY FOR:

JOHN S. & CATHERINE HAWLEY

OF PT. of S/L 8 IN R.H. PENFIELD'S ADD'N. P.V. 1 P. 41

Orig. Lot 22	City of ELYRIA	Date MAY 10, '88 Scale 1"= 30'
Orig. Sec	Village of	Dwn. by R.G.S. Chkd. by C.J.
Tract BETWEEN THE RIVERS	County of LORAIN	Job No. 88-1704 F.B.
Township of ELYRIA	State of OHIO	Printed

EAST 8TH ST. 66'

MIDDLE AVE. 99'

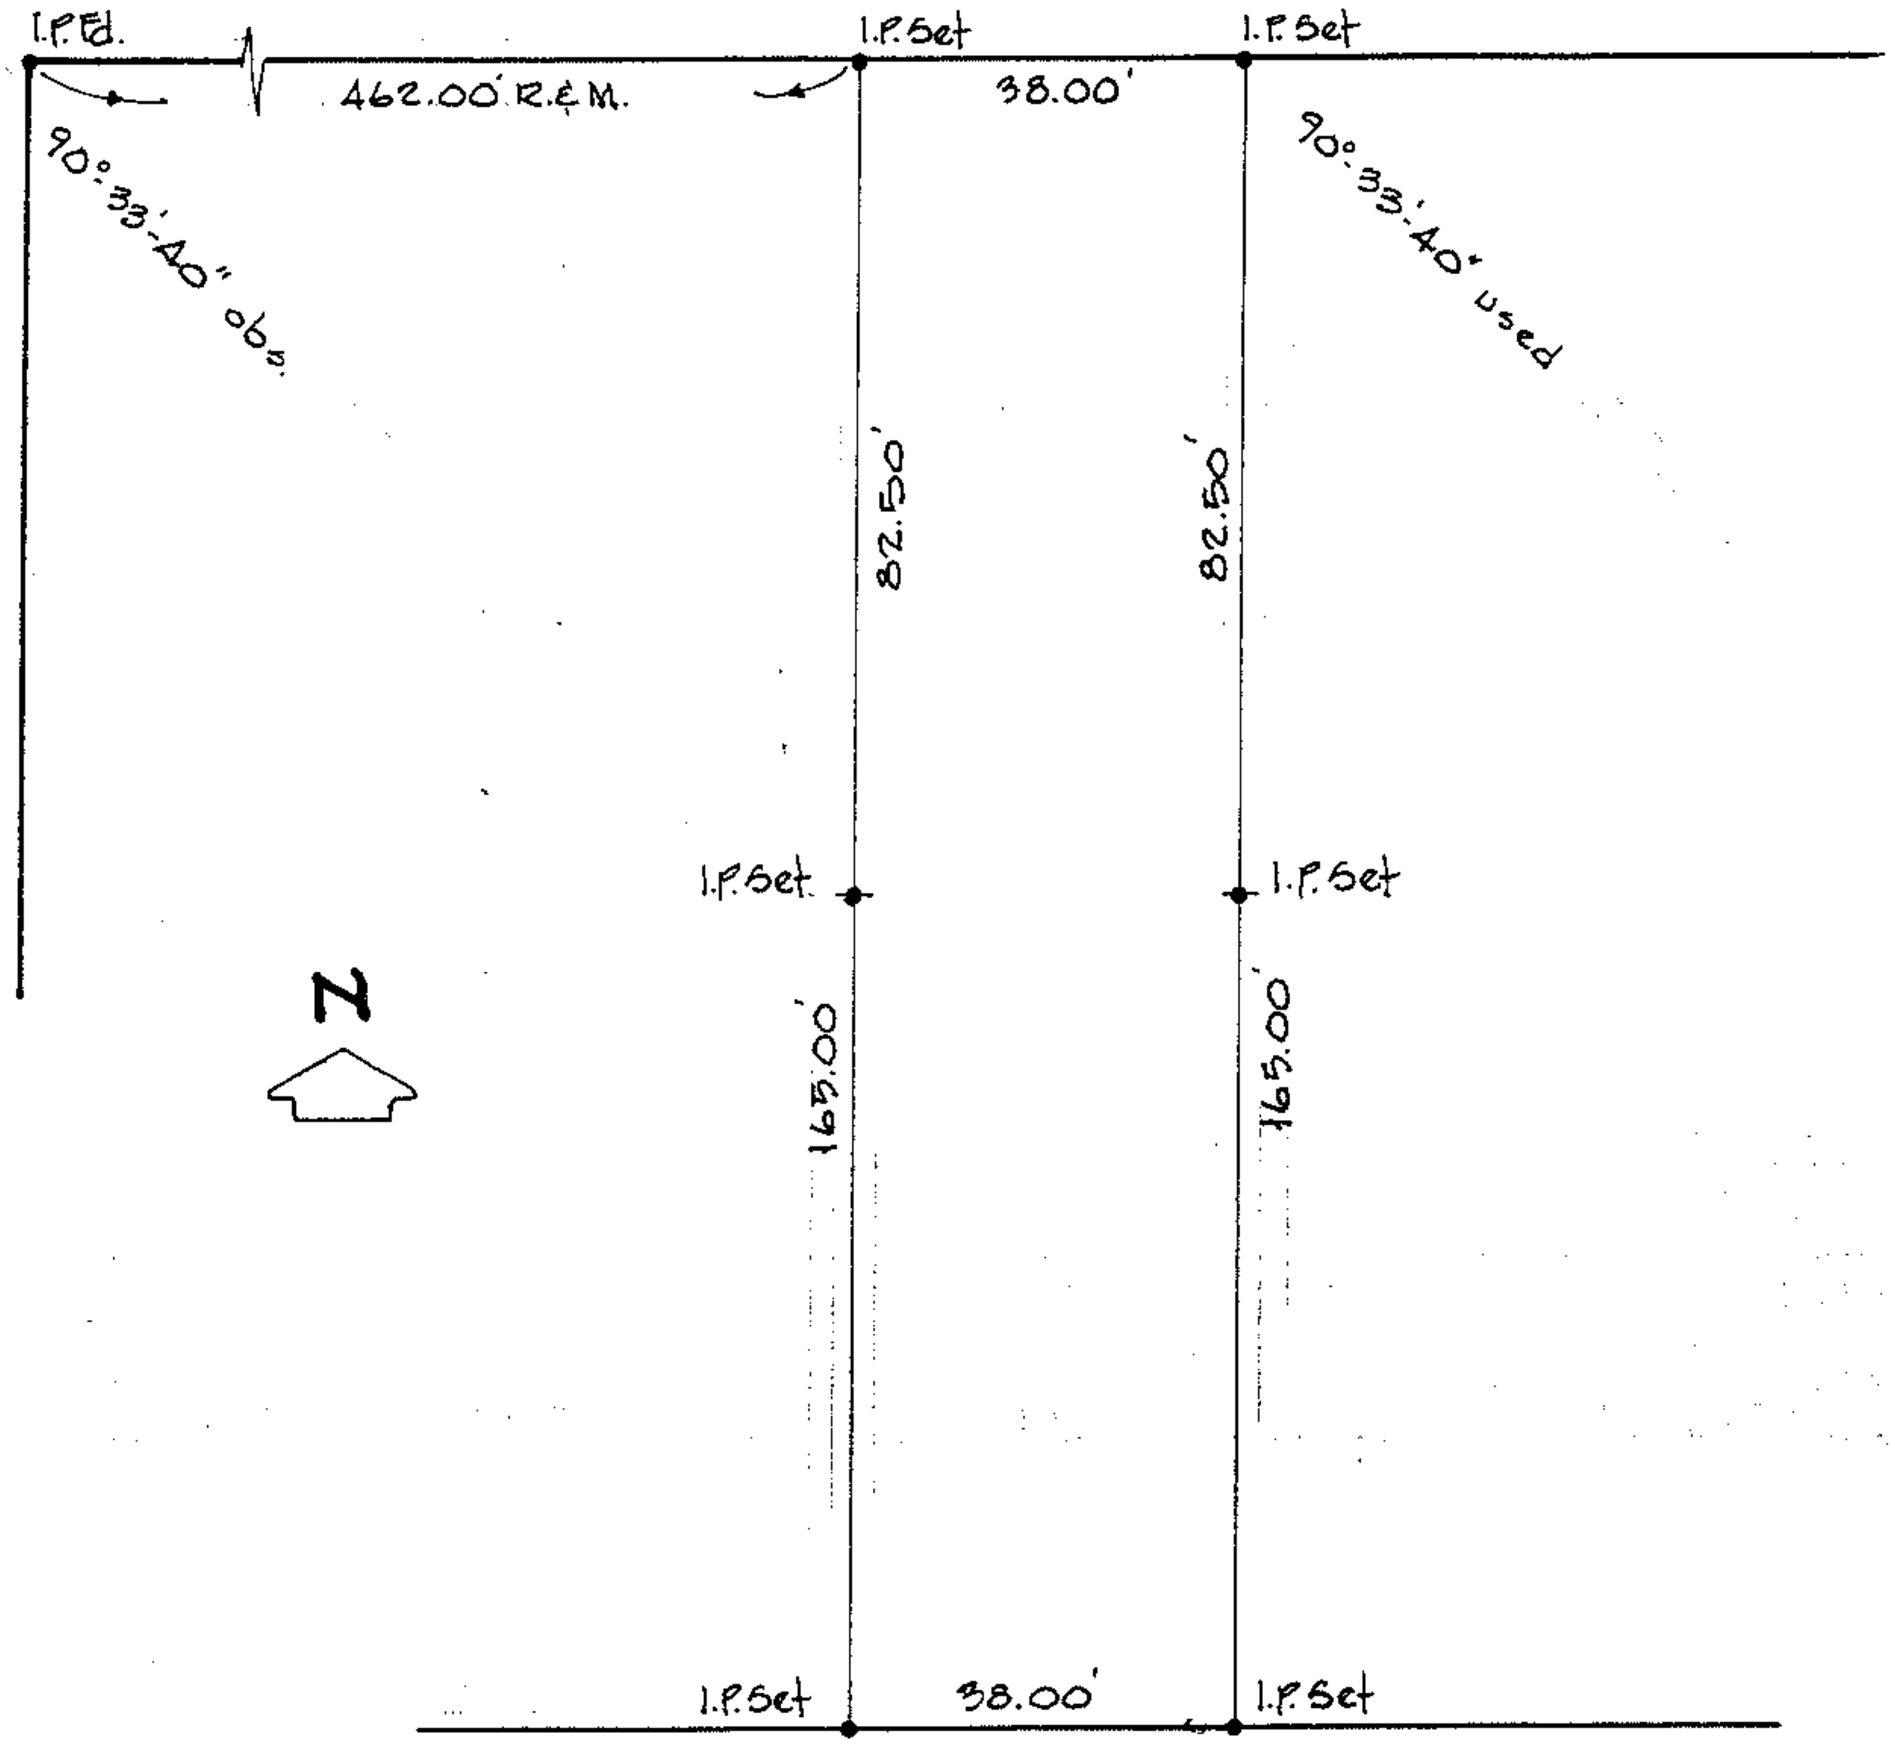

8TH PLACE 33'