#44957

11-E North
10-00-016-D

10-00-016-000-040
11-00-097-000-017

LAUNDON . SIMON . CAHL & ASSOC. INC.
CONSULTING ENGINEERS & SURVEYORS
219 COURT ST. ELYRIA, OHIO 44035

SURVEY FOR:

RAYMOND K. & EDITH J. ECHARD
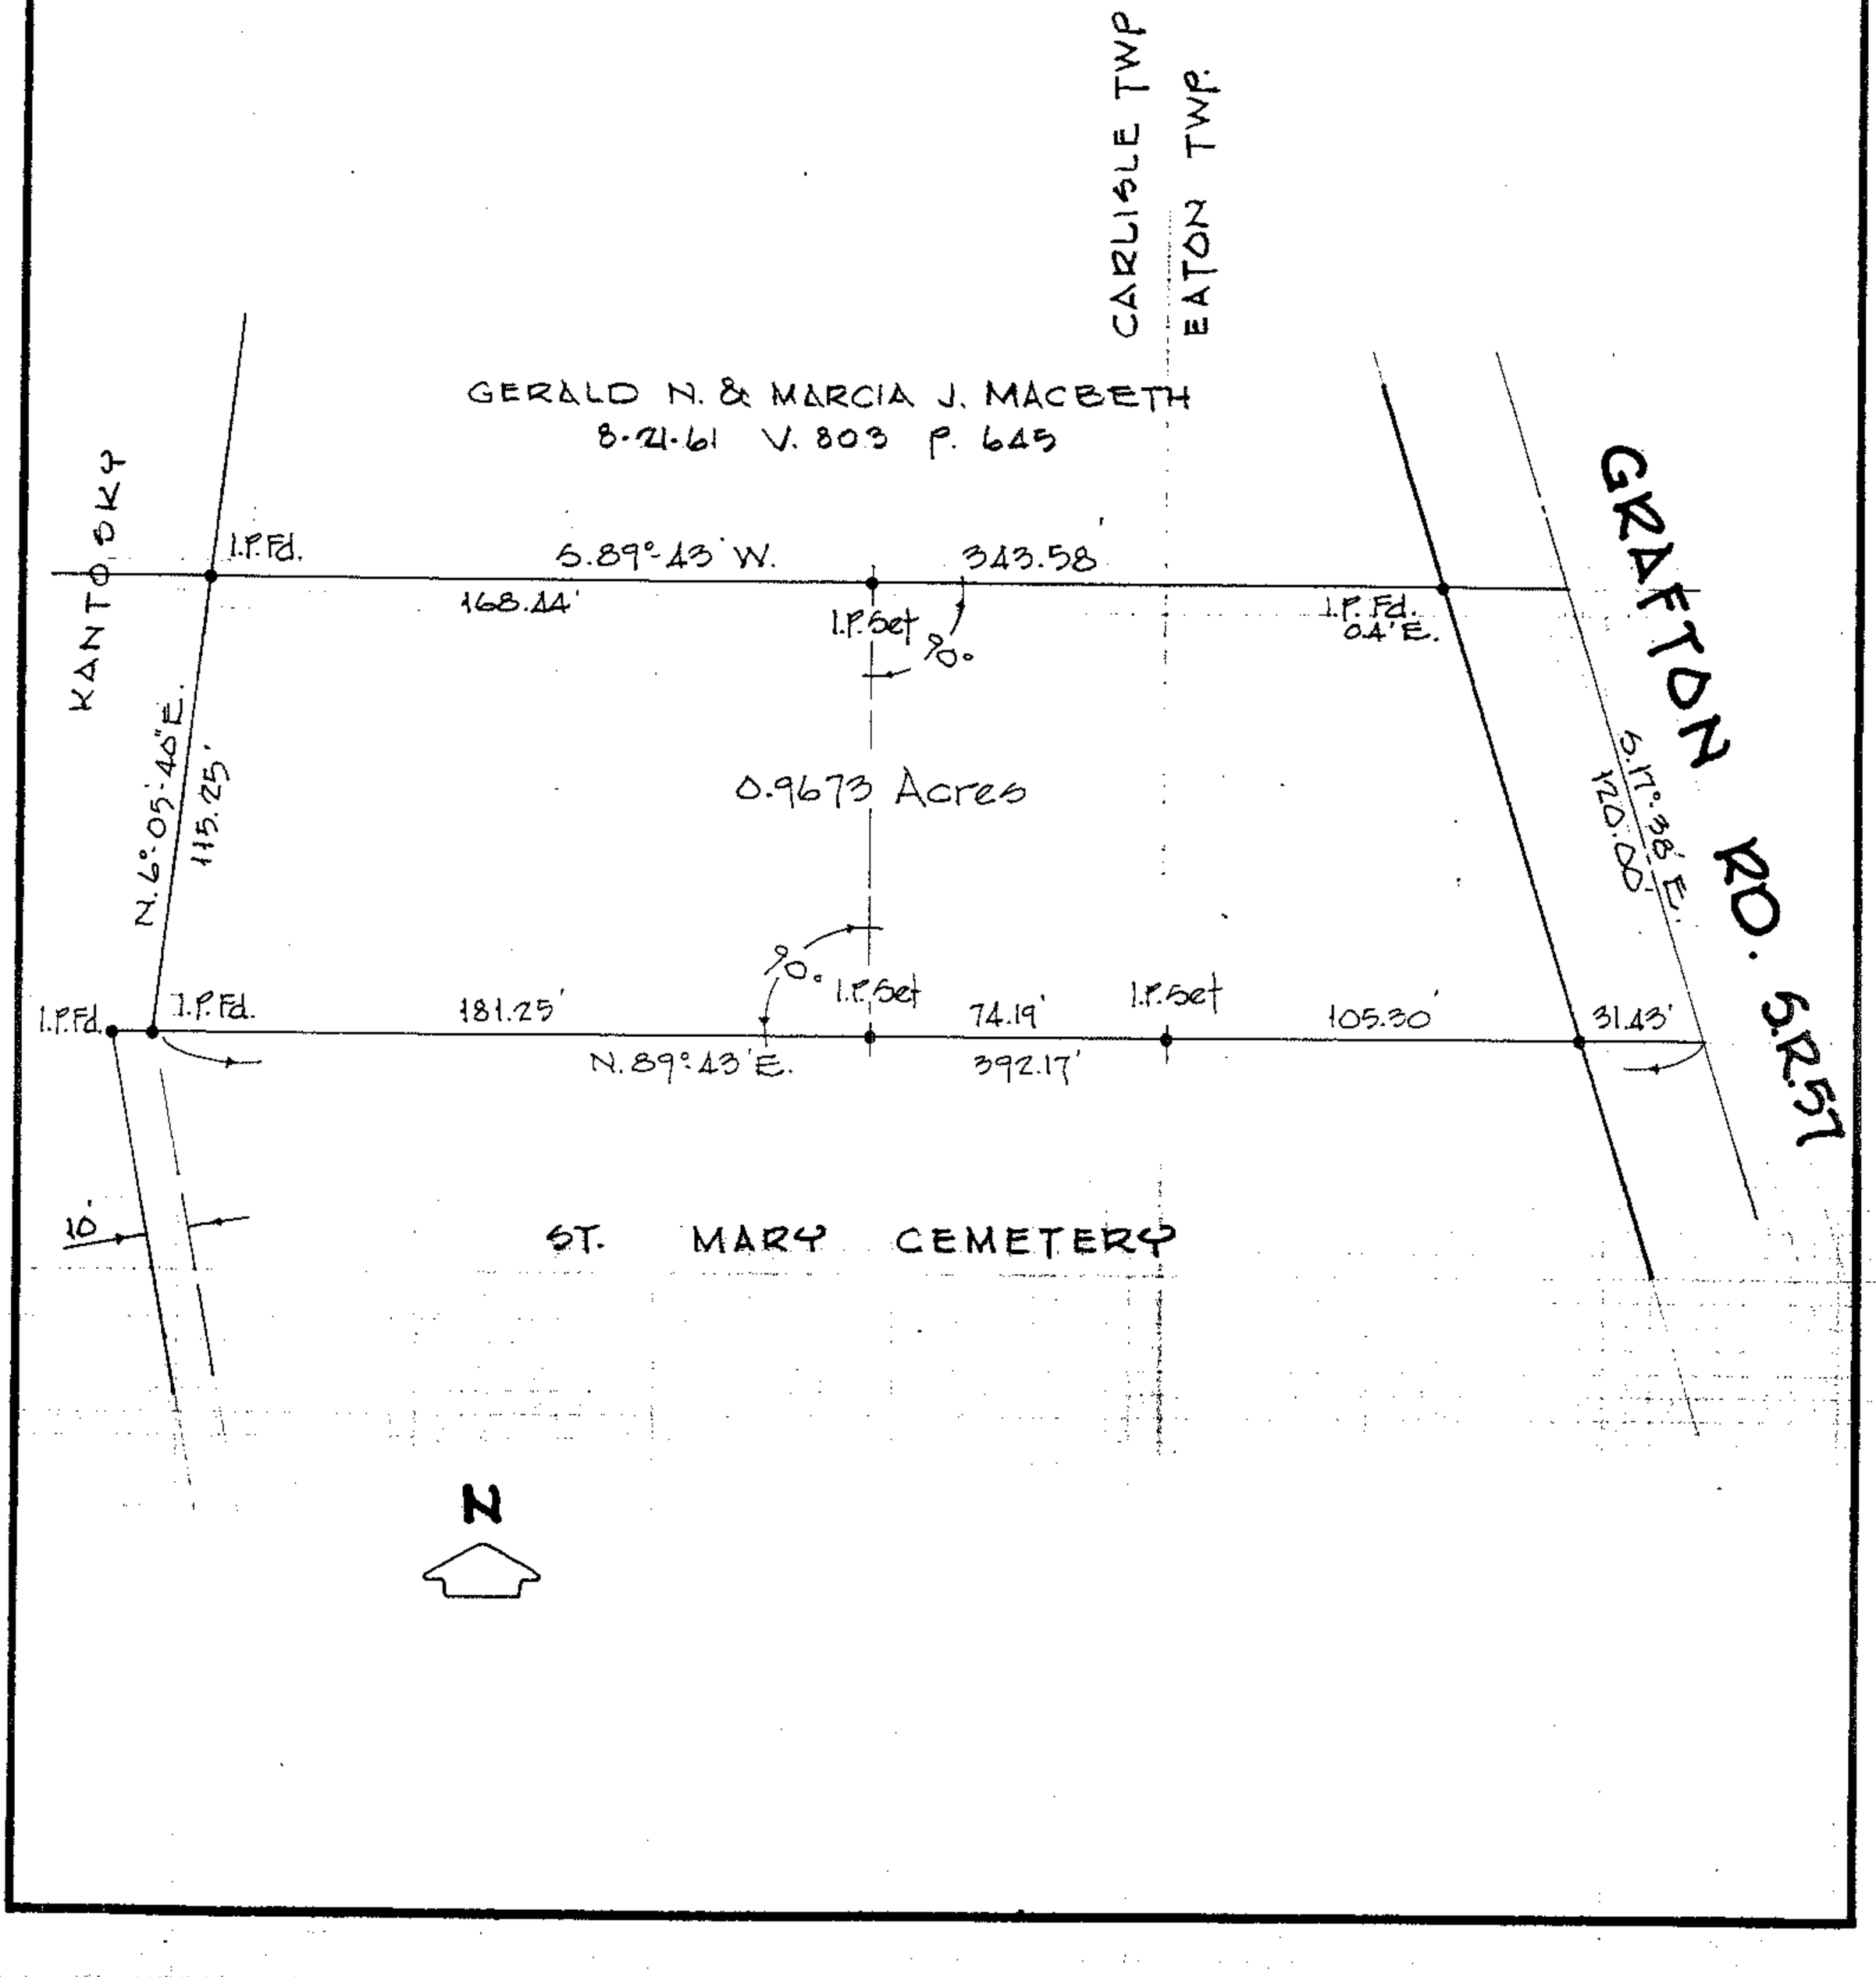
Orig. Lot 97	City of	Date OCT. 2, '87 Scale 1"=60'
Orig. Sec 16	Village of	Dwn. by R.G.S. Chkd. by C.J.
Tract	County of LORAIN	Job No. 87-1648 F.B.
Township of CARLISLE & EATON	State of OHIO	Printed