#44964

10-00-006-126-001
10-00-006-G

LAUNDON · SIMON · CAHL & ASSOC. INC.
CONSULTING ENGINEERS & SURVEYORS
219 COURT ST. ELYRIA, OHIO 44035

SURVEY FOR:

JAMES R. & SHONA L. COUCH
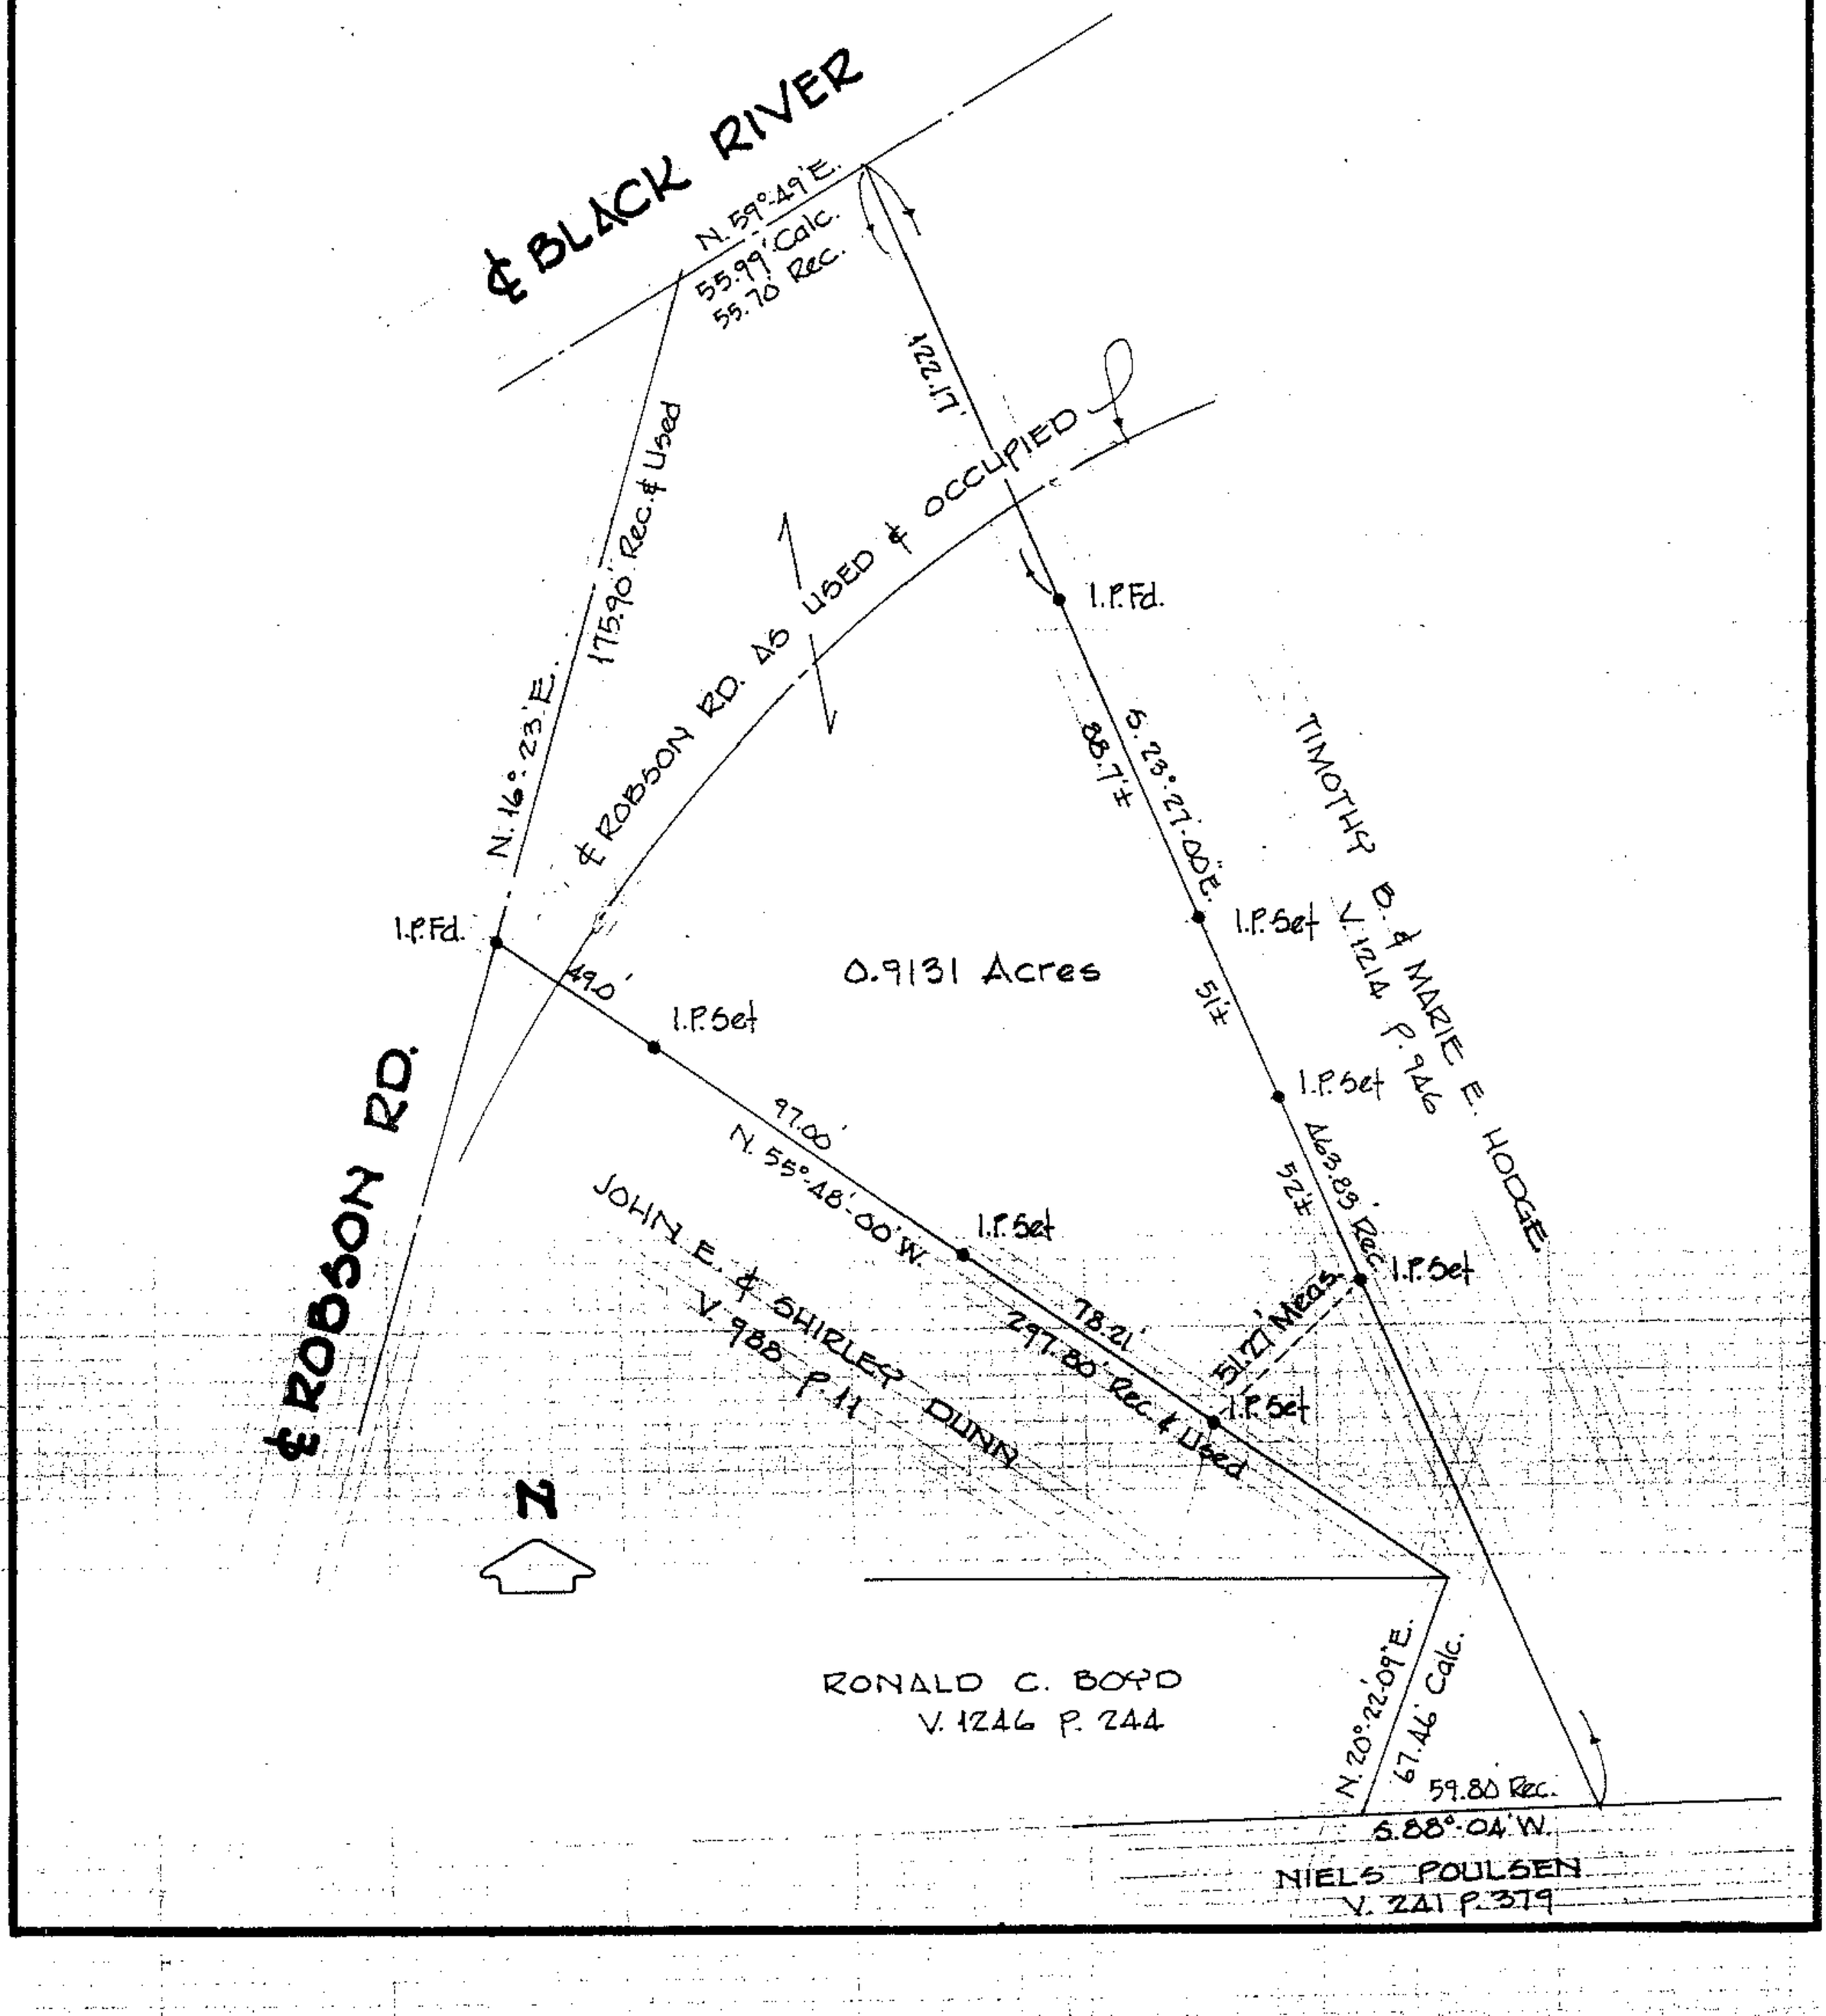
Orig. Lot	City of	Date MAY 1987 Scale 1"=60'
Orig. Sec 6	Village of	Dwn. by R.G.S. Chkd. by C.J.
Tract	County of LORAIN	Job No. 87-1600 F.B.
Township of CARLISLE	State of OHIO	Printed