


IDENTIFICATION SERVICE

BRIEF PROPERTY DESCRIPTION: 1.951 ACRE PARCEL, Q.L. 3

as recorded in Volume _____ Page _____ of Plats
 CITY OF AMHERST
AMHERST TOWNSHIP
LORAIN COUNTY, OHIO

MADE FOR AND AT THE INSTANCE OF:
MIDLAND TITLE SECURITY
P.O. BOX 426
ELYRIA, OHIO

AND _____

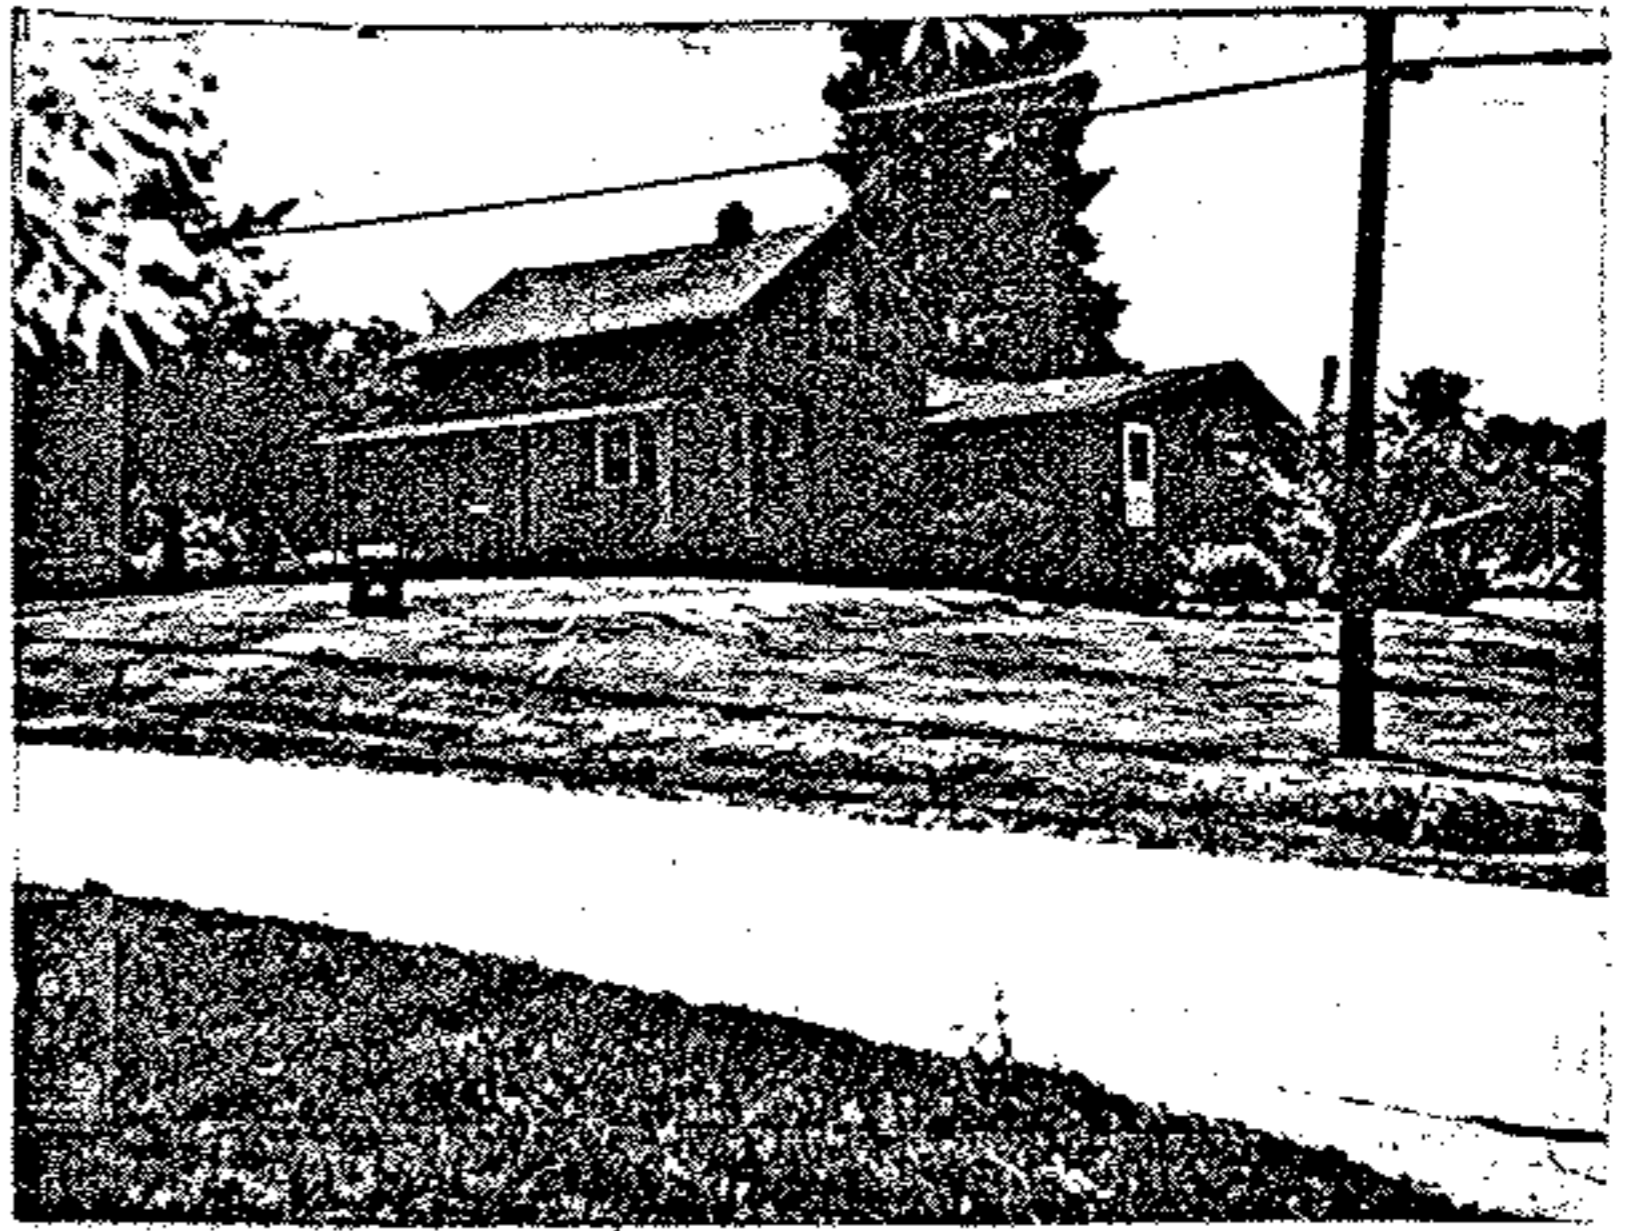

THE ATTACHED IS A PHOTOGRAPH OF THE PREMISES KNOWN AS
258 NORTH LAKE STREET
AMHERST, OHIO

YOUR ORDER NUMBER VERBAL


- (a) — THE PLAT SHOWN HEREON CORRECTLY INDICATES THE BOUNDARIES OF SAID PREMISES.
 - (b) — THE BUILDINGS SHOWN ON SAID PLAT LIE ENTIRELY DO NOT LIE ENTIRELY WITHIN BOUNDARIES.
 - (c) — THERE ARE NO ENCROACHMENTS OF ADJOINING BUILDINGS, IMPROVEMENTS OR APPARENT EASEMENTS ON SAID PROPERTY.
- THERE IS AN APPARENT ENCROACHMENT ONTO SAID PROPERTY
 - THERE IS AN APPARENT ENCROACHMENT FROM SAID PROPERTY
 - THERE IS AN APPARENT UTILITY EASEMENT
 - THERE APPEARS TO BE A COMMON DRIVEWAY

THE FOLLOWING INFORMATION was obtained by personal inquiry and inspection on JULY 07, 1986

(1) NO MATERIAL HAS BEEN DELIVERED NOR WORK PERFORMED FOR THE IMPROVEMENT OF SAID PREMISES WITHIN THE LAST NINETY DAYS. (2)

_____ ARE IN POSSESSION OF SAID PREMISES AS OWNERS TENANTS NO ONE HOME PREMISES VACANT

Scale 1" = 100 feet

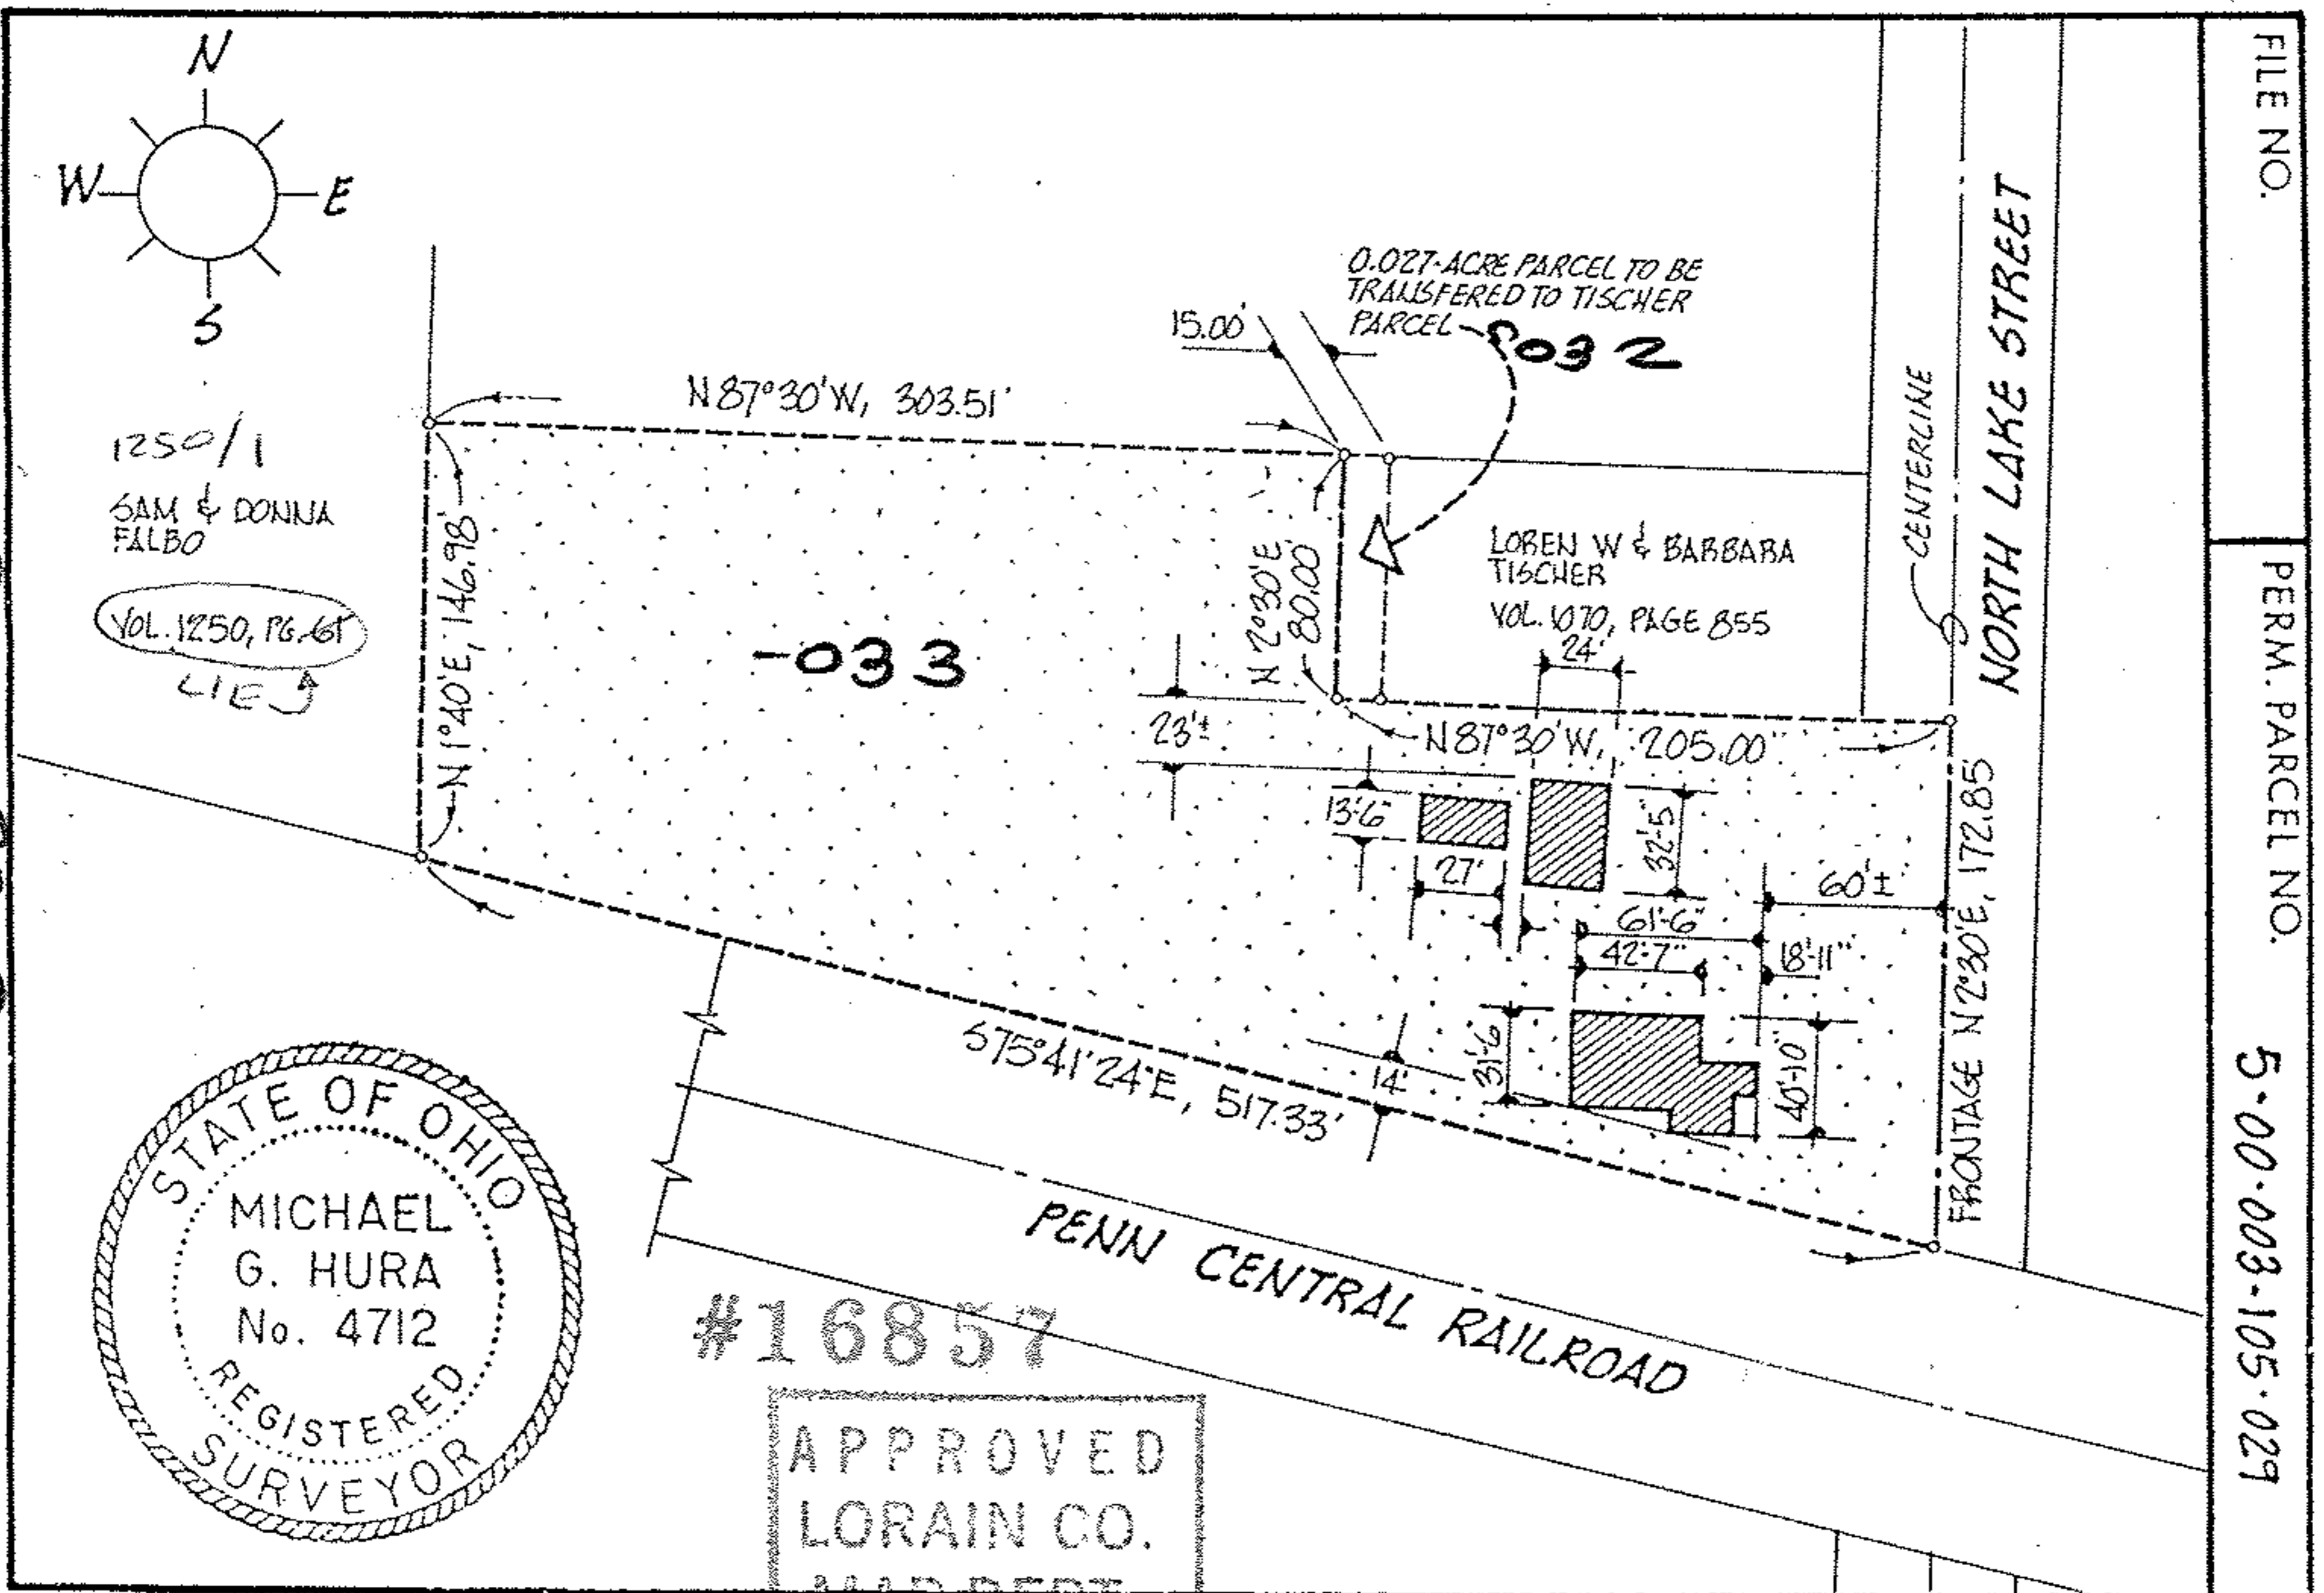

#16857

APPROVED
 LORAIN CO.
 MAP DEPT.

DATE 7-11-86

PAGE 5-00-003-10

BY T. McMan

VOID AFTER

Michael G. Hura

Michael G. Hura, Registered Surveyor

R.D. 2 #12706 MASON ROAD, VERMILION, OHIO

Telephone 965-4040

THE INFORMATION SHOWN HEREON DOES NOT CONSTITUTE THE RESULT OF A COMPLETE GROUND SURVEY

44977
05-00-003-105

16857

5-00-003-B

FILE NO. PERM. PARCEL NO. 5-00-003-105-029