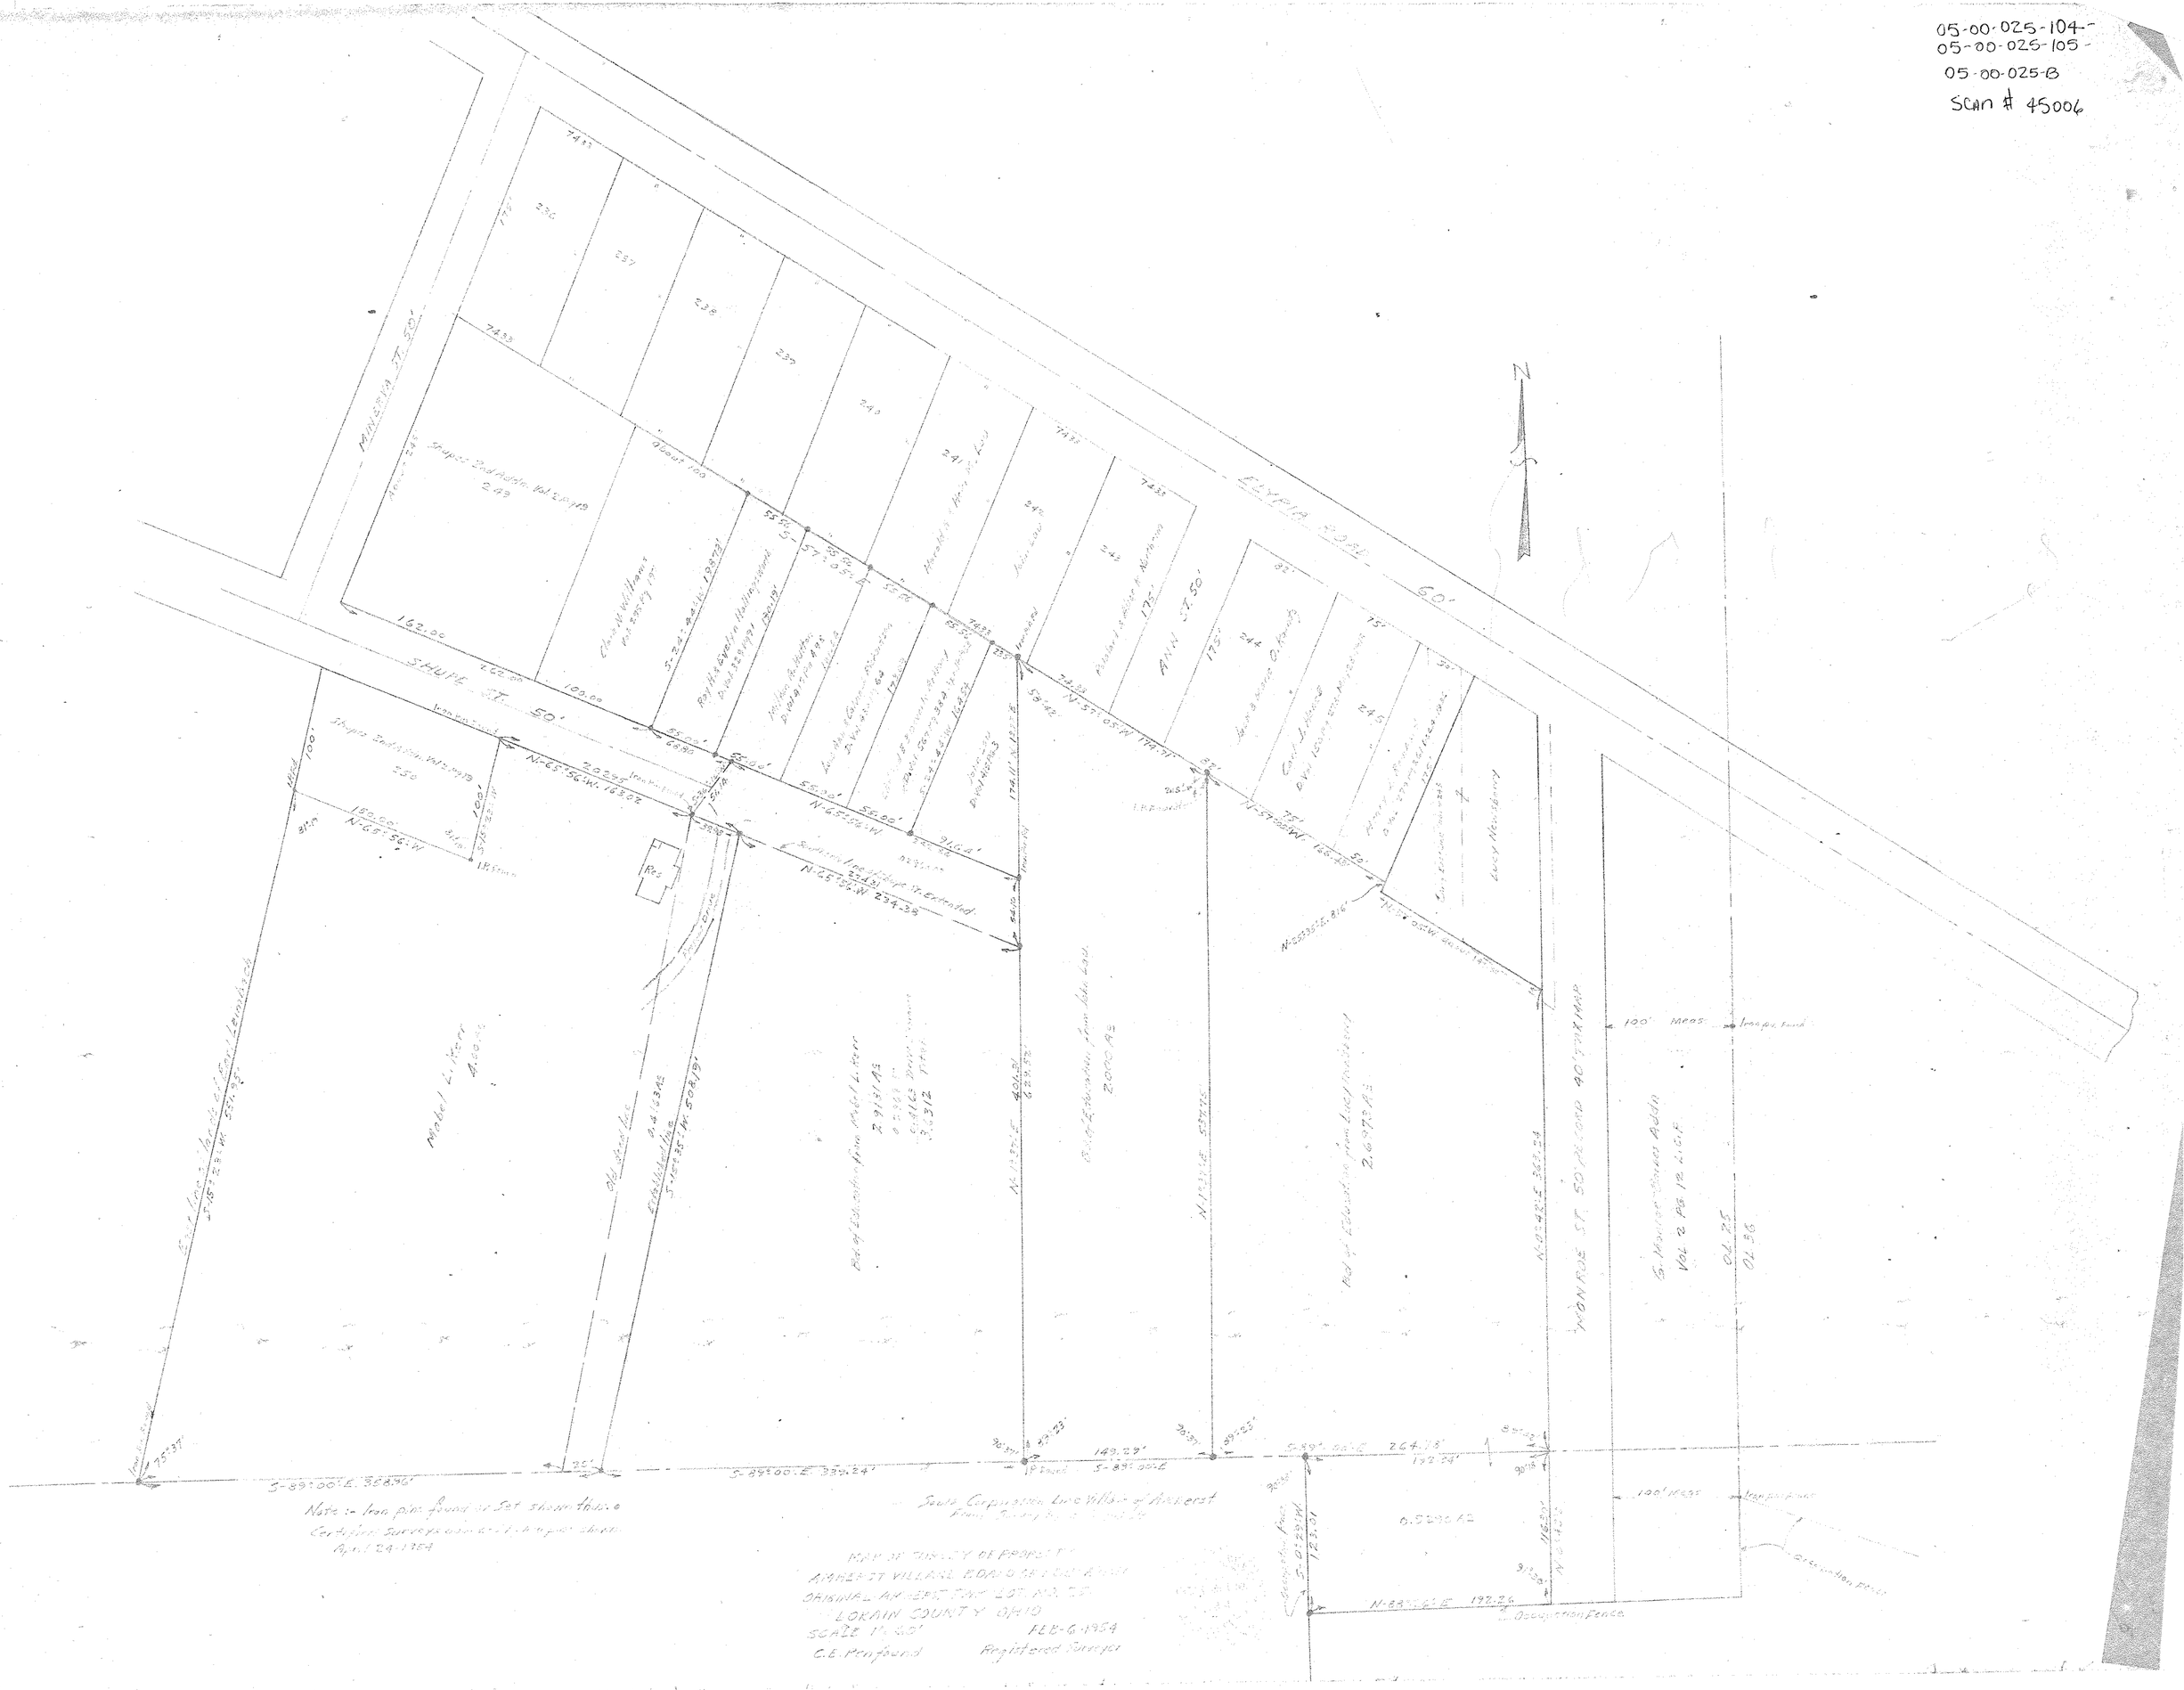05-00-025-104-
05-00-025-105-
05-00-025-B
SCAN # 45006