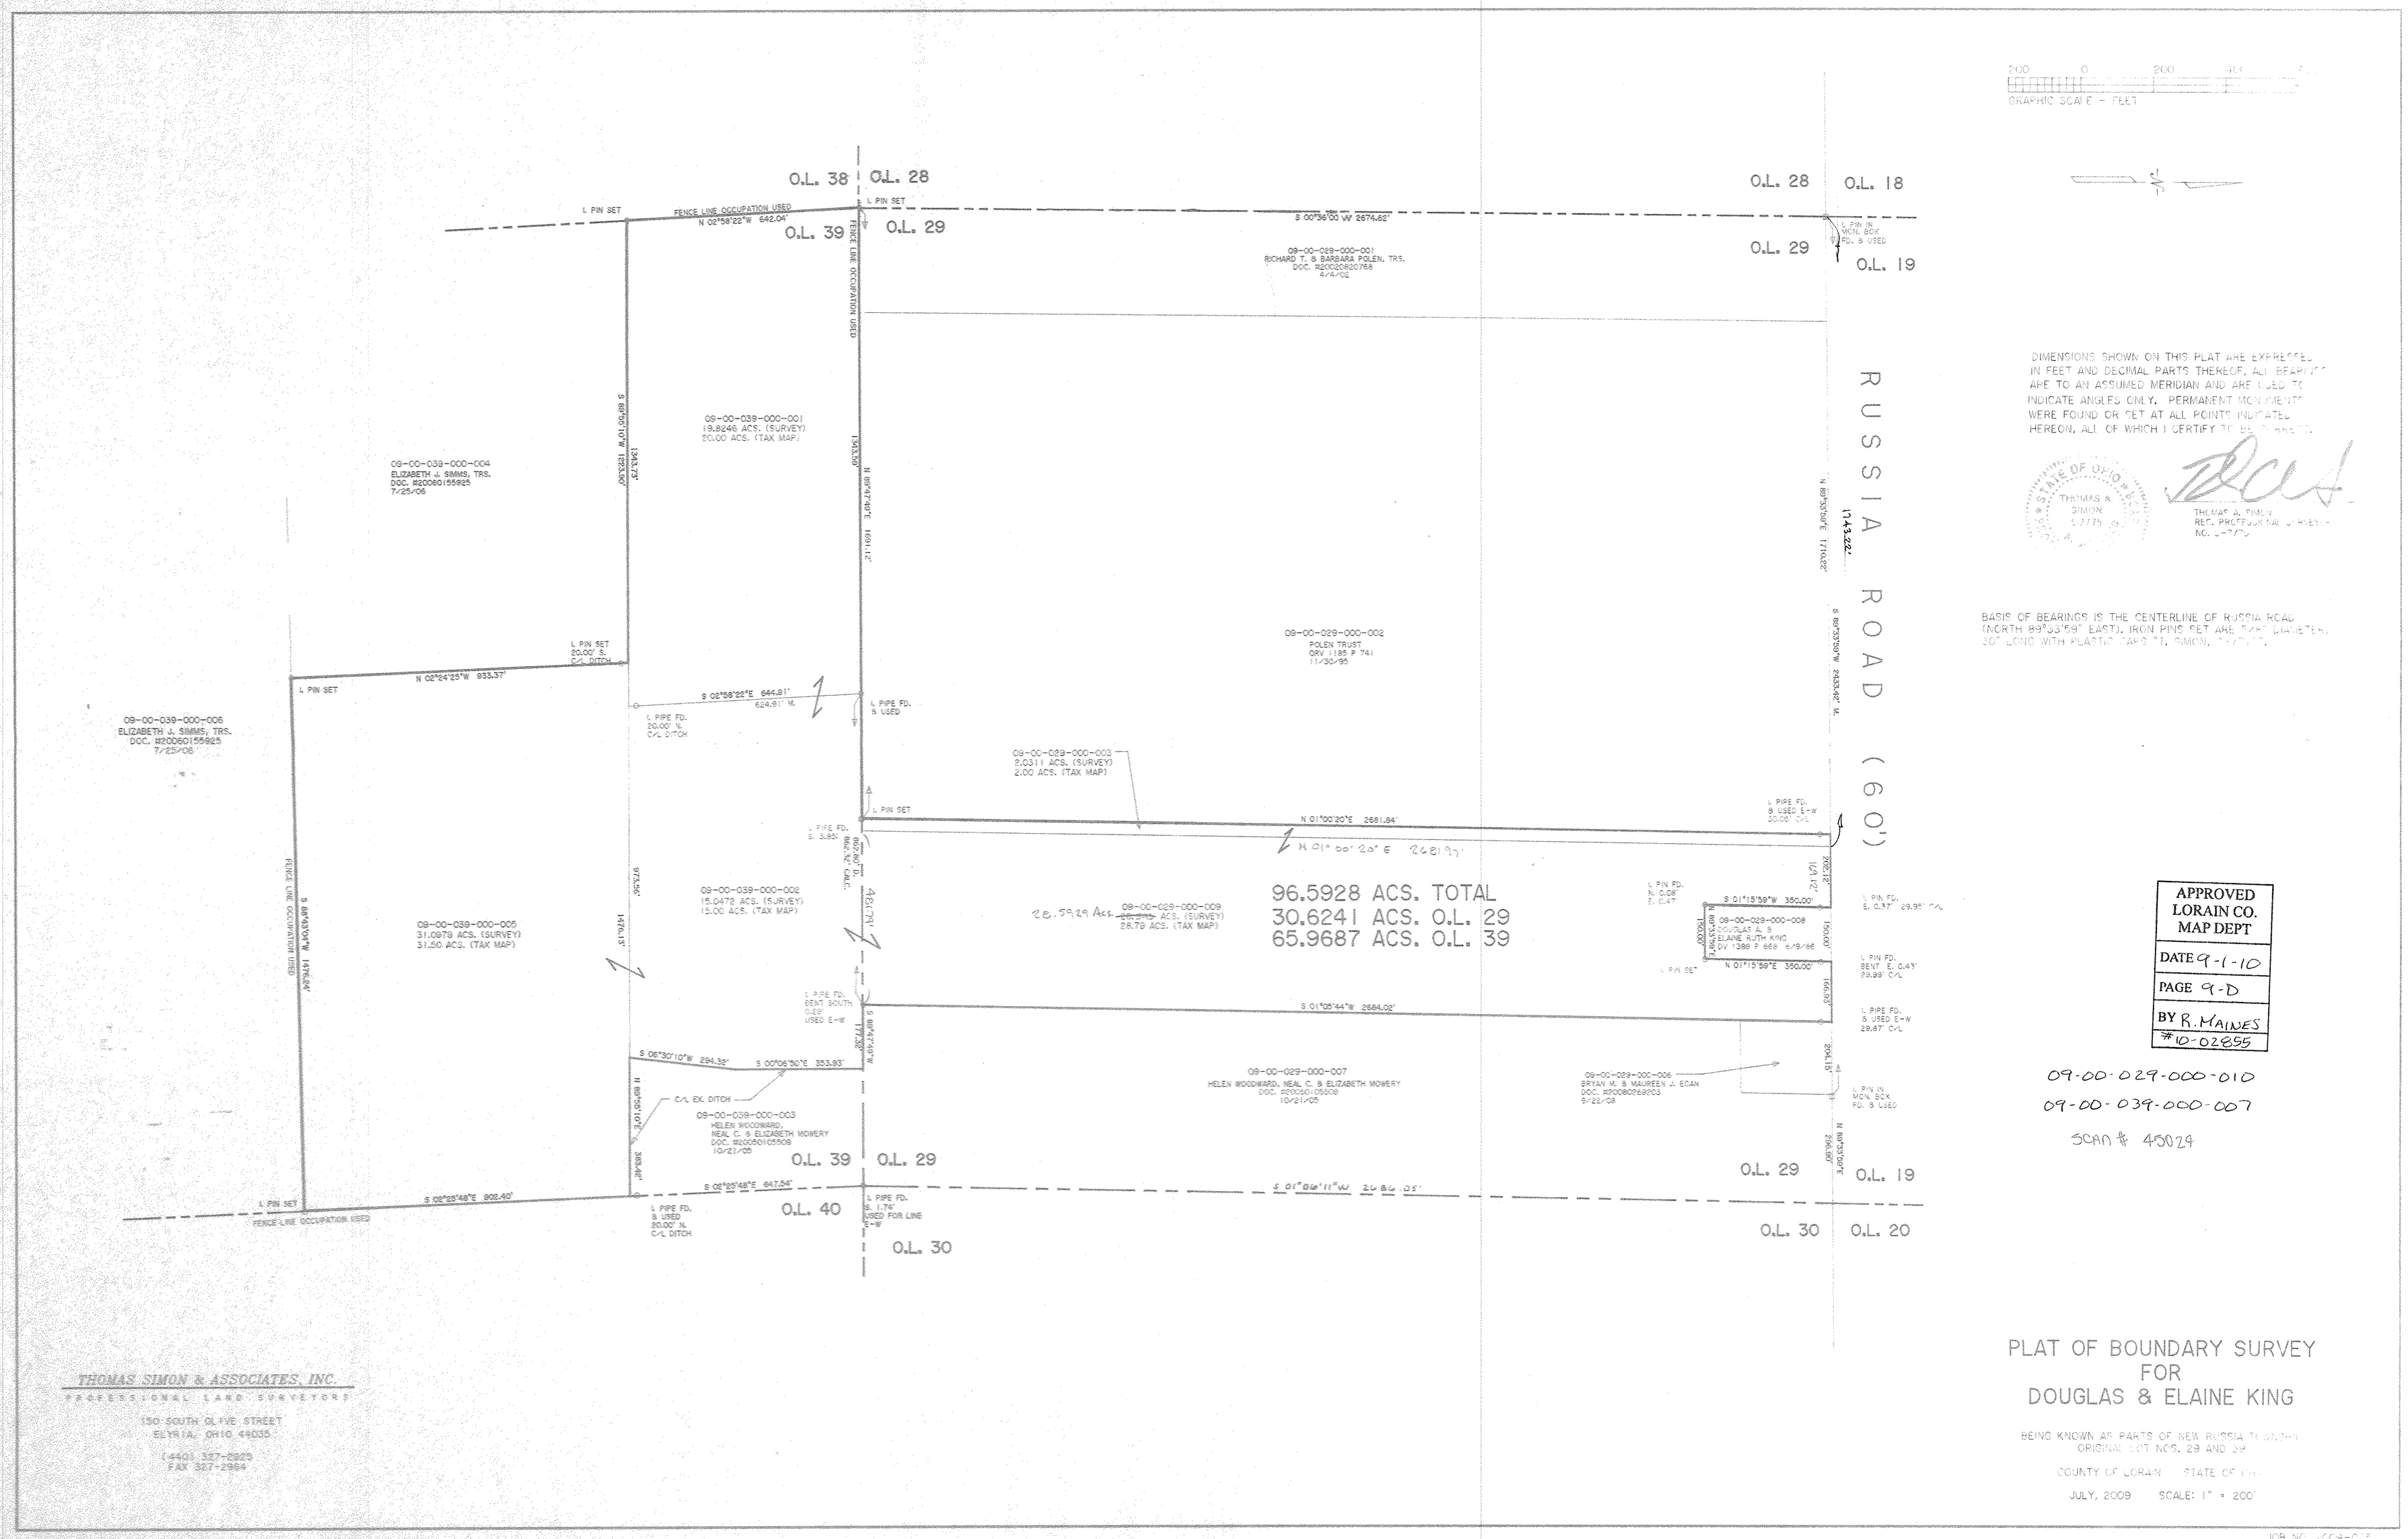

DIMENSIONS SHOWN ON THIS PLAT ARE EXPRESSED IN FEET AND DECIMAL PARTS THEREOF. ALL BEARINGS ARE TO AN ASSUMED MERIDIAN AND ARE USED TO INDICATE ANGLES ONLY. PERMANENT MONUMENTS WERE FOUND OR SET AT ALL POINTS INDICATED HEREON, ALL OF WHICH I CERTIFY TO BE CORRECT.

STATE OF OHIO THOMAS A. SIMON 5775

THOMAS A. SIMON
REG. PROFESSIONAL SURVEYOR
NO. 5775

BASIS OF BEARINGS IS THE CENTERLINE OF RUSSIA ROAD (NORTH 89°53'59" EAST). IRON PINS SET ARE 5/8" DIAMETER, 30" LONG WITH PLASTIC CAPS "T. SIMON, 5775".

APPROVED LORAIN CO. MAP DEPT
DATE 9-1-10
PAGE 9-D
BY R. MAINES
#10-02855

09-00-029-000-010
09-00-039-000-007

THOMAS SIMON & ASSOCIATES, INC.
PROFESSIONAL LAND SURVEYORS
150 SOUTH OLIVE STREET
ELYRIA, OHIO 44035
(440) 327-2825
FAX 327-2984

PLAT OF BOUNDARY SURVEY FOR DOUGLAS & ELAINE KING

BEING KNOWN AS PARTS OF NEW RUSSIA TOWNSHIP ORIGINAL LOT NOS. 29 AND 39

COUNTY OF LORAIN STATE OF OHIO

JULY, 2009 SCALE: 1" = 200'

JOB NO. 2009-02