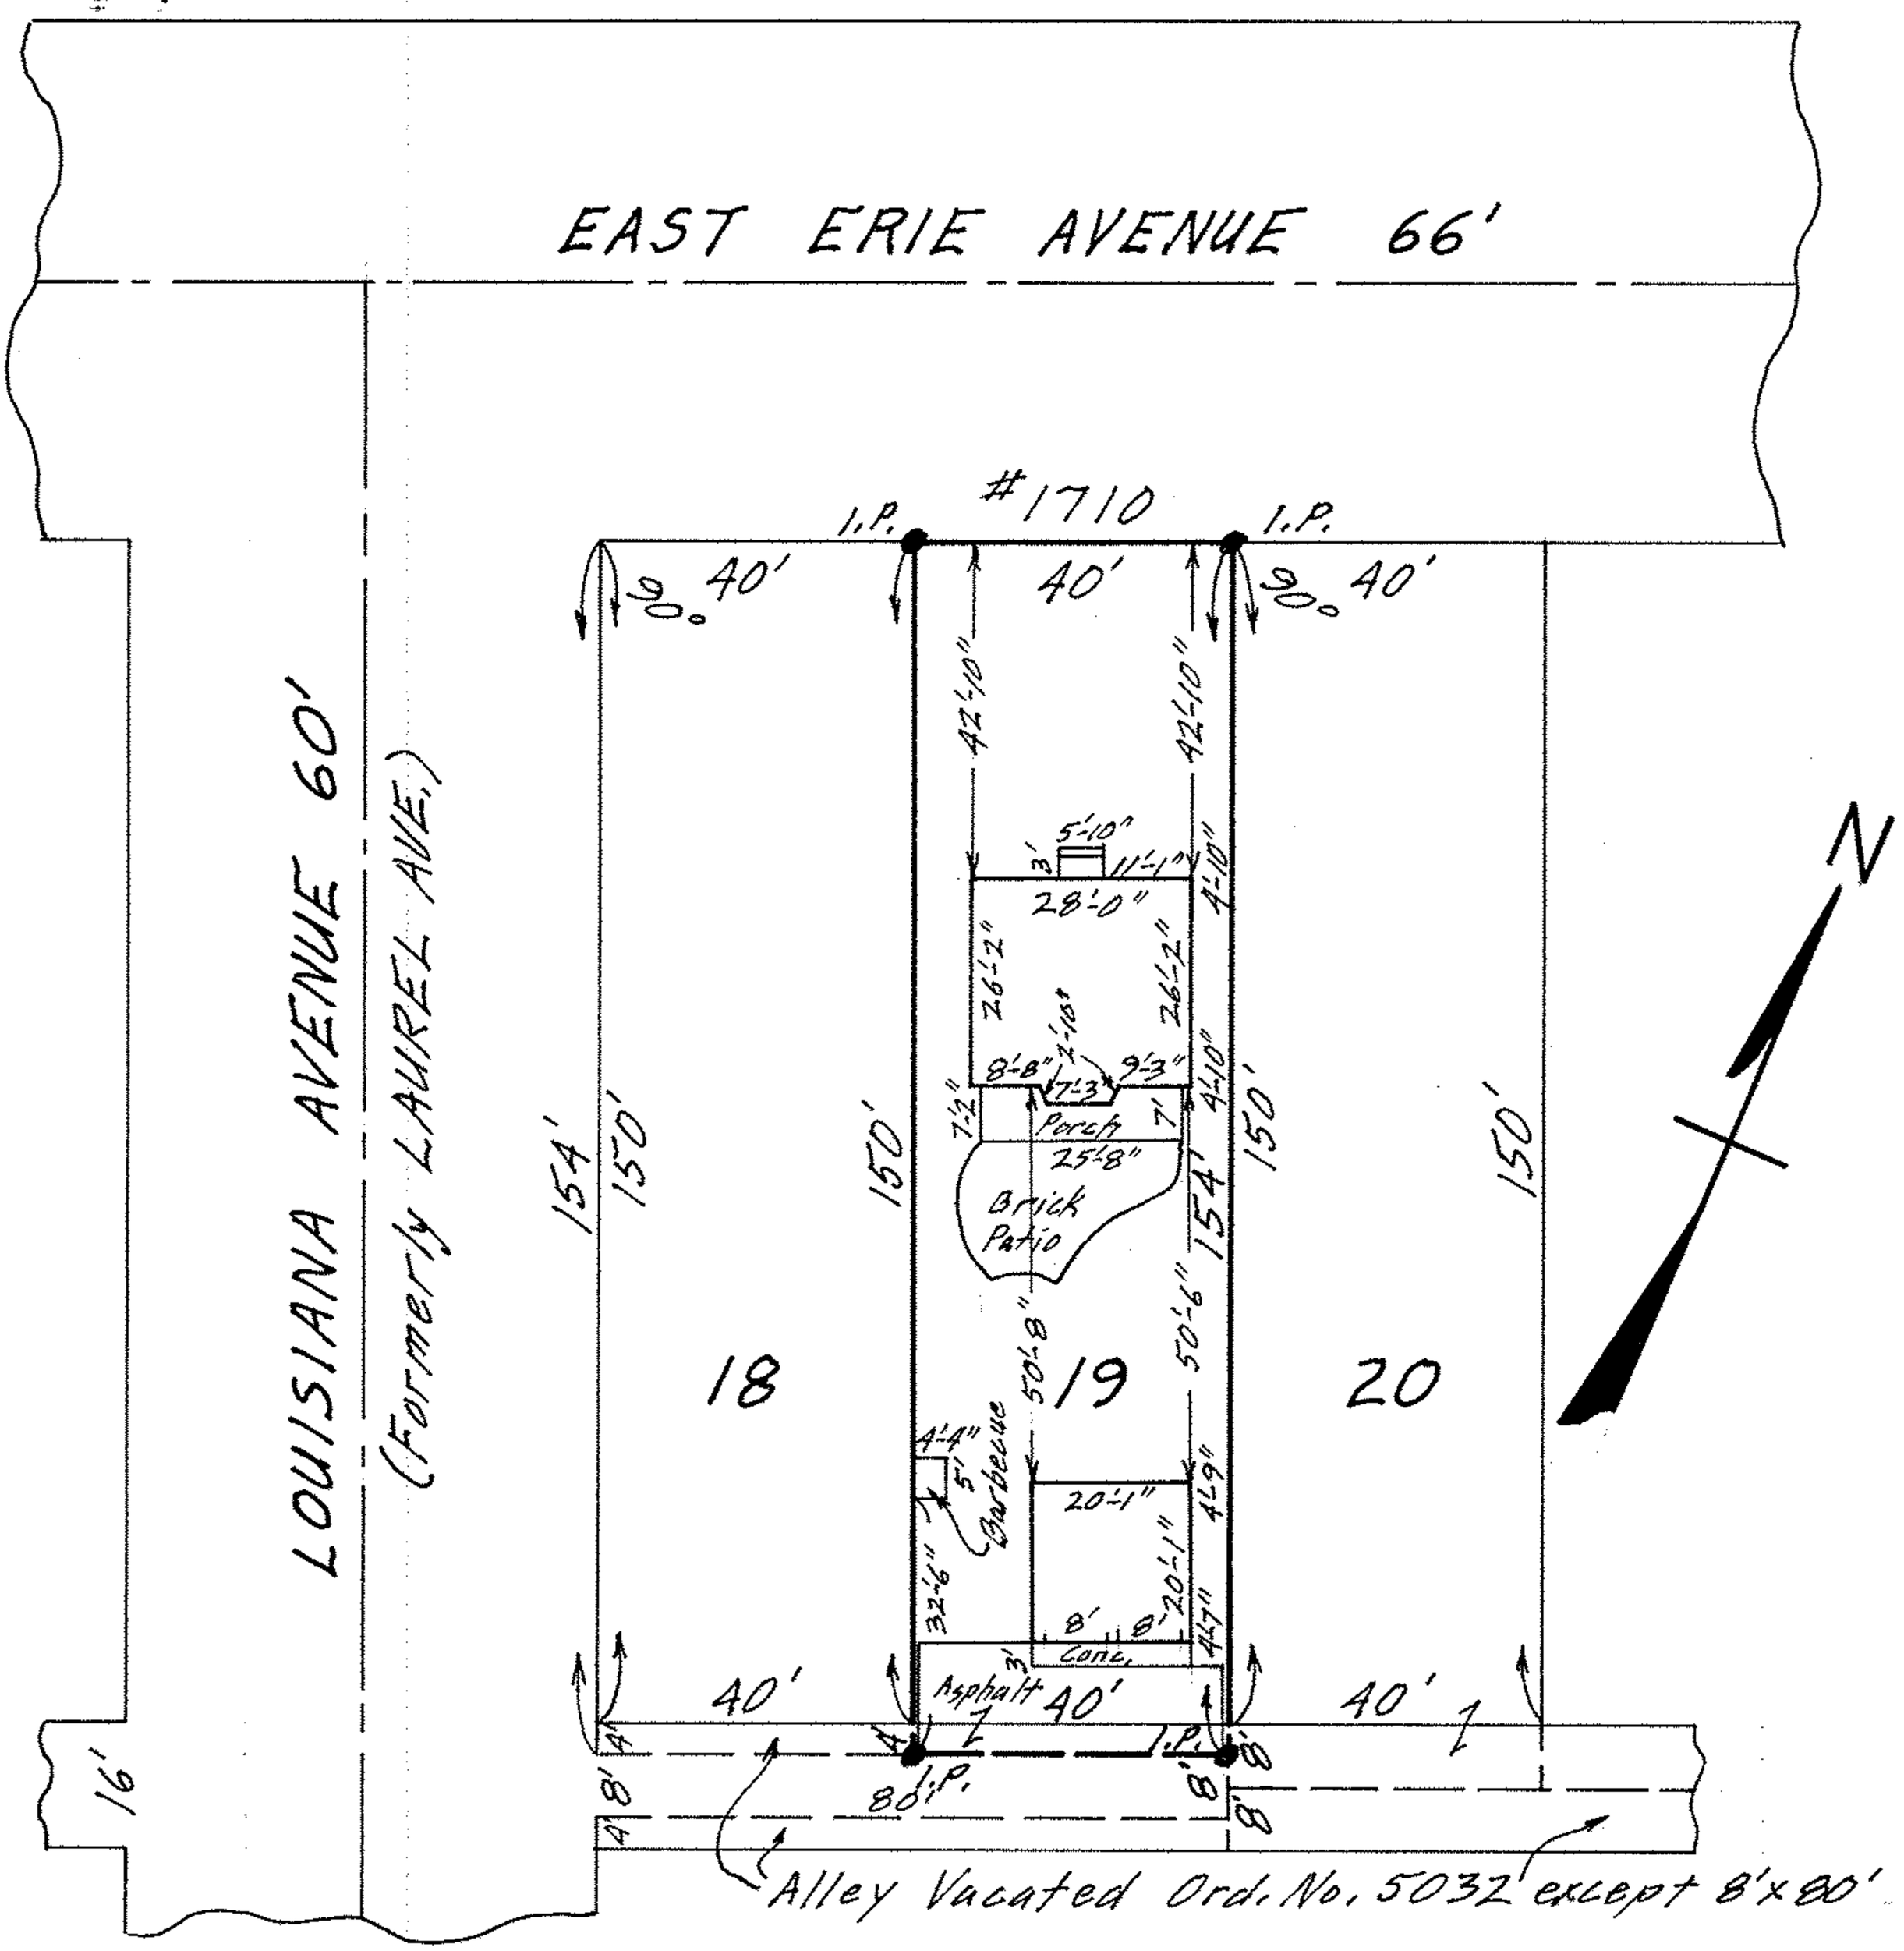

MAP OF SUB-LOT NO. 19

BONNY BRAE ADD'N. VOL. 7 PG. 14

ORIG. LOT 51 SHEFFIELD TWP.

LORAIN CITY - LORAIN COUNTY - OHIO

SCALE: 1" = 30' OCT. 4-1966 5:10 P.M.

Guy E. Penfound REG. SURVEYOR

Frank & Suzanne Lillian Holmes

02-00-051 PG.

02.00.051.106.002