02-00-051-117-001

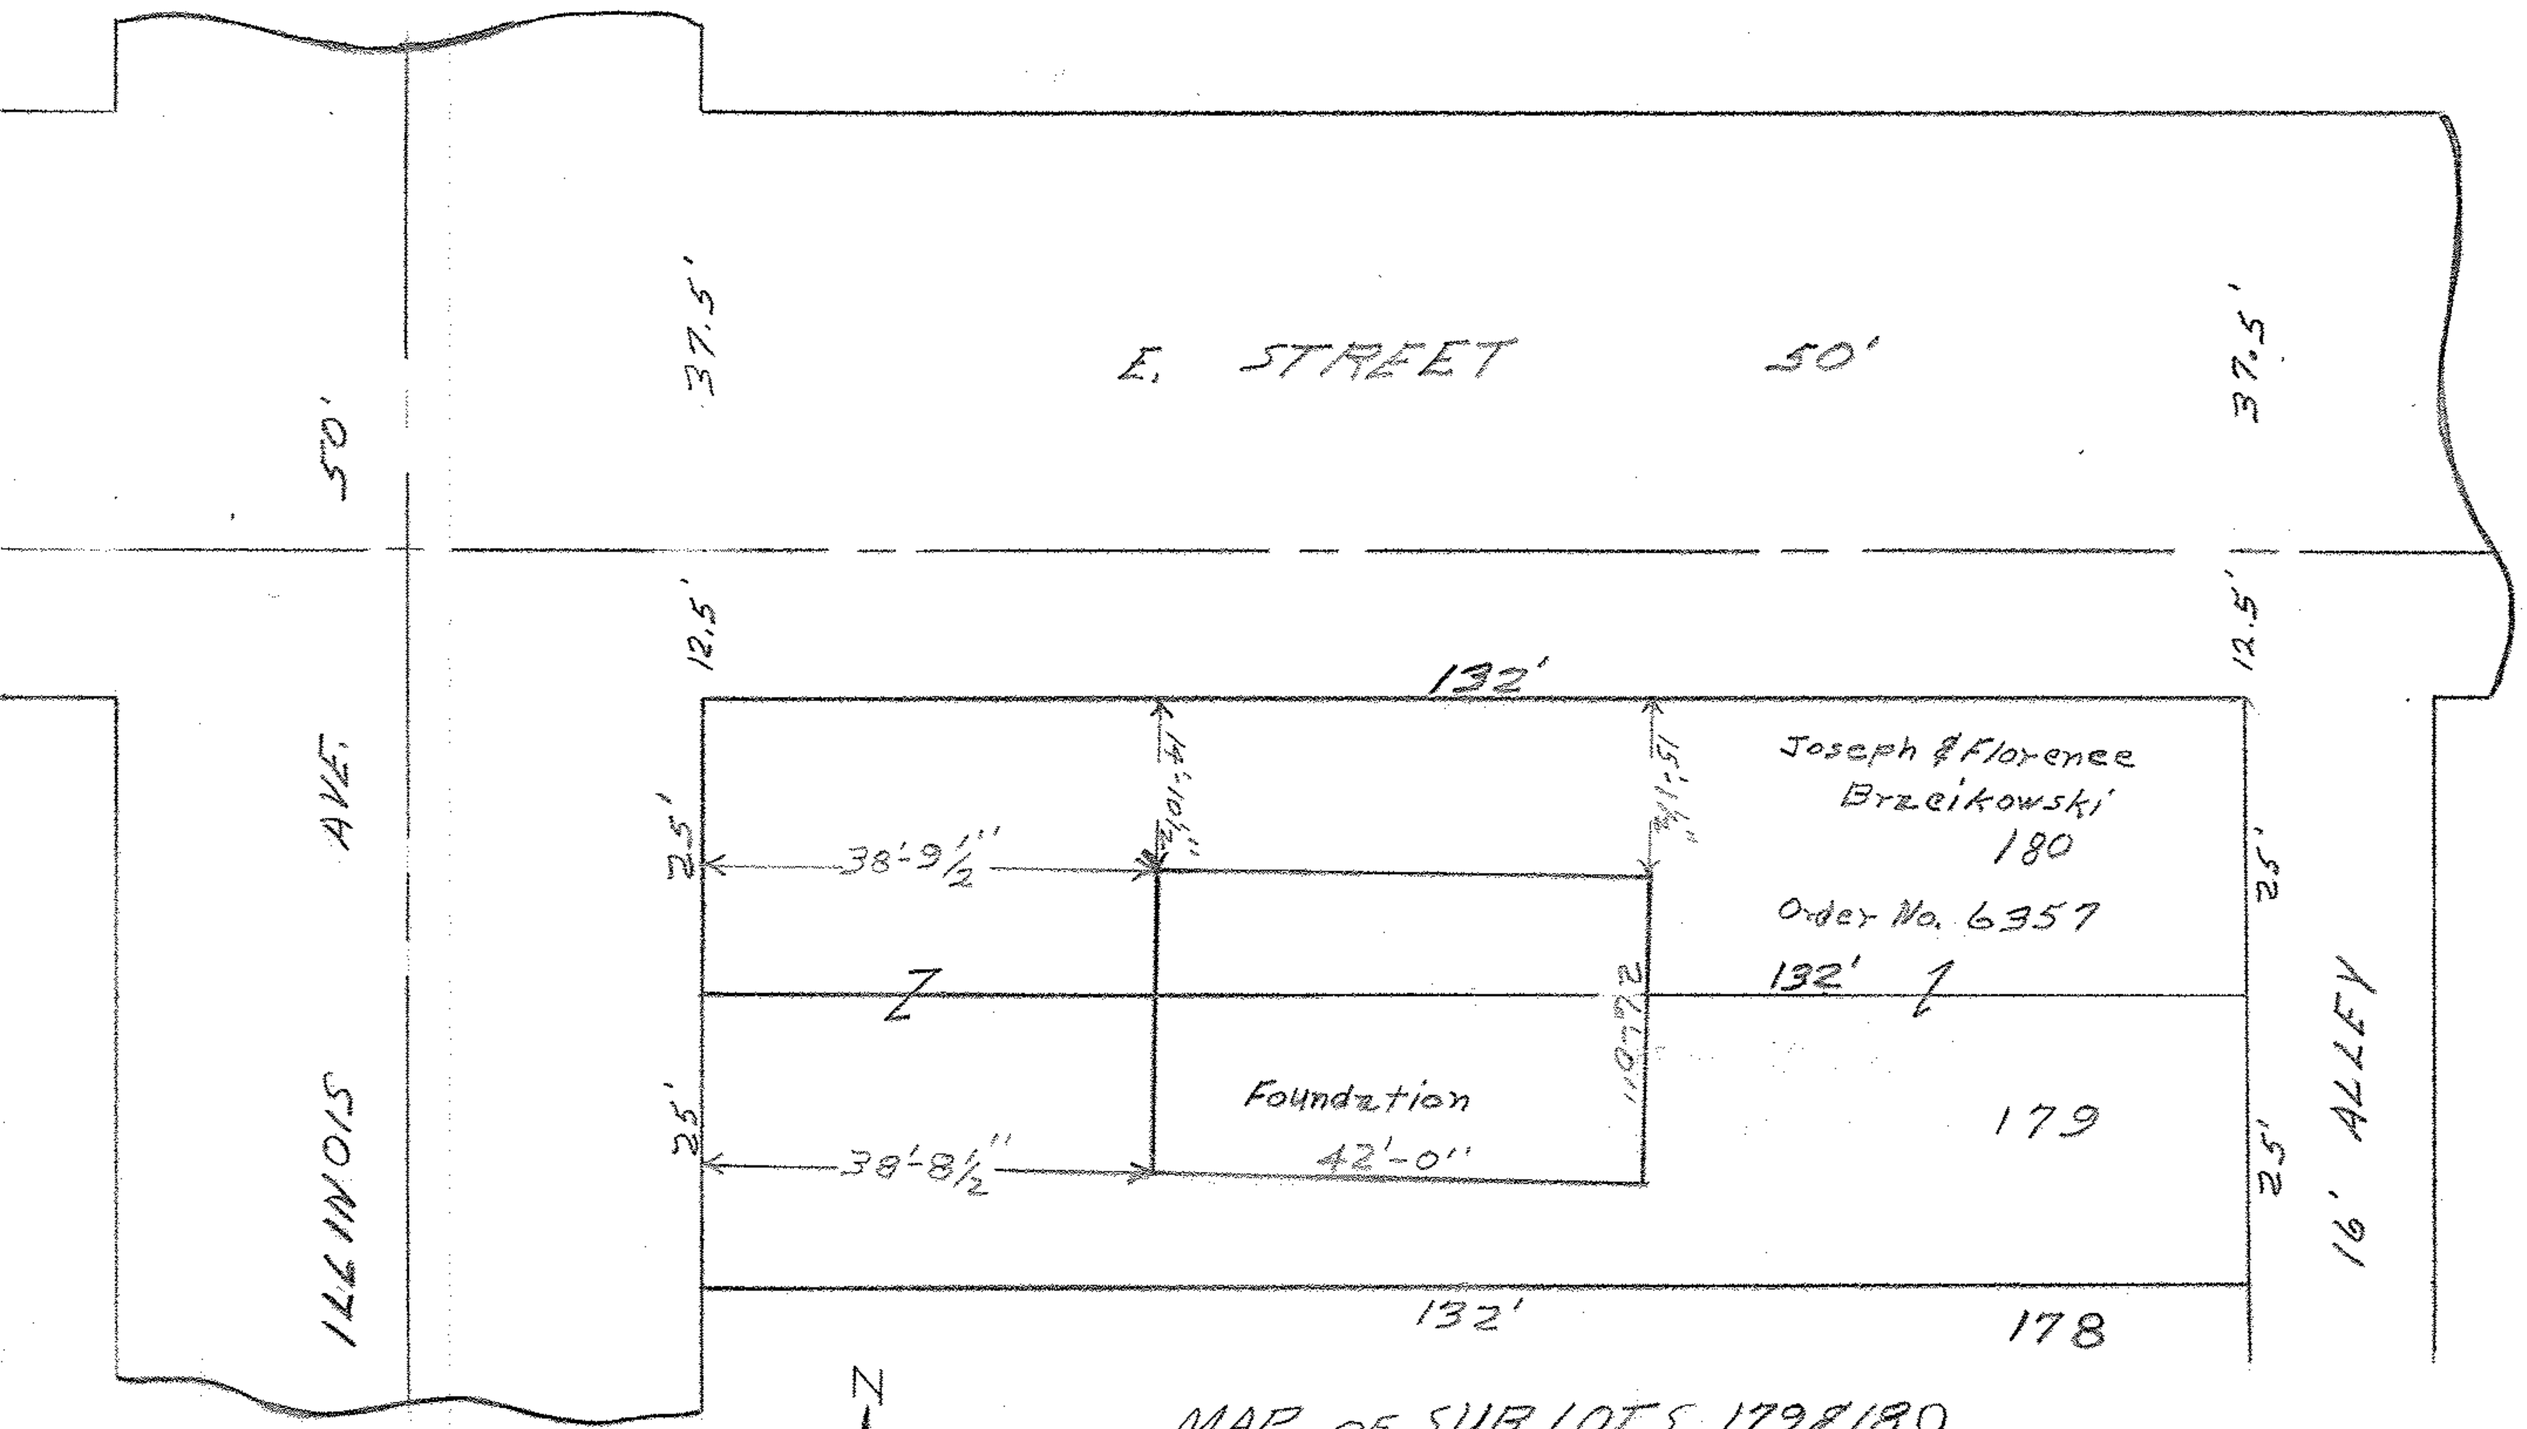

MAP OF SUBLOTS 179 & 180
FAIR HOME ALL'T Vol. 4 Pg. 13
ORIG. LOT 51 SHEFFIELD TWP LORAIN CITY
LORAIN COUNTY - OHIO
SCALE: 1" = 20' MAY 8, 1958 11:30 A.M.

Gary E. Penfound
for C.E. Penfound REG SURVEYORS

02-00-051