


02-00-051-137-061-009
02-00-051-B

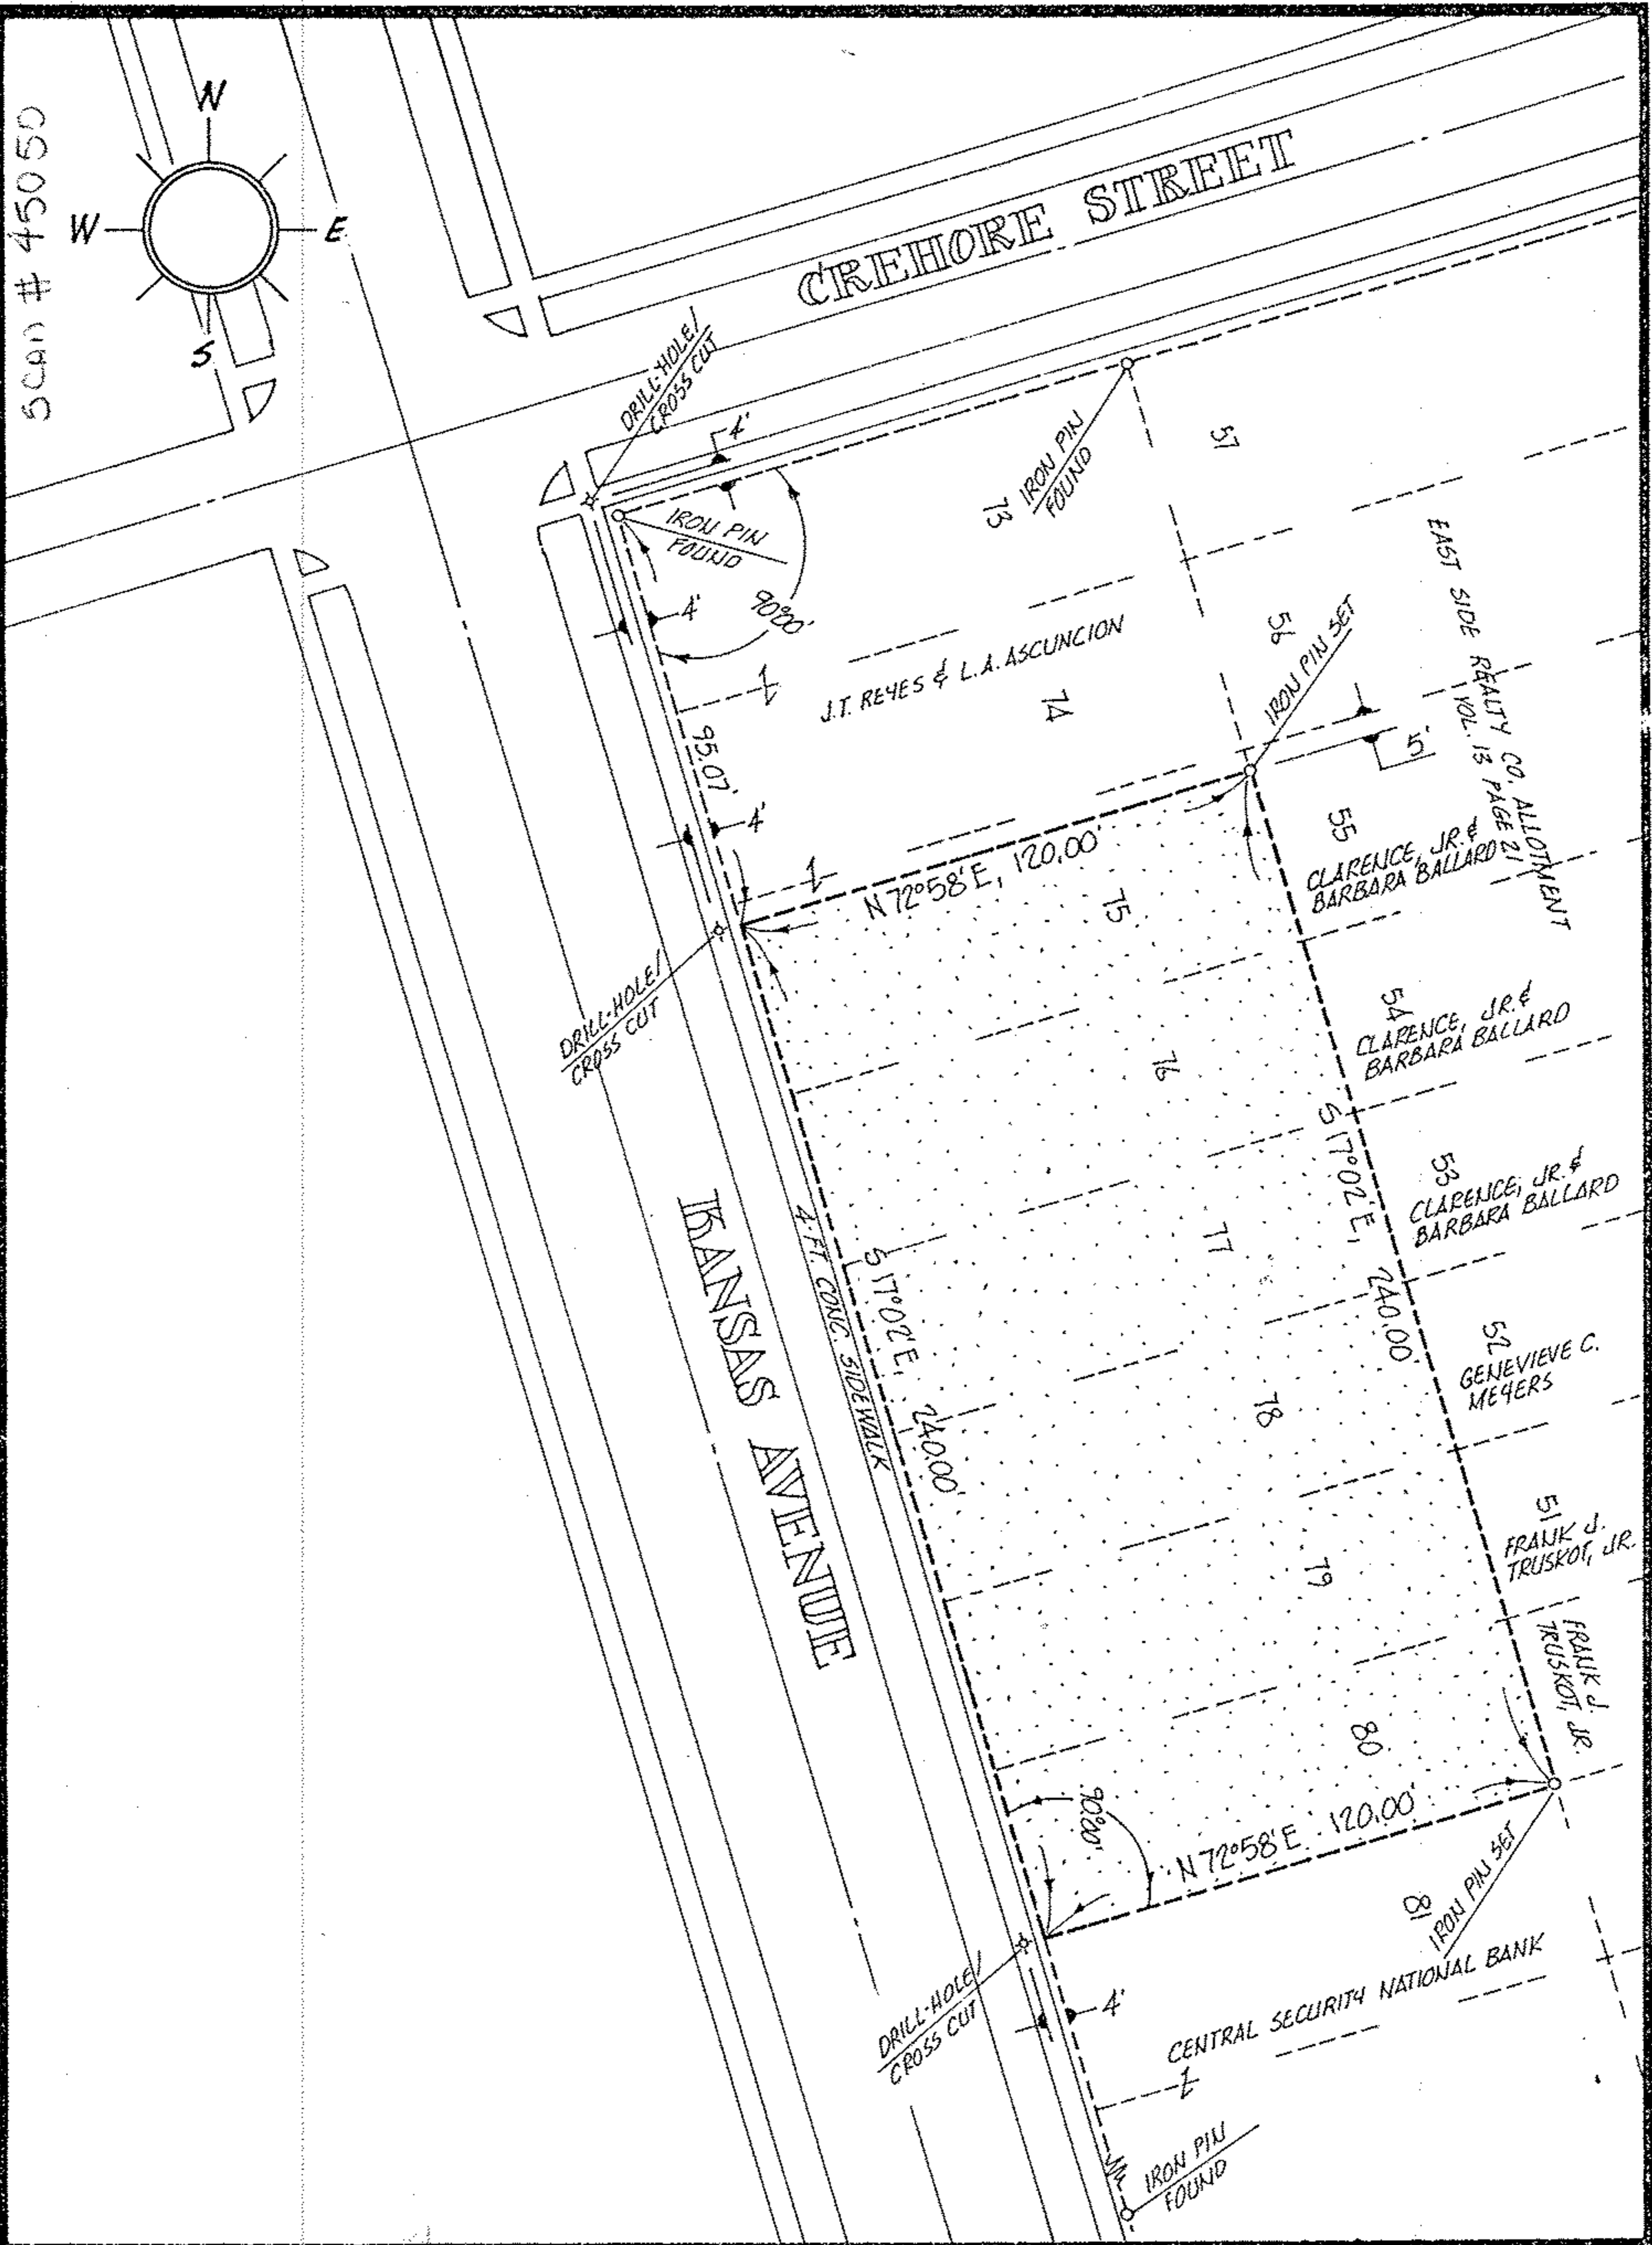

ACREAGE 0.661
DATE 06-17-86
DRAWN MGH
SCALE 1" = 50 ft.

PREPARED FOR RELIANCE ELECTRIC COMPANY 266-7000
29325 CHAGRIN BLVD., CLEVELAND 44122

MICHAEL G. HURA, registered surveyor
12706 MASON RD., VERMILION, O., Ph (216) 965 4040

PERIMETER SURVEY

SUBLOT(S) 76-77-78-79-80 AND PART 75 of EAST SIDE REALTY CO. ALLOTMENT
Volume 13 Page 21 of PLATS
PART OF O.L. 51 TRACT _____ SECTION _____ OF
BLACK RIVER/ORIGINALLY SHEFFIELD TOWNSHIP LORAIN CO., OHIO
PERMANENT PARCEL NO _____



CITY OF LORAIN