02-01-002-01-020
02-01-003 & 46000

MAP OF SUB-LOT NO. 13

LAKE SIDE ALL'T. VOL. 5 PG. 4 PLATS
ORIG. LOTS 1 & 2, TRACT 1, BLACK RIVER TWP.
LORAIN CITY LORAIN COUNTY OHIO
SCALE: 1"=30' MARCH 6, 1962 12:15 P.M.
Gary E. Penfound REG. SURVEYOR

Gerald E. Garl, Inc. BH

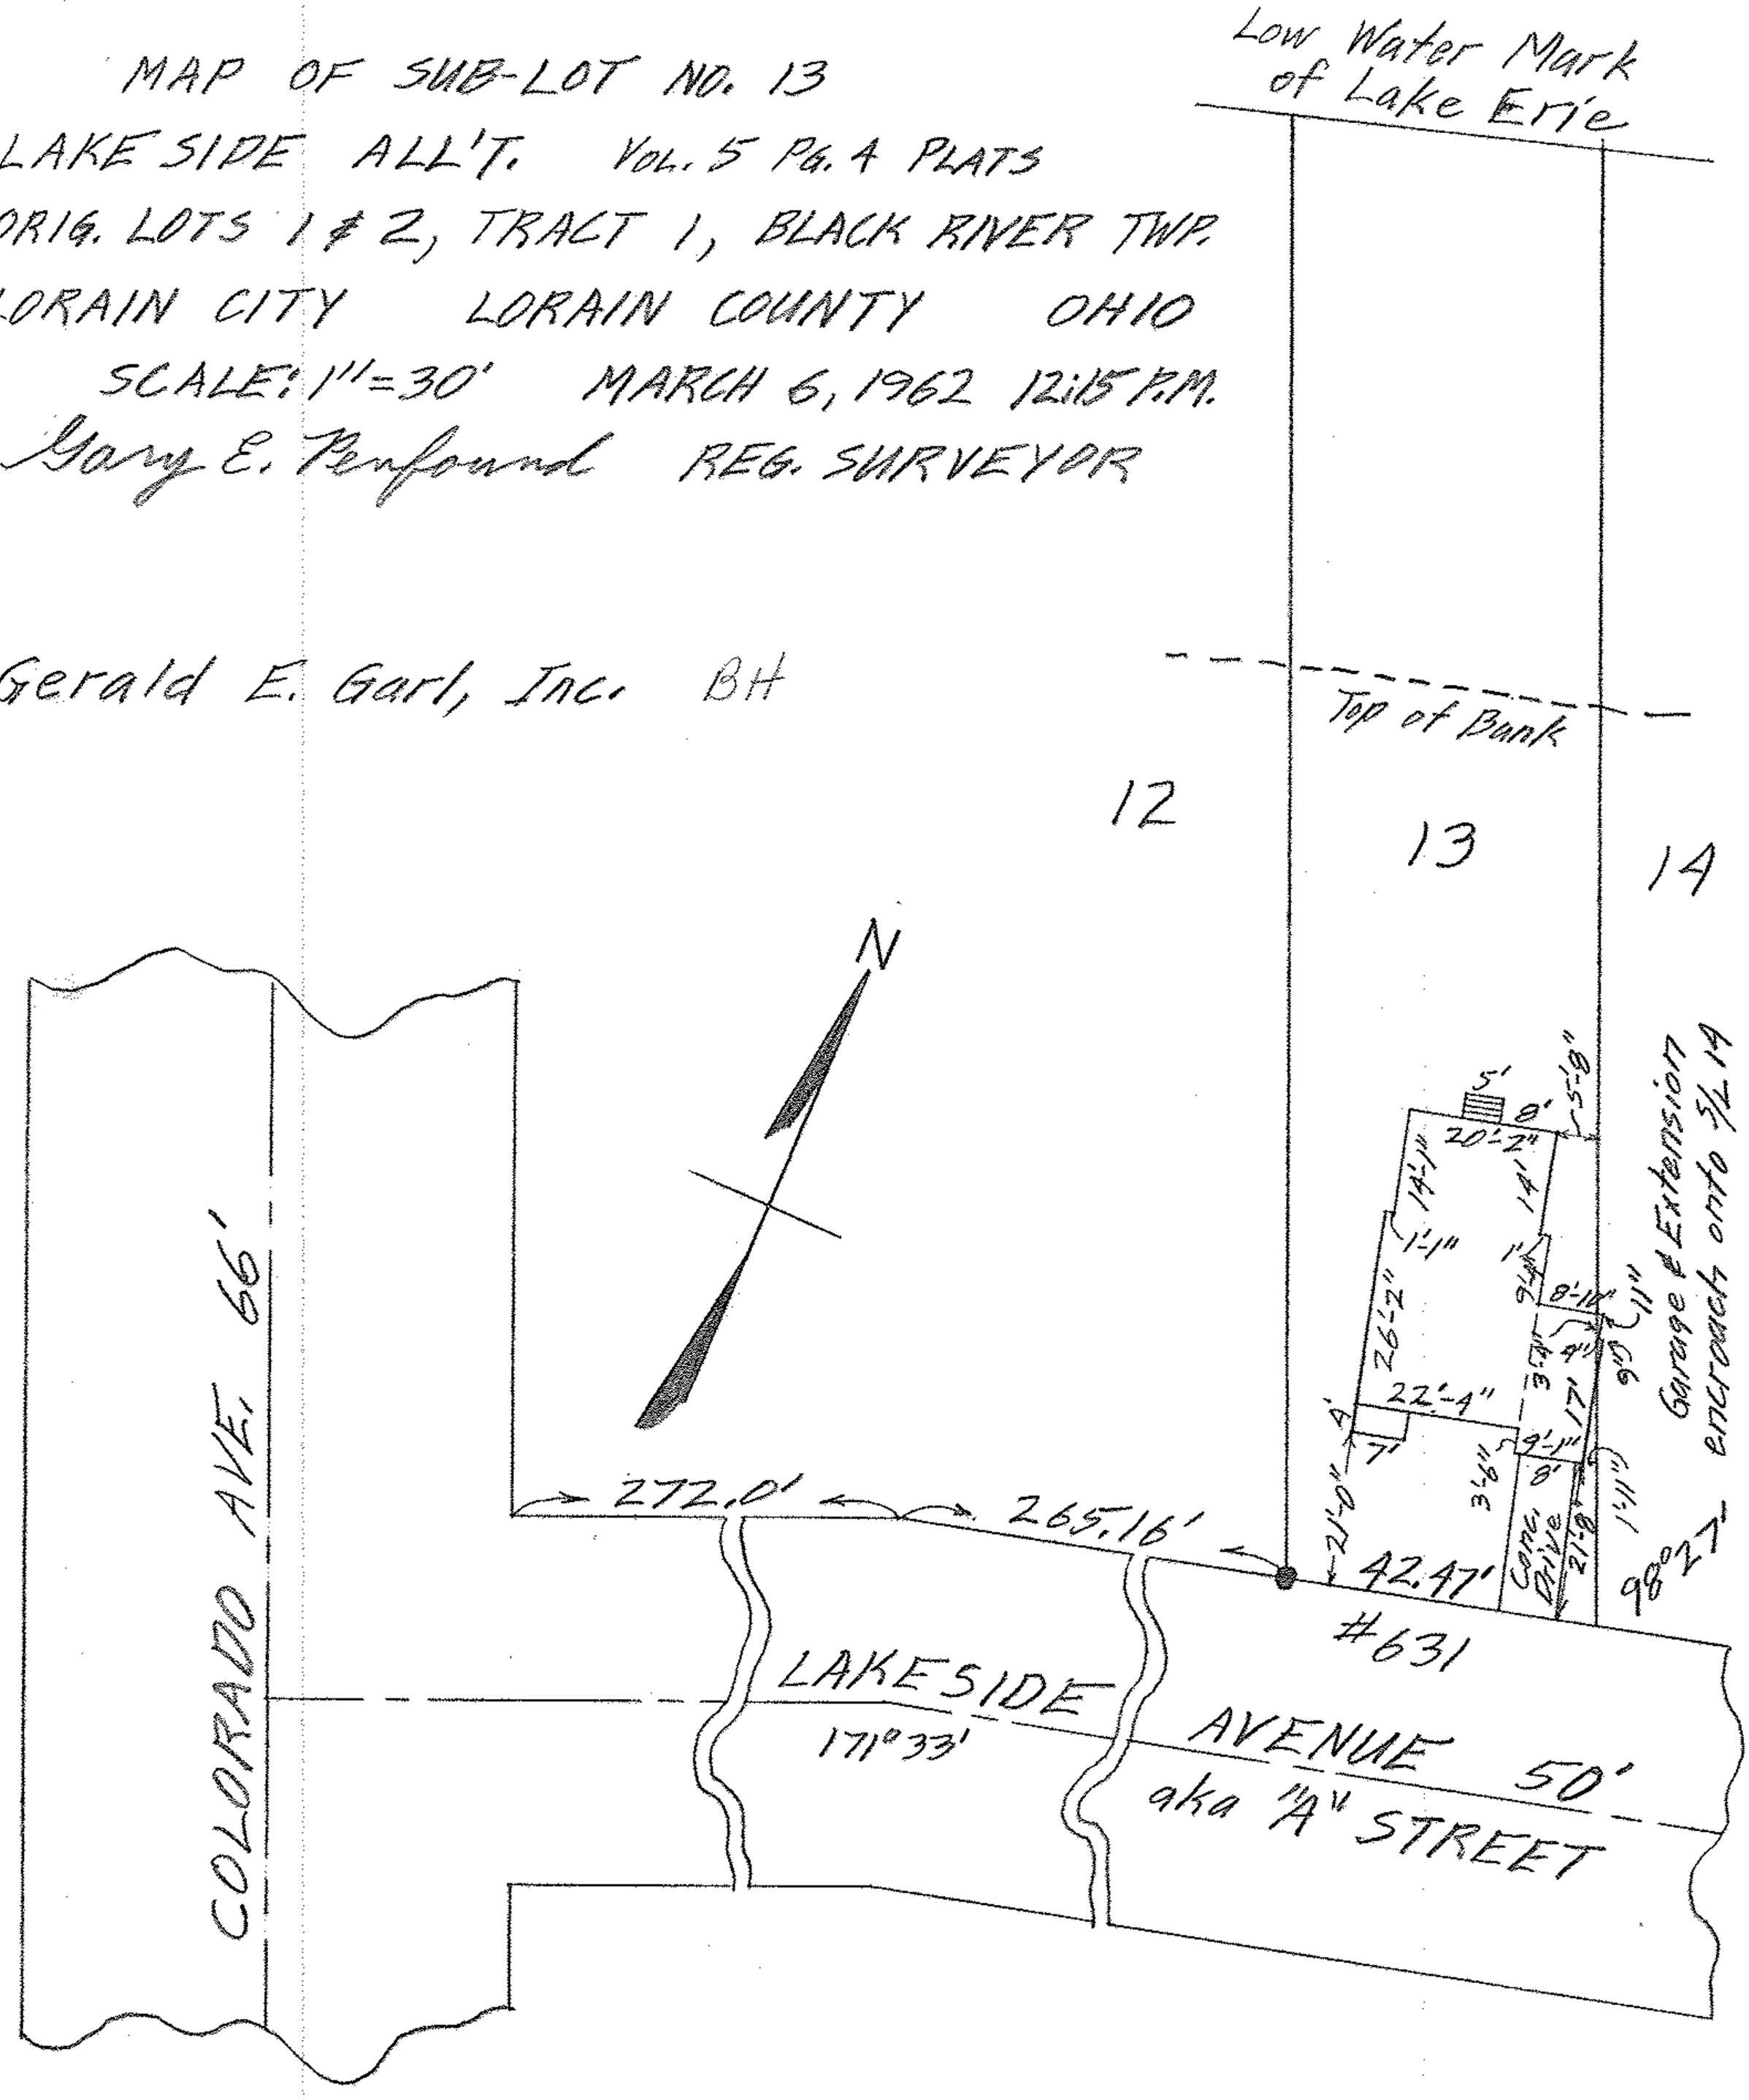

02-01-001, 2