


SCALE: 1" = 20'

OR Vol. 159/114

R/W PLANS
STATE
132.82
123.27
SCA-46-29E

SCA-46-29E

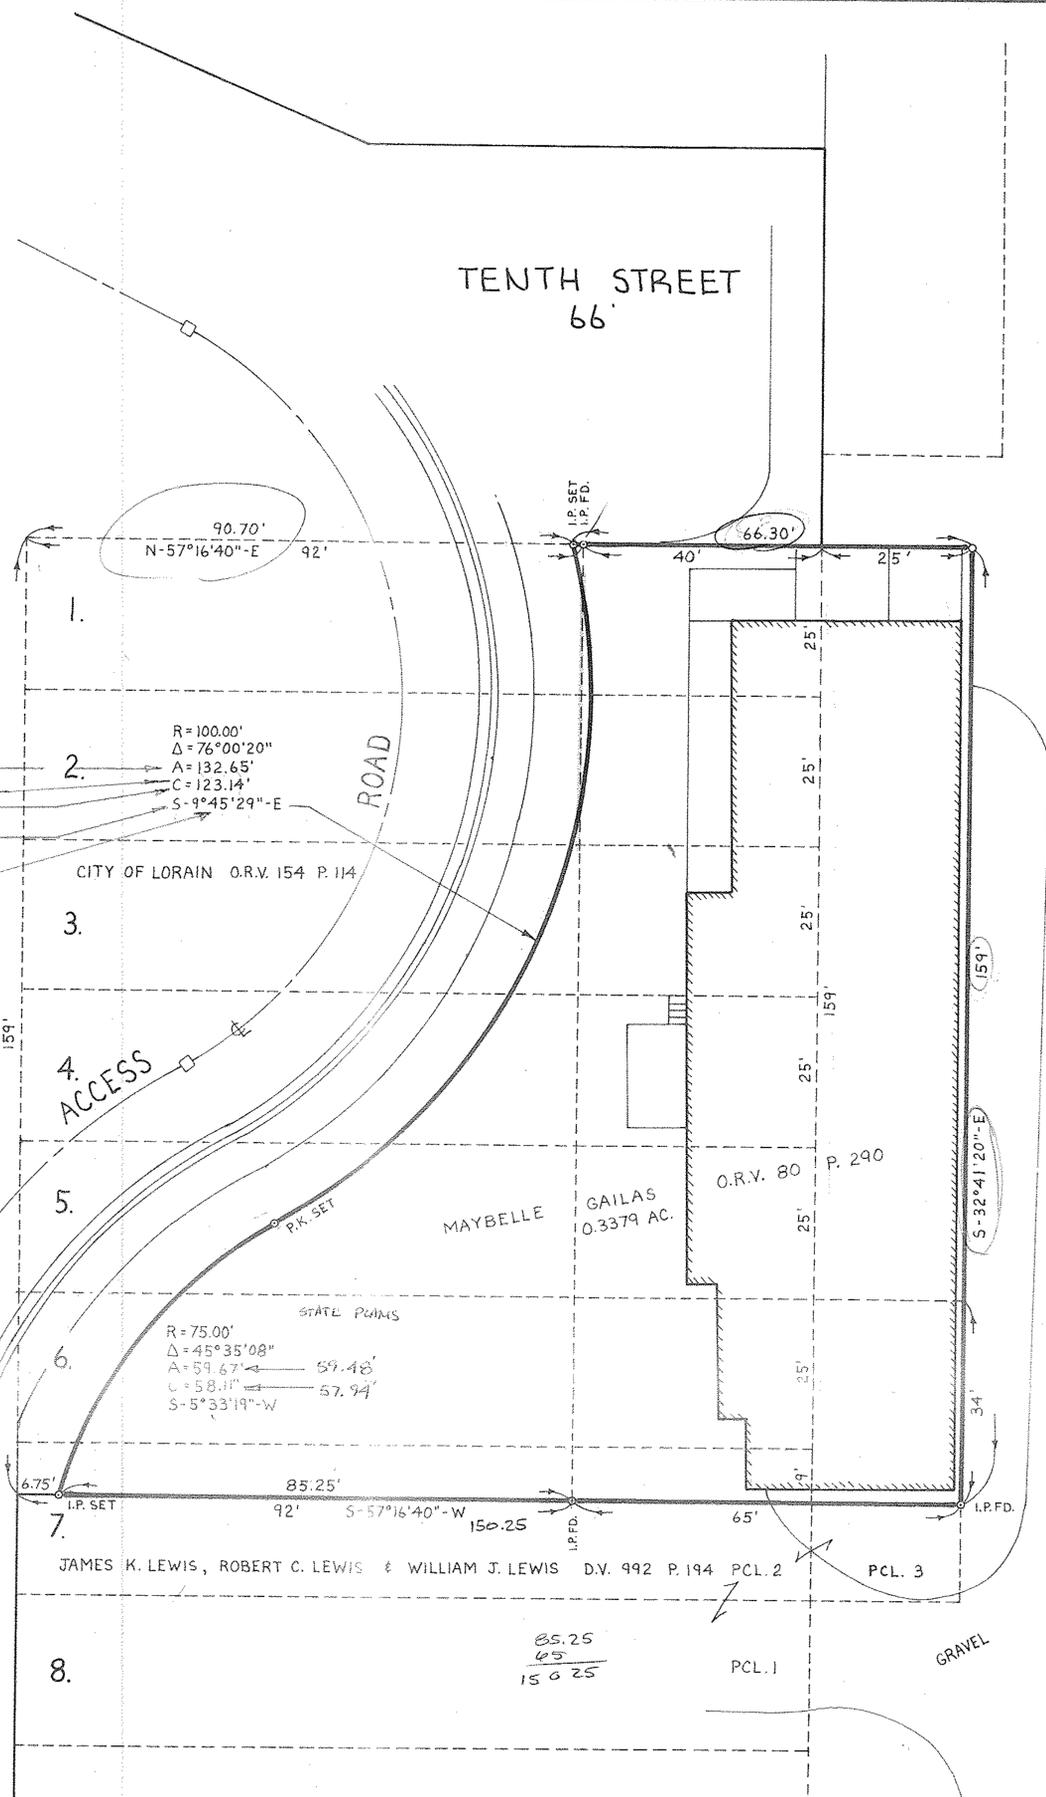

NORTH

BOUNDARY SURVEY

OF PARTS OF
SUBLOTS 1, 2, 3, 4, 5, 6 & 7 IN
SELAH CHAMBERLAIN TRUSTEE ALLOTMENT P.V. 2 P. 11
AND PART OF
BLACK RIVER TOWNSHIP ORIGINAL LOT 3 TRACT 1
CITY OF LORAIN COUNTY OF LORAIN STATE OF OHIO

#18910-A

APPROVED
LORAIN CO.
MAP DEPT.
DATE 4-20-90
PAGE 201-003-C
BY *T. McMan*
VOID AFTER 18910-A

PREPARED BY:
KS ASSOCIATES INC.
ENGINEERS ~ SURVEYORS

David L. Elwell
DAVID L. ELWELL REG. SURVEYOR NO. 6333
3-28-90

