02-01-003-140-033,034

02-01-003-F

Scan # 45071

MAP OF SUB-LOTS NOS. 11, 12 & 13 AND THE SOUTHERLY 4½ INCHES OF SUB-LOT NO. 10 OF BLOCK 32 IN SELAH CHAMBERLAIN TRUSTEE'S ALL'T. VOL. 2 PG. 11

ORIG. LOT 3 - TRACT 1 - BLACK RIVER TWP.

LORAIN CITY - LORAIN COUNTY - OHIO

SCALE: 1" = 20' JAN. 19-1967 4:00 P.M.

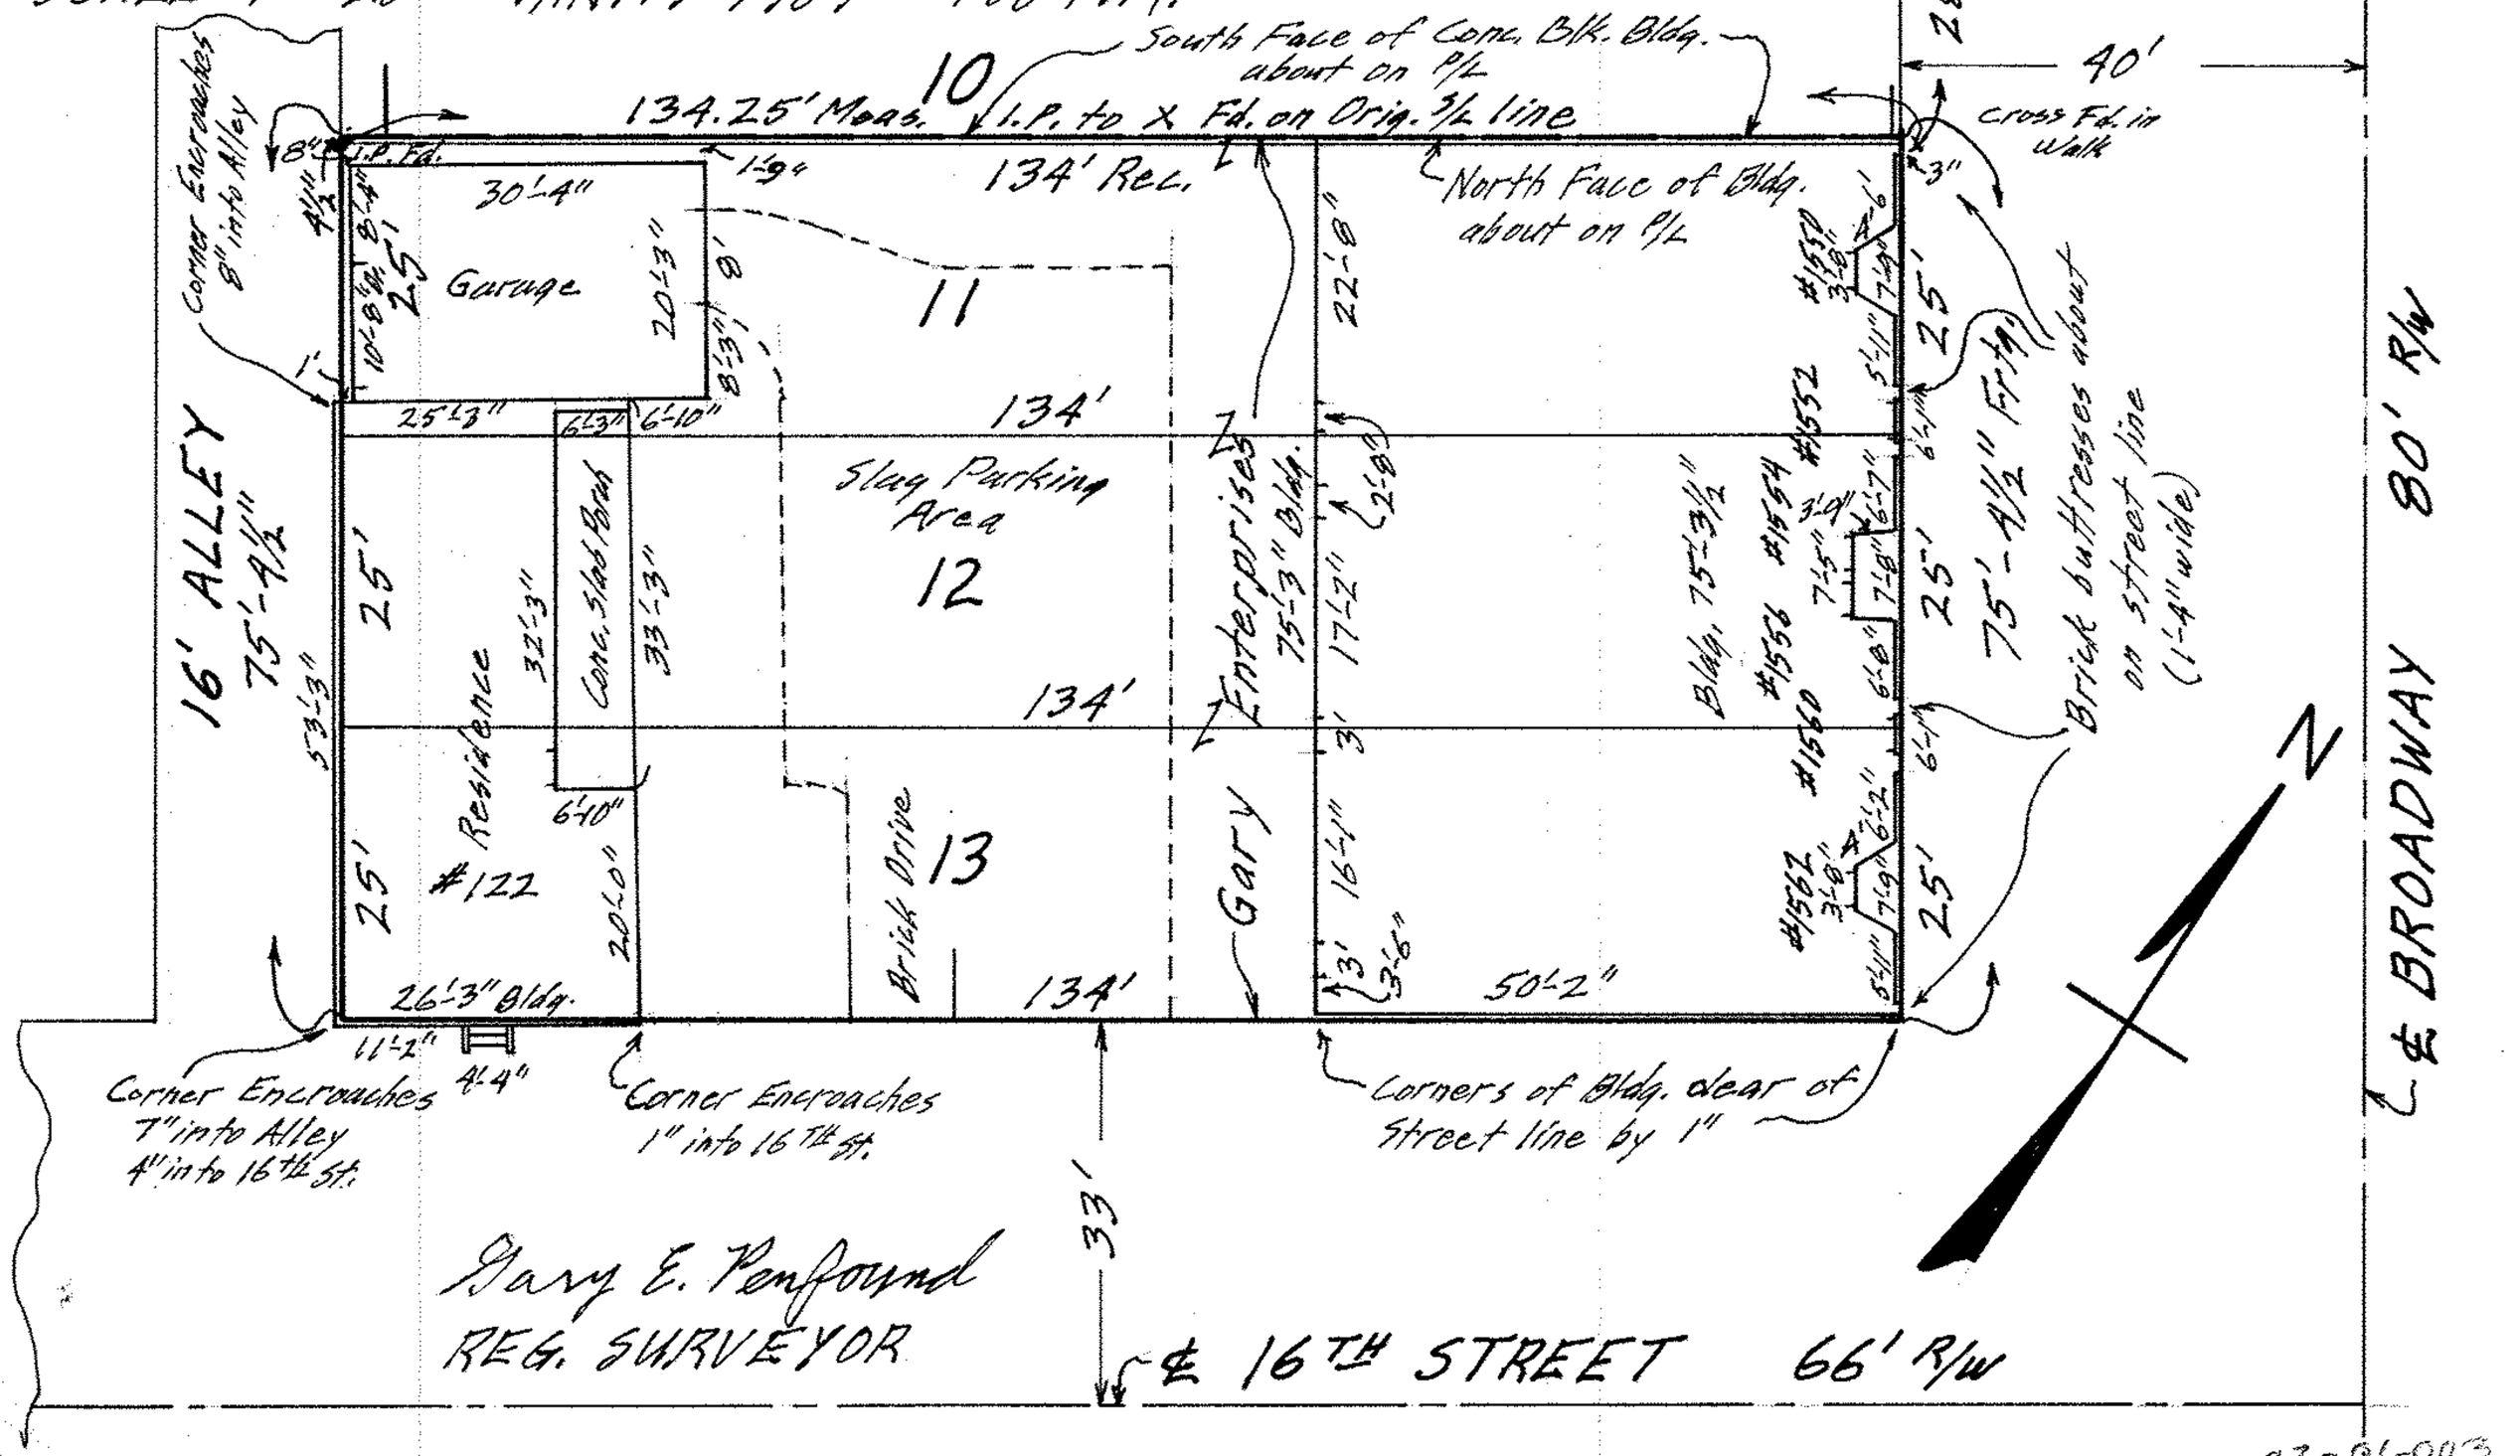

Gary E. Penfound
REG. SURVEYOR

02-01-003