Scan# 45093 02-01-004-109-015
02-01-004-B

MAP OF SUB-LOT NO. 16 AND THE SOUTHWESTERLY 5 FEET OF SUB-LOT NO. 14 OF BLOCK NO. 4 SELAH CHAMBERLAIN ALL'T. VOL. 2 PG. 11 ORIG. LOT 4 - TRACT 1 - BLACK RIVER TWP. LORAIN CITY - LORAIN COUNTY - OHIO
SCALE: 1"=30' JUNE 19-1970 3:45 P.M.
NOTE: There are no encroachments on this property.
Gary E. Penfound REG. SURVEYOR NO. 4457

CITY TITLE Co. Order No. E-1167-8
Bailey and Molnar to Delk

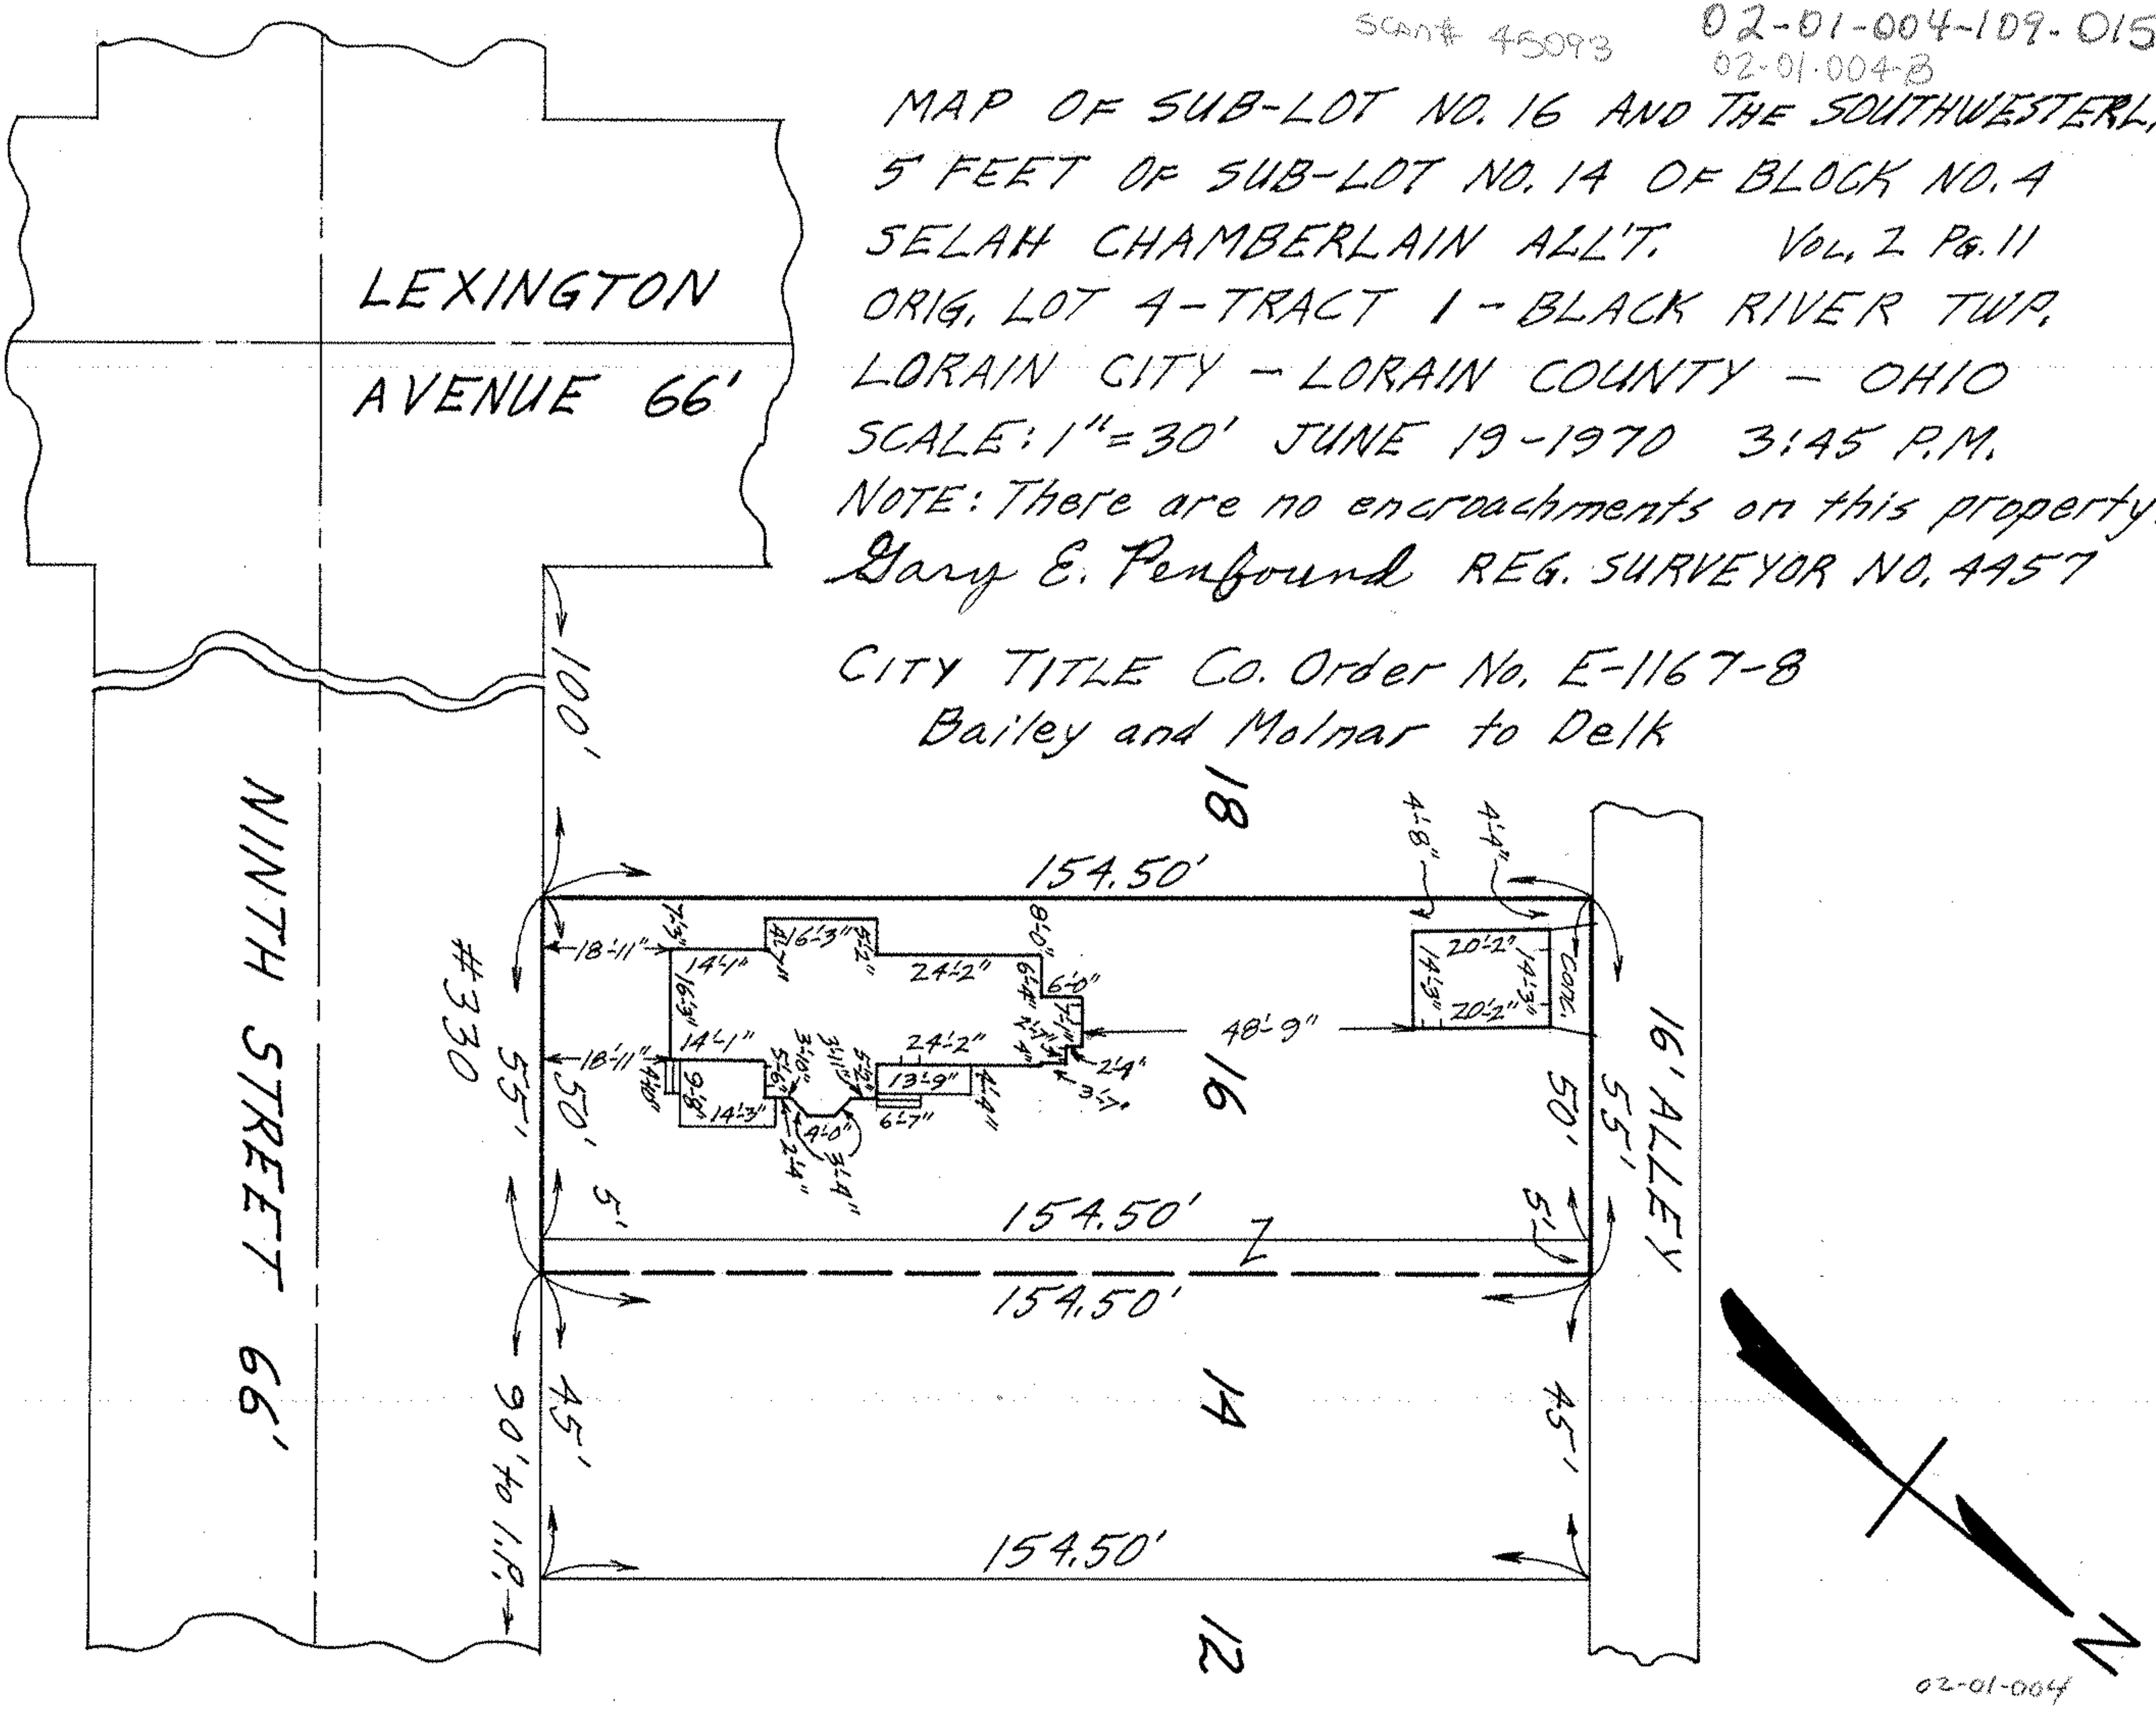

02-01-004