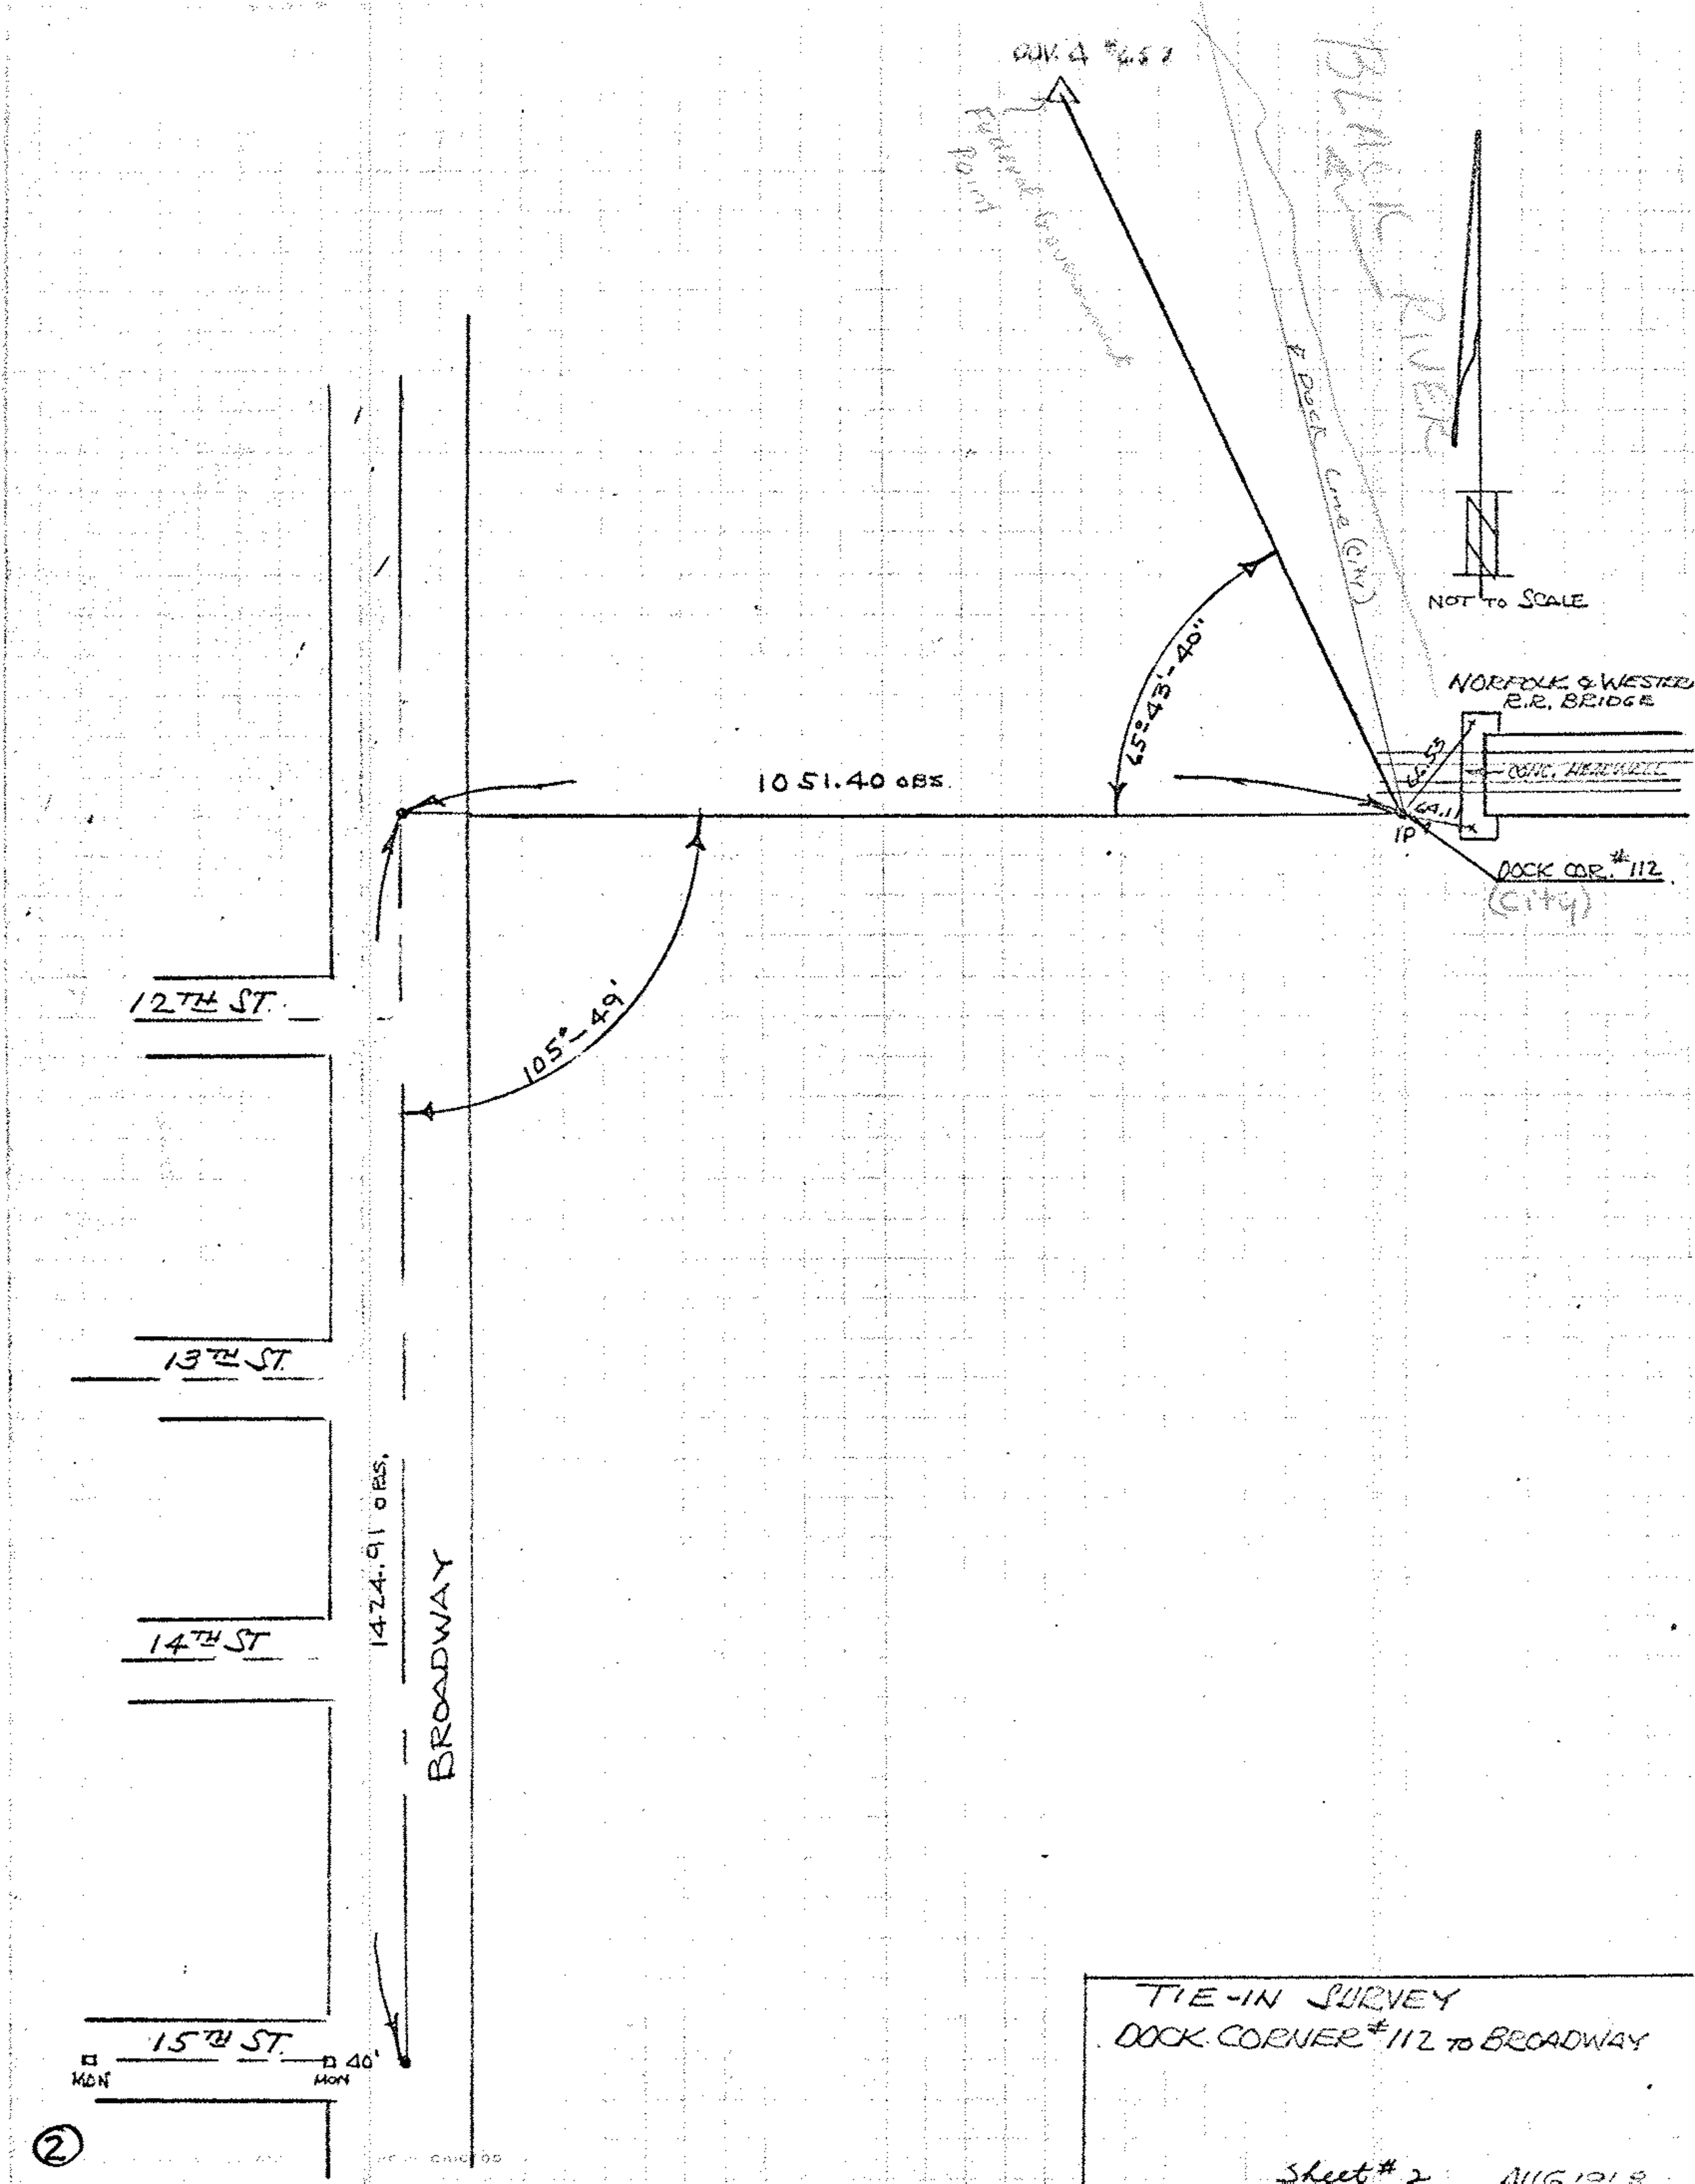

TIE-IN SURVEY
DOCK CORNER #112 to BROADWAY

Sheet # 2 AUG 1914