

①


CHICAGO

N 5th
N 5th

W. ERIE

BROADWAY

TIE-IN JUREVEY
E.W. STONE TO BROADWAY
AT BASCULE BRIDGE

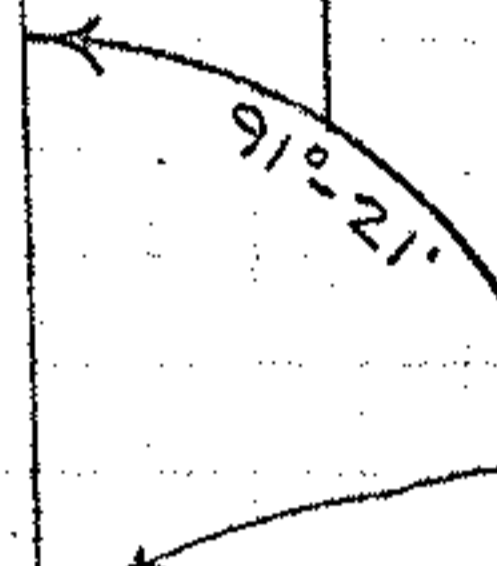


557.33

WEST LANES

230.63

EAST LANES

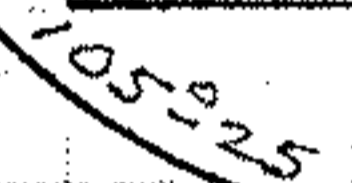

NOT TO SCALE

BASCULE BRIDGE

MARKERS USED

559 # 4-103

02-01-005-102

2-01-004-A

Sheet 1

AKS 19/18