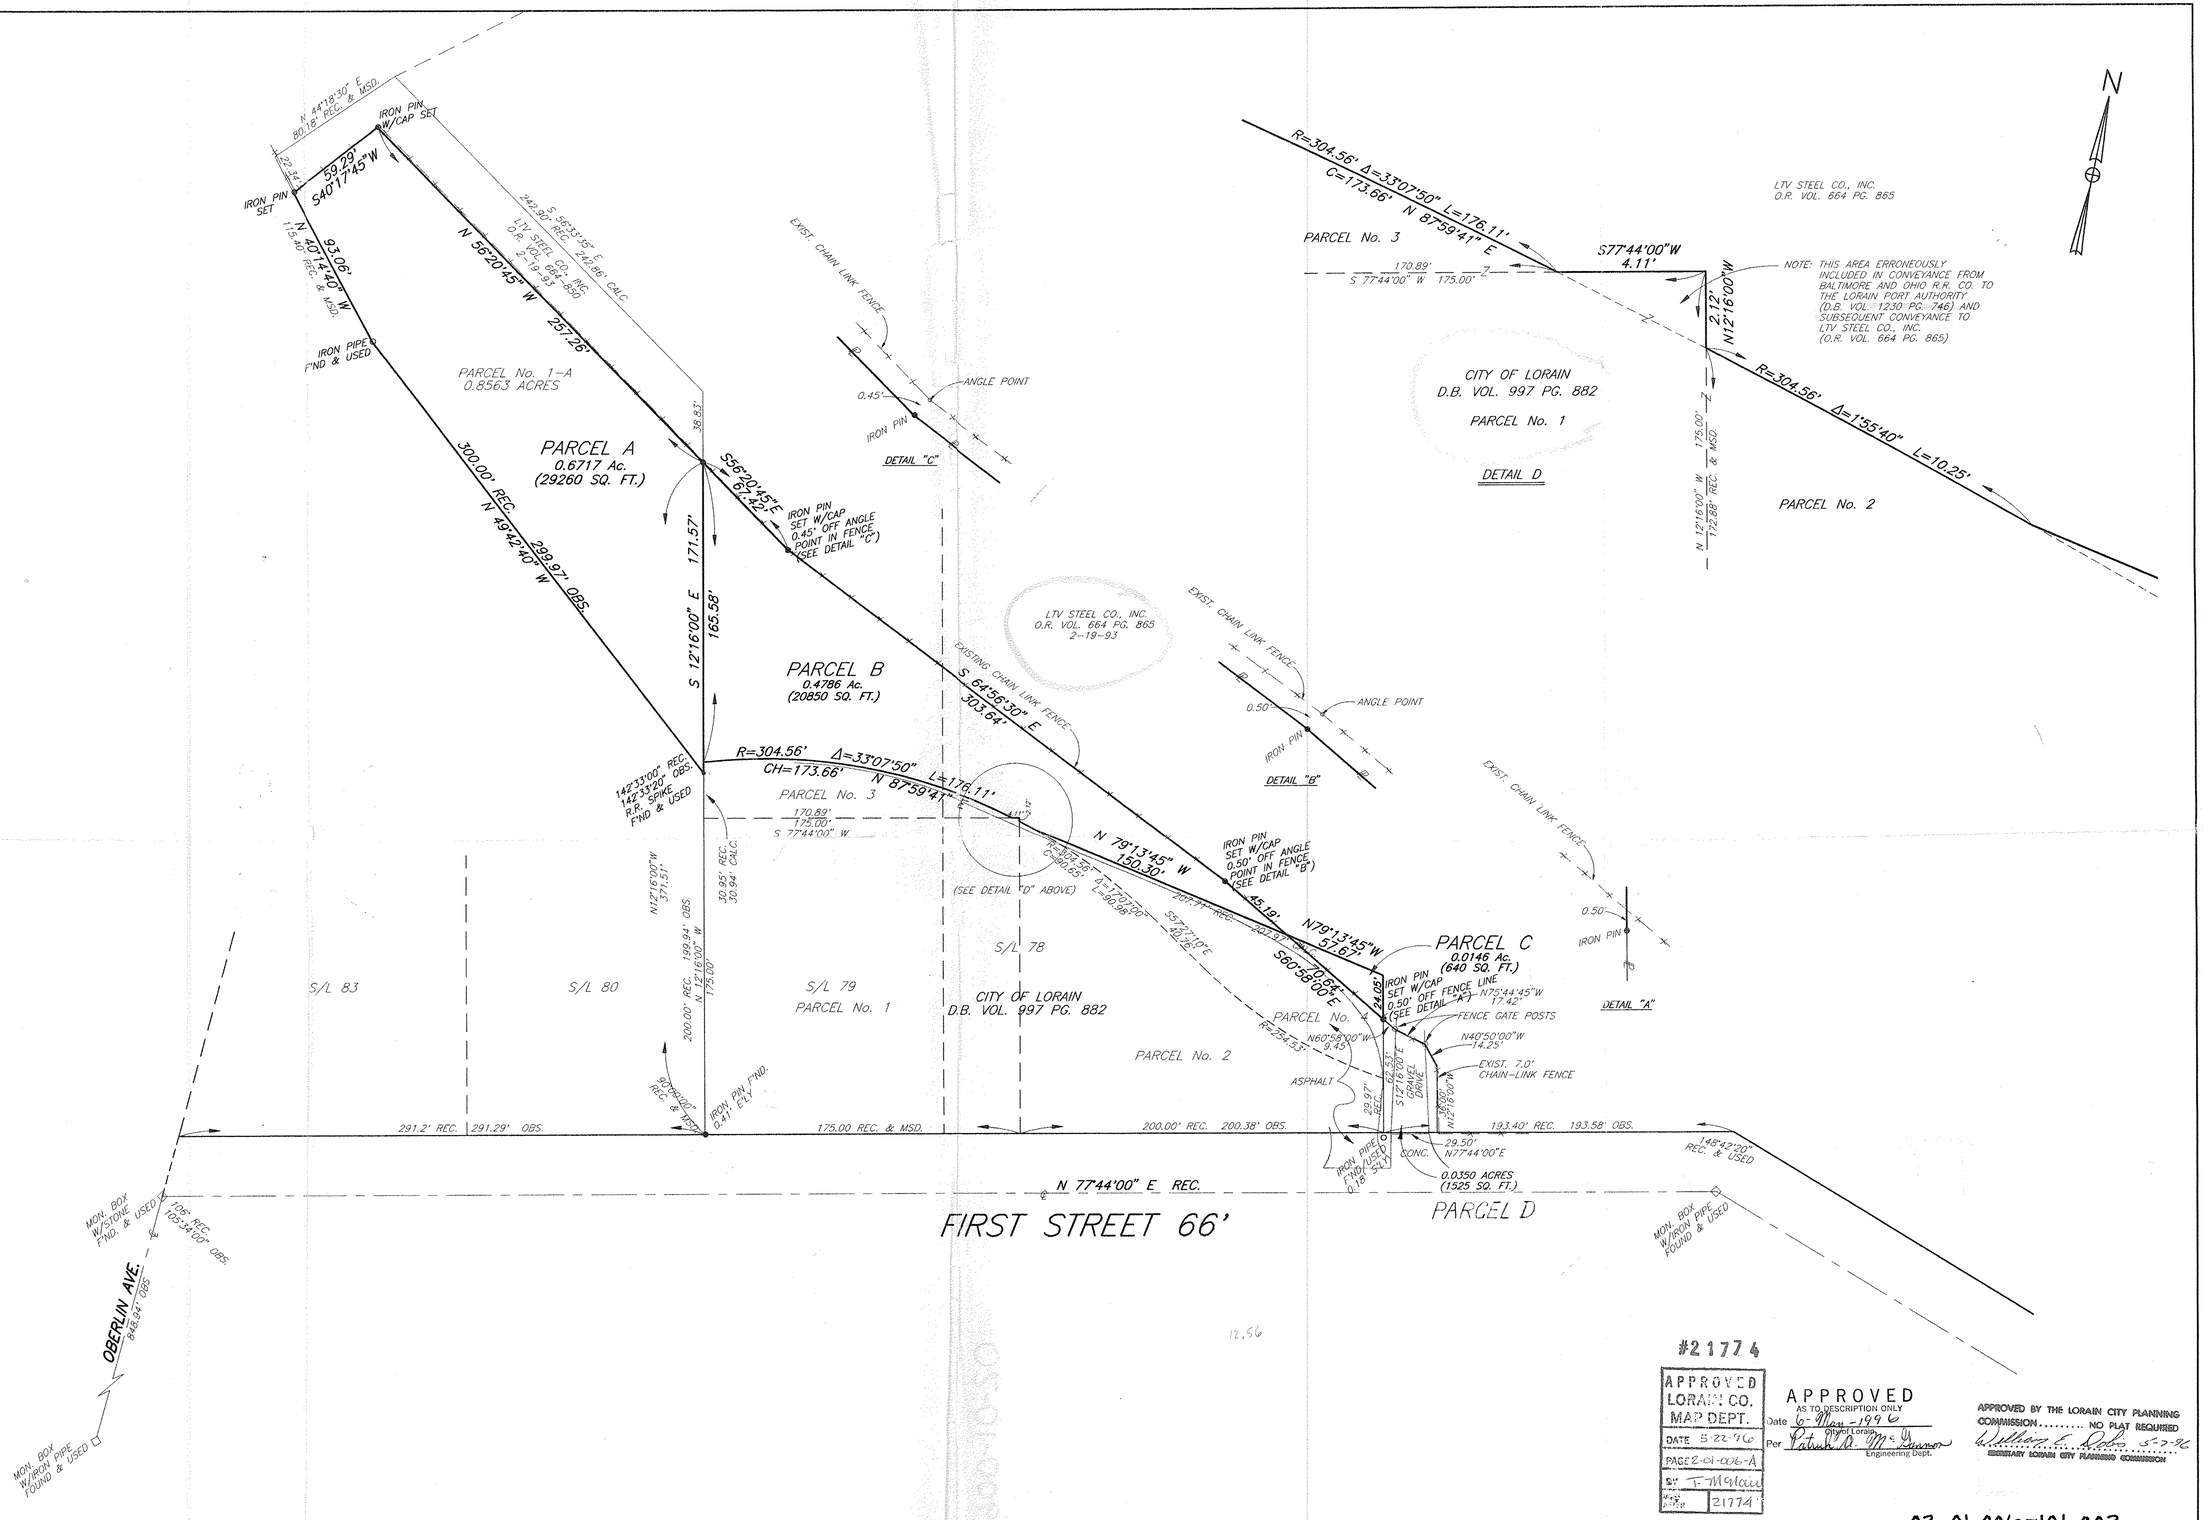

#21774

APPROVED
LORAIN CO.
MAP DEPT.
DATE 5-22-96
PAGE 2-01-006-A
BY T. Malaw
MAP & PARCEL 21774

APPROVED
AS TO DESCRIPTION ONLY
City of Lorain
Per Patrick R. McGannon
Engineering Dept.

APPROVED BY THE LORAIN CITY PLANNING COMMISSION ..... NO PLAT REQUIRED
William C. Dibb 5-7-96
SECRETARY LORAIN CITY PLANNING COMMISSION

02-01-006-101-003

02-01-006

COPYRIGHT — DATE: 02-19-96 08:28, CT CONSULTANTS INC. C:\93288\93288-1.DWG

CT Consultants, Inc.
Engineers • Architects • Planners
Willoughby • Mentor • Columbus • North Canton • Youngstown

REV. NO.	DESCRIPTION	DATE	BY	CH'K'D.

DATE: 2-16-96
DRAWN BY: J. LANE
CHECKED BY: T.P.H.
APPROVED BY:
F.B. No. 985 PG. 19

PLAT OF SURVEY
FOR
THE CITY OF LORAIN
IN ORIGINAL TOWN PLAT OF CHARLESTON
VOL. J. PAGE 446 LORAIN COUNTY PLAT RECORDS
CITY OF LORAIN, COUNTY OF LORAIN, STATE OF OHIO

SCALE
HOR. 1" = 40'
VERT.
CONTRACT No. 93288
SHEET NO. 1 OF 1