02-01-006 - 120-02-48

MAP OF SUB-LOT NO. 66

E. R. PERKIN'S TRUSTEES ADD'N. VOL. 7 PG. 21
ORIG. LOT 6 - TRACT NO. 1 - BLACK RIVER TWP.
LORAIN CITY - LORAIN COUNTY - OHIO
SCALE: 1" = 30' OCT. 8 - 1969 10:45 A.M.
NOTE: There are no encroachments on this property.
Gary E. Penfound REG. SURVEYOR NO. 4457

CITY TITLE Co. Order No. E-874-5
Rudolph J. & Patricia A. Paulik
to Thomas O. & Rozella Miller

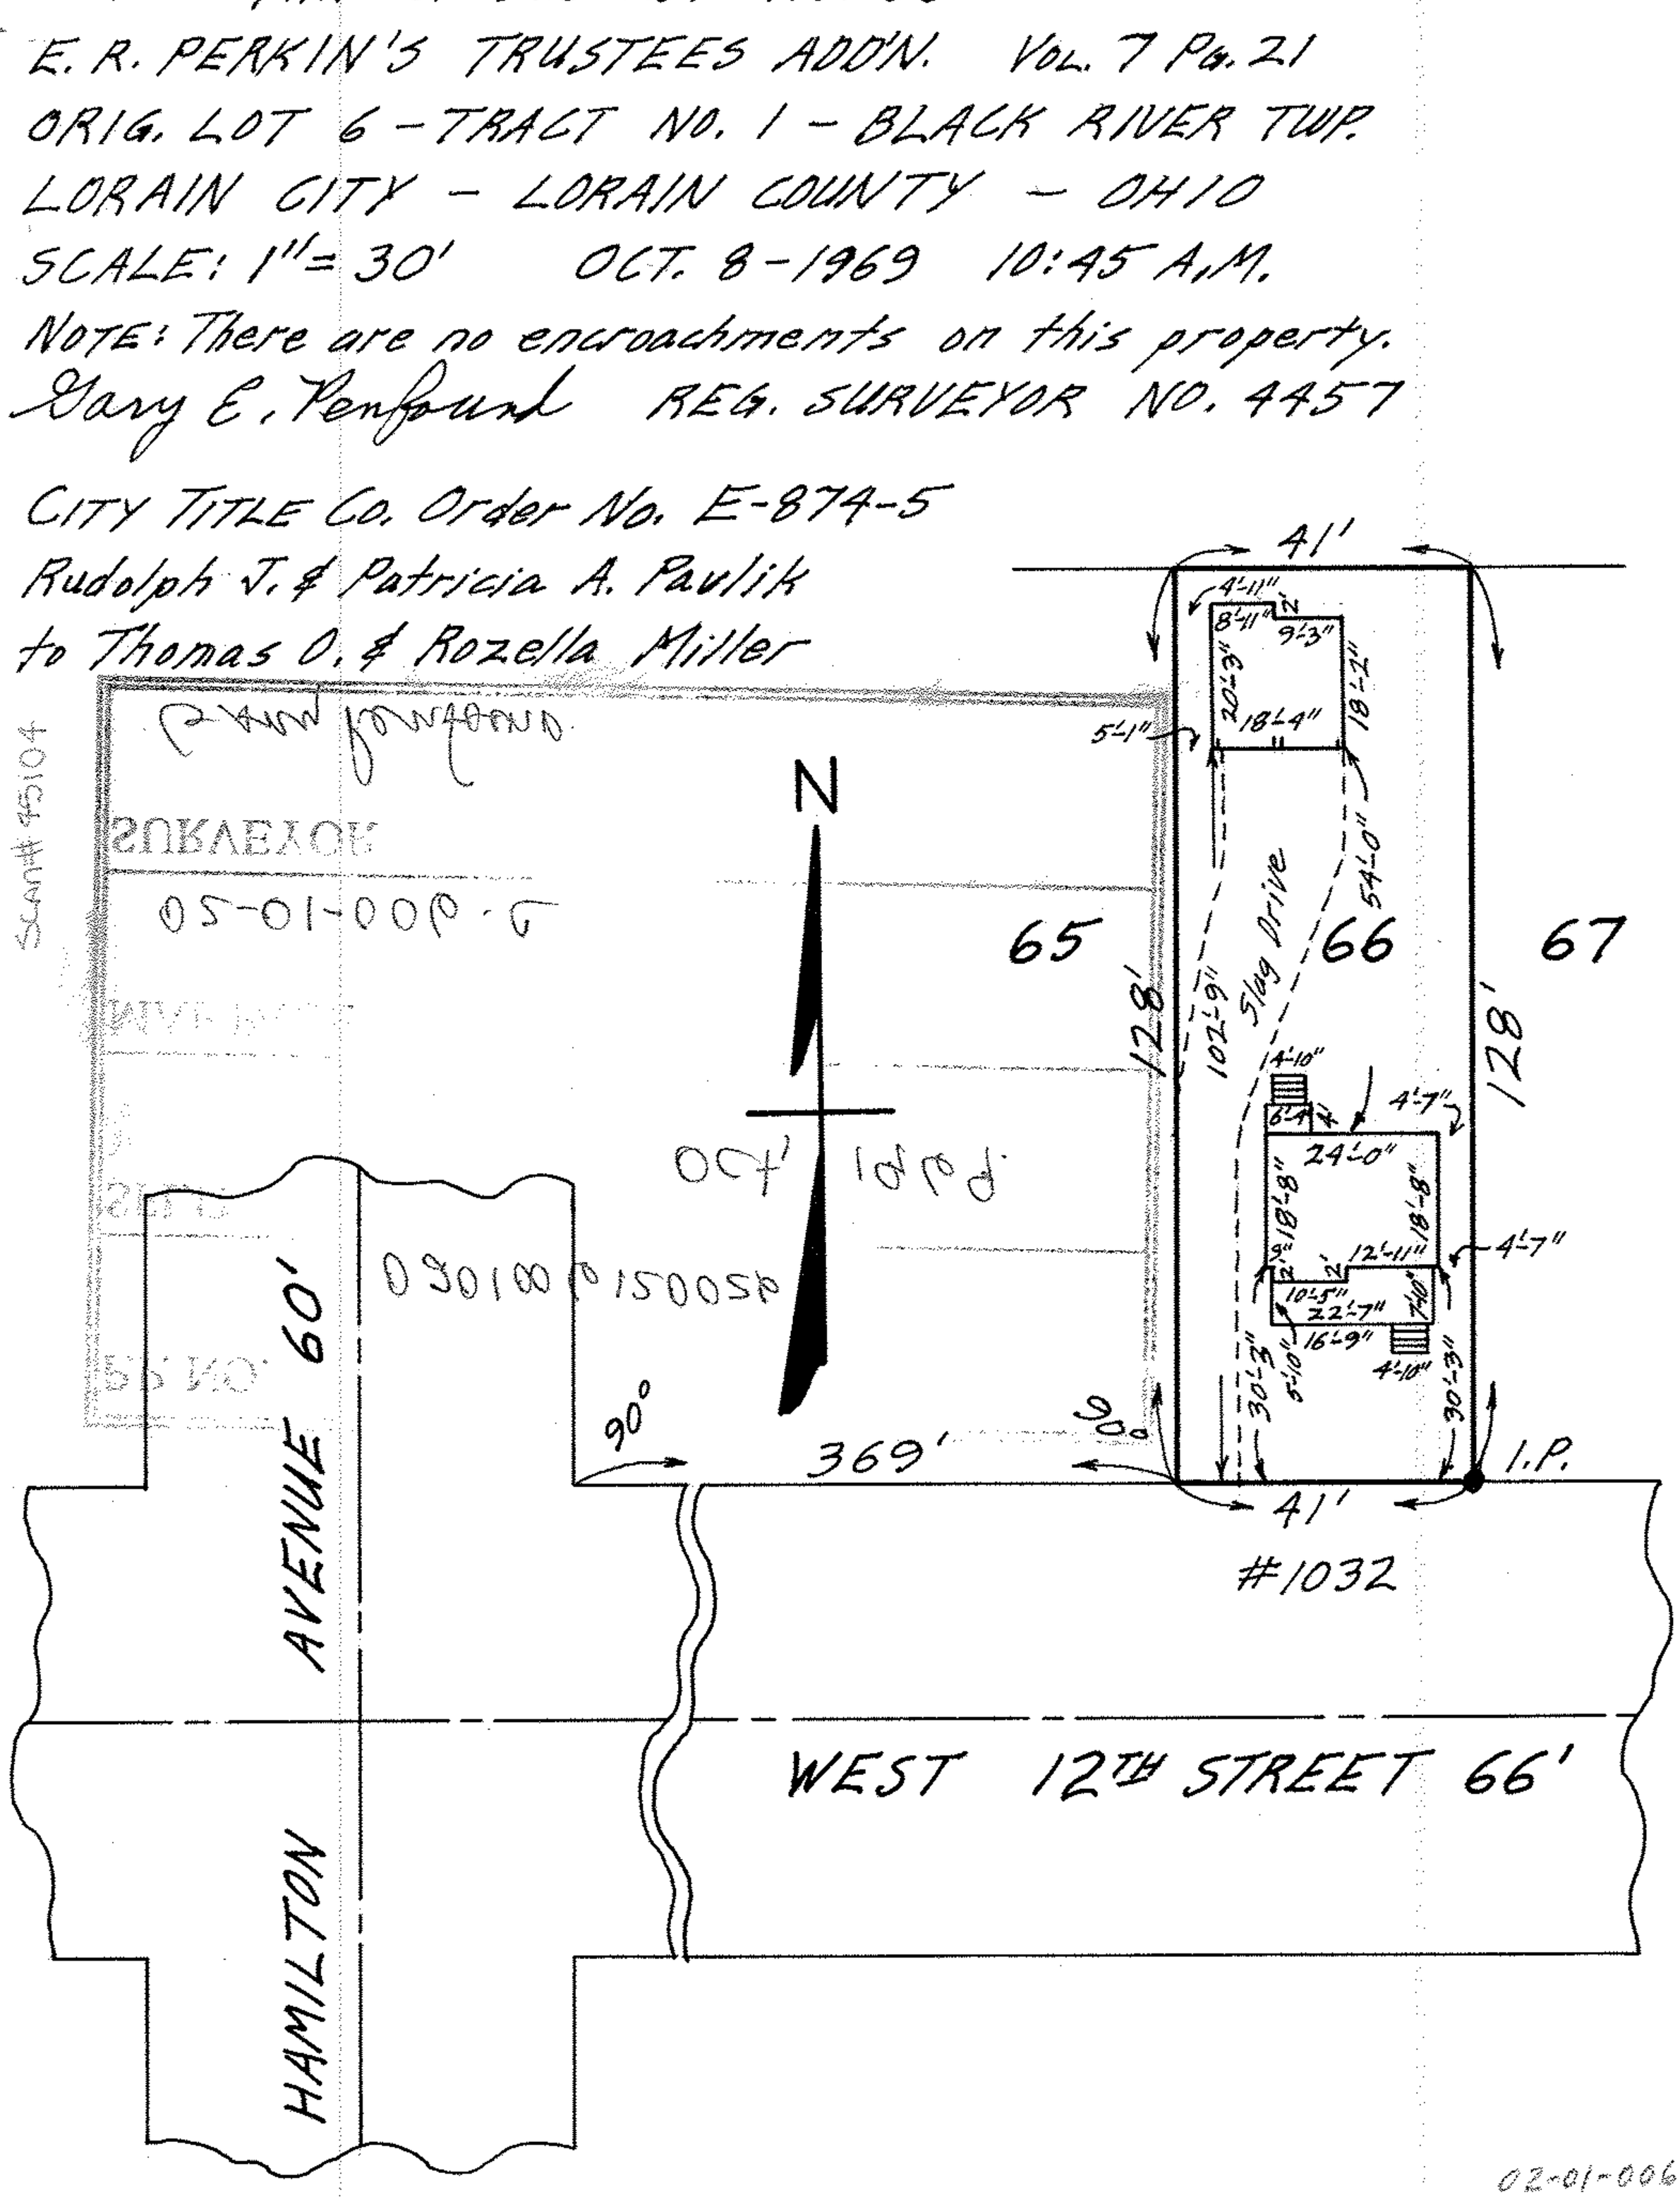

02-01-006