

# HAPONEK & ASSOCIATES, INC. Engineers & Surveyors

34100 Center Ridge Road • NORTH RIDGEVILLE, OHIO 44039 • (216) 327-4776 • Lorain 288-4400

## SURVEY OF SUBLOTS 17, 18, 14 & VACATED ALLEY IN J.B. HOGES ADDN.

CITY OF LORAIN


COUNTY OF LORAIN

STATE OF OHIO

PREPARED FOR:

ROGER MILLARD  
1116 W. 17<sup>th</sup> ST.  
LORAIN, OH.  
244-1150

DATE: FEB. 1998  
SCALE: 1" = 40'

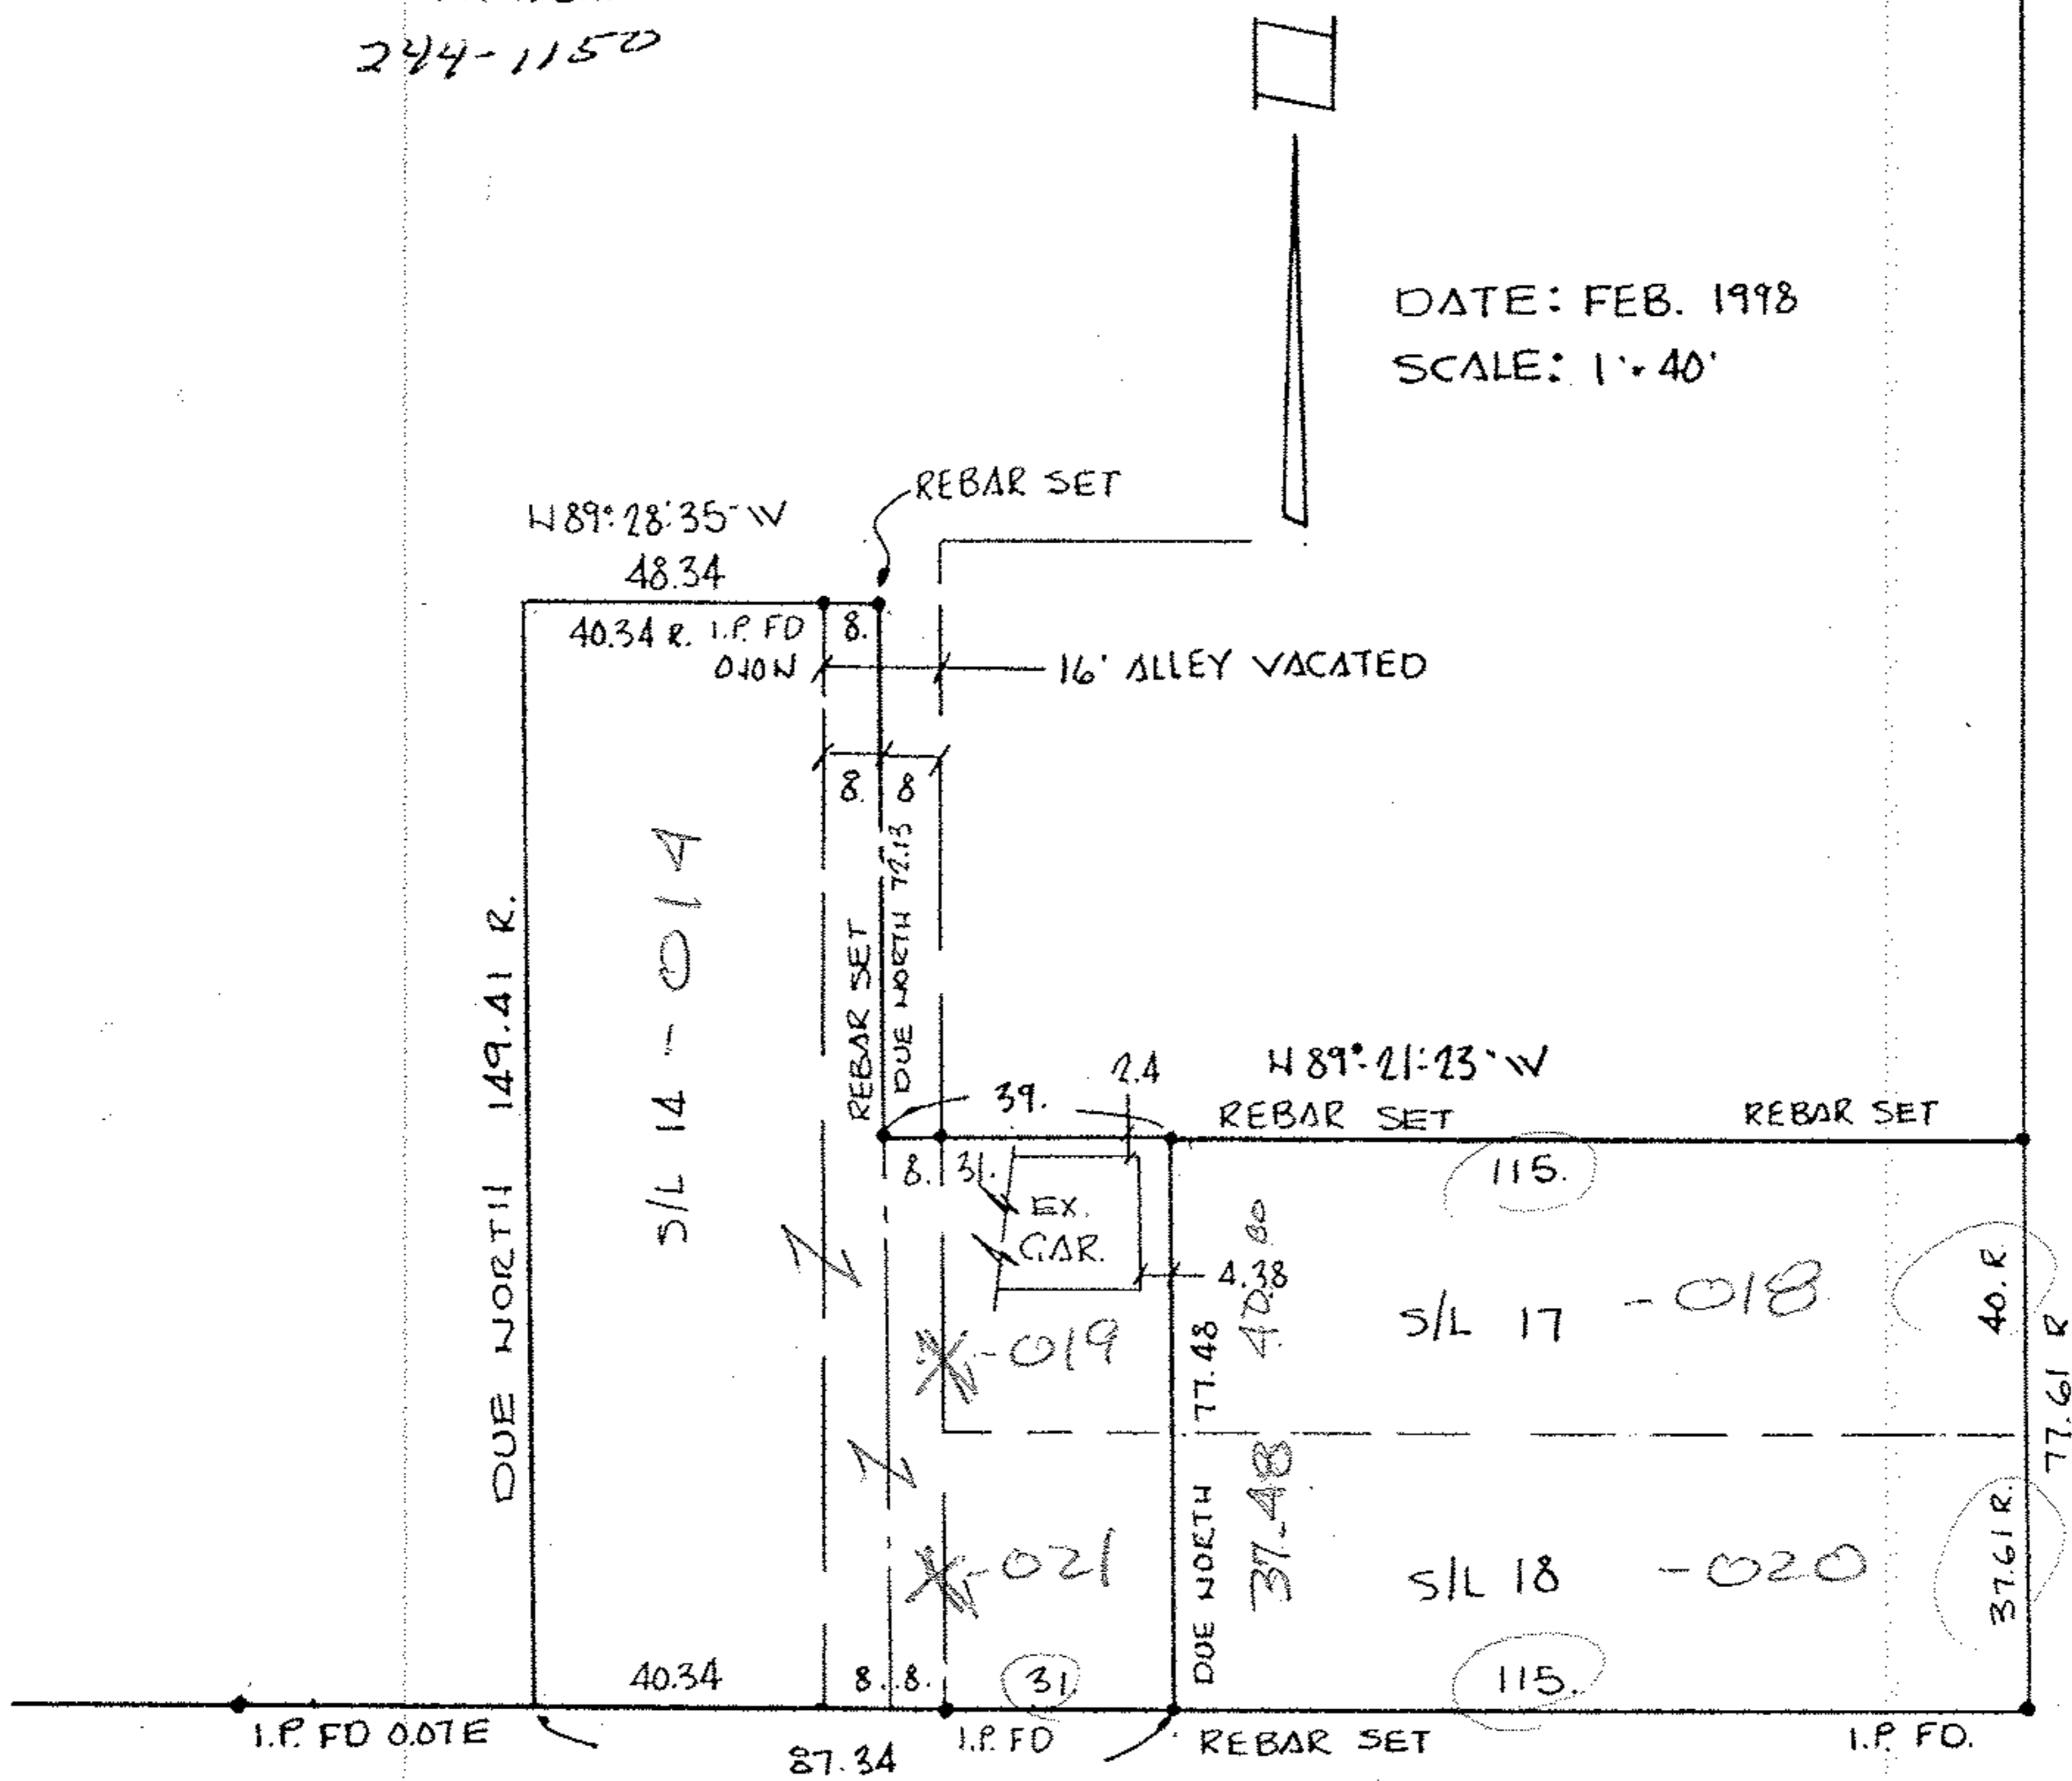

HAMILTON 60' DUE NORTH  
AVE.

02-01-006-C  
SCAN # 45105  
02-01-006-131-018 thru -020

APPROVED BY THE LORAIN CITY PLANNING COMMISSION ..... NO PLAT REQUIRED

*William C. Dobis* 4-2-98


SECRETARY LORAIN CITY PLANNING COMMISSION

WEST 17<sup>th</sup> ST. 60'

**APPROVED**  
AS TO DESCRIPTION ONLY

Date March 20 1998

Per Kimberly Hoskin  
Engineer-in-Chief

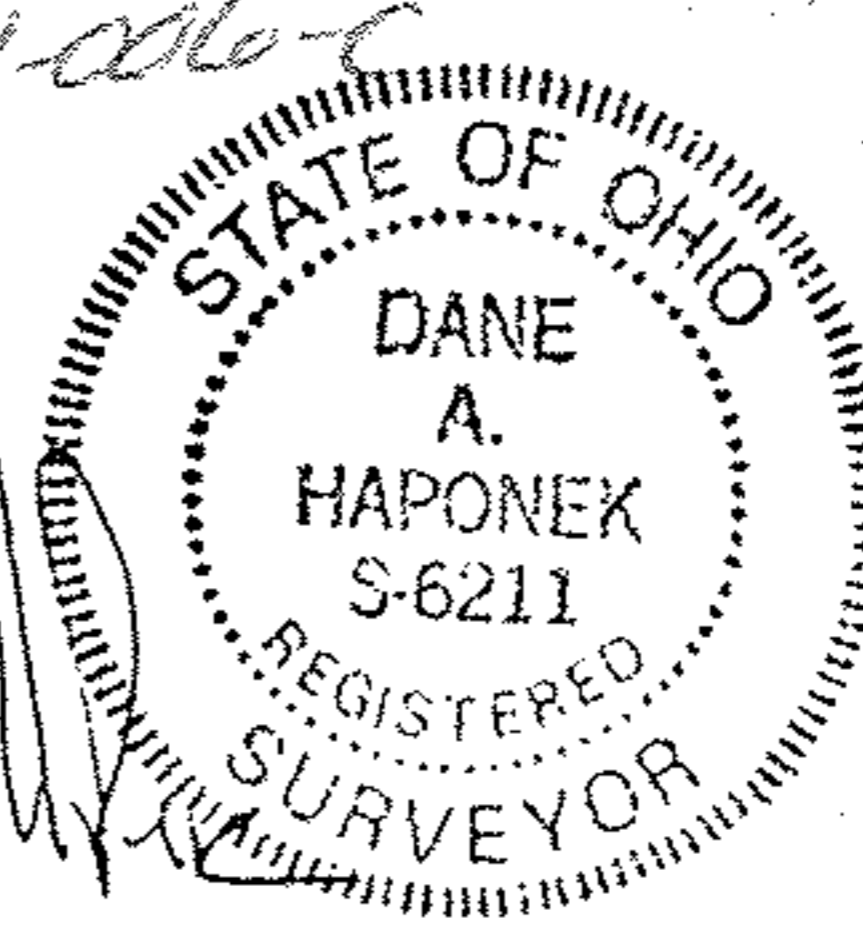

#22540

APPROVED LORAIN CO. MAP DEPT.	
DATE	6/2/98
PAGE	2-01-006-C
BY	TJS
NO.	22540