02-01-006 & 193-009

02-01-006-A

Scan # 45111

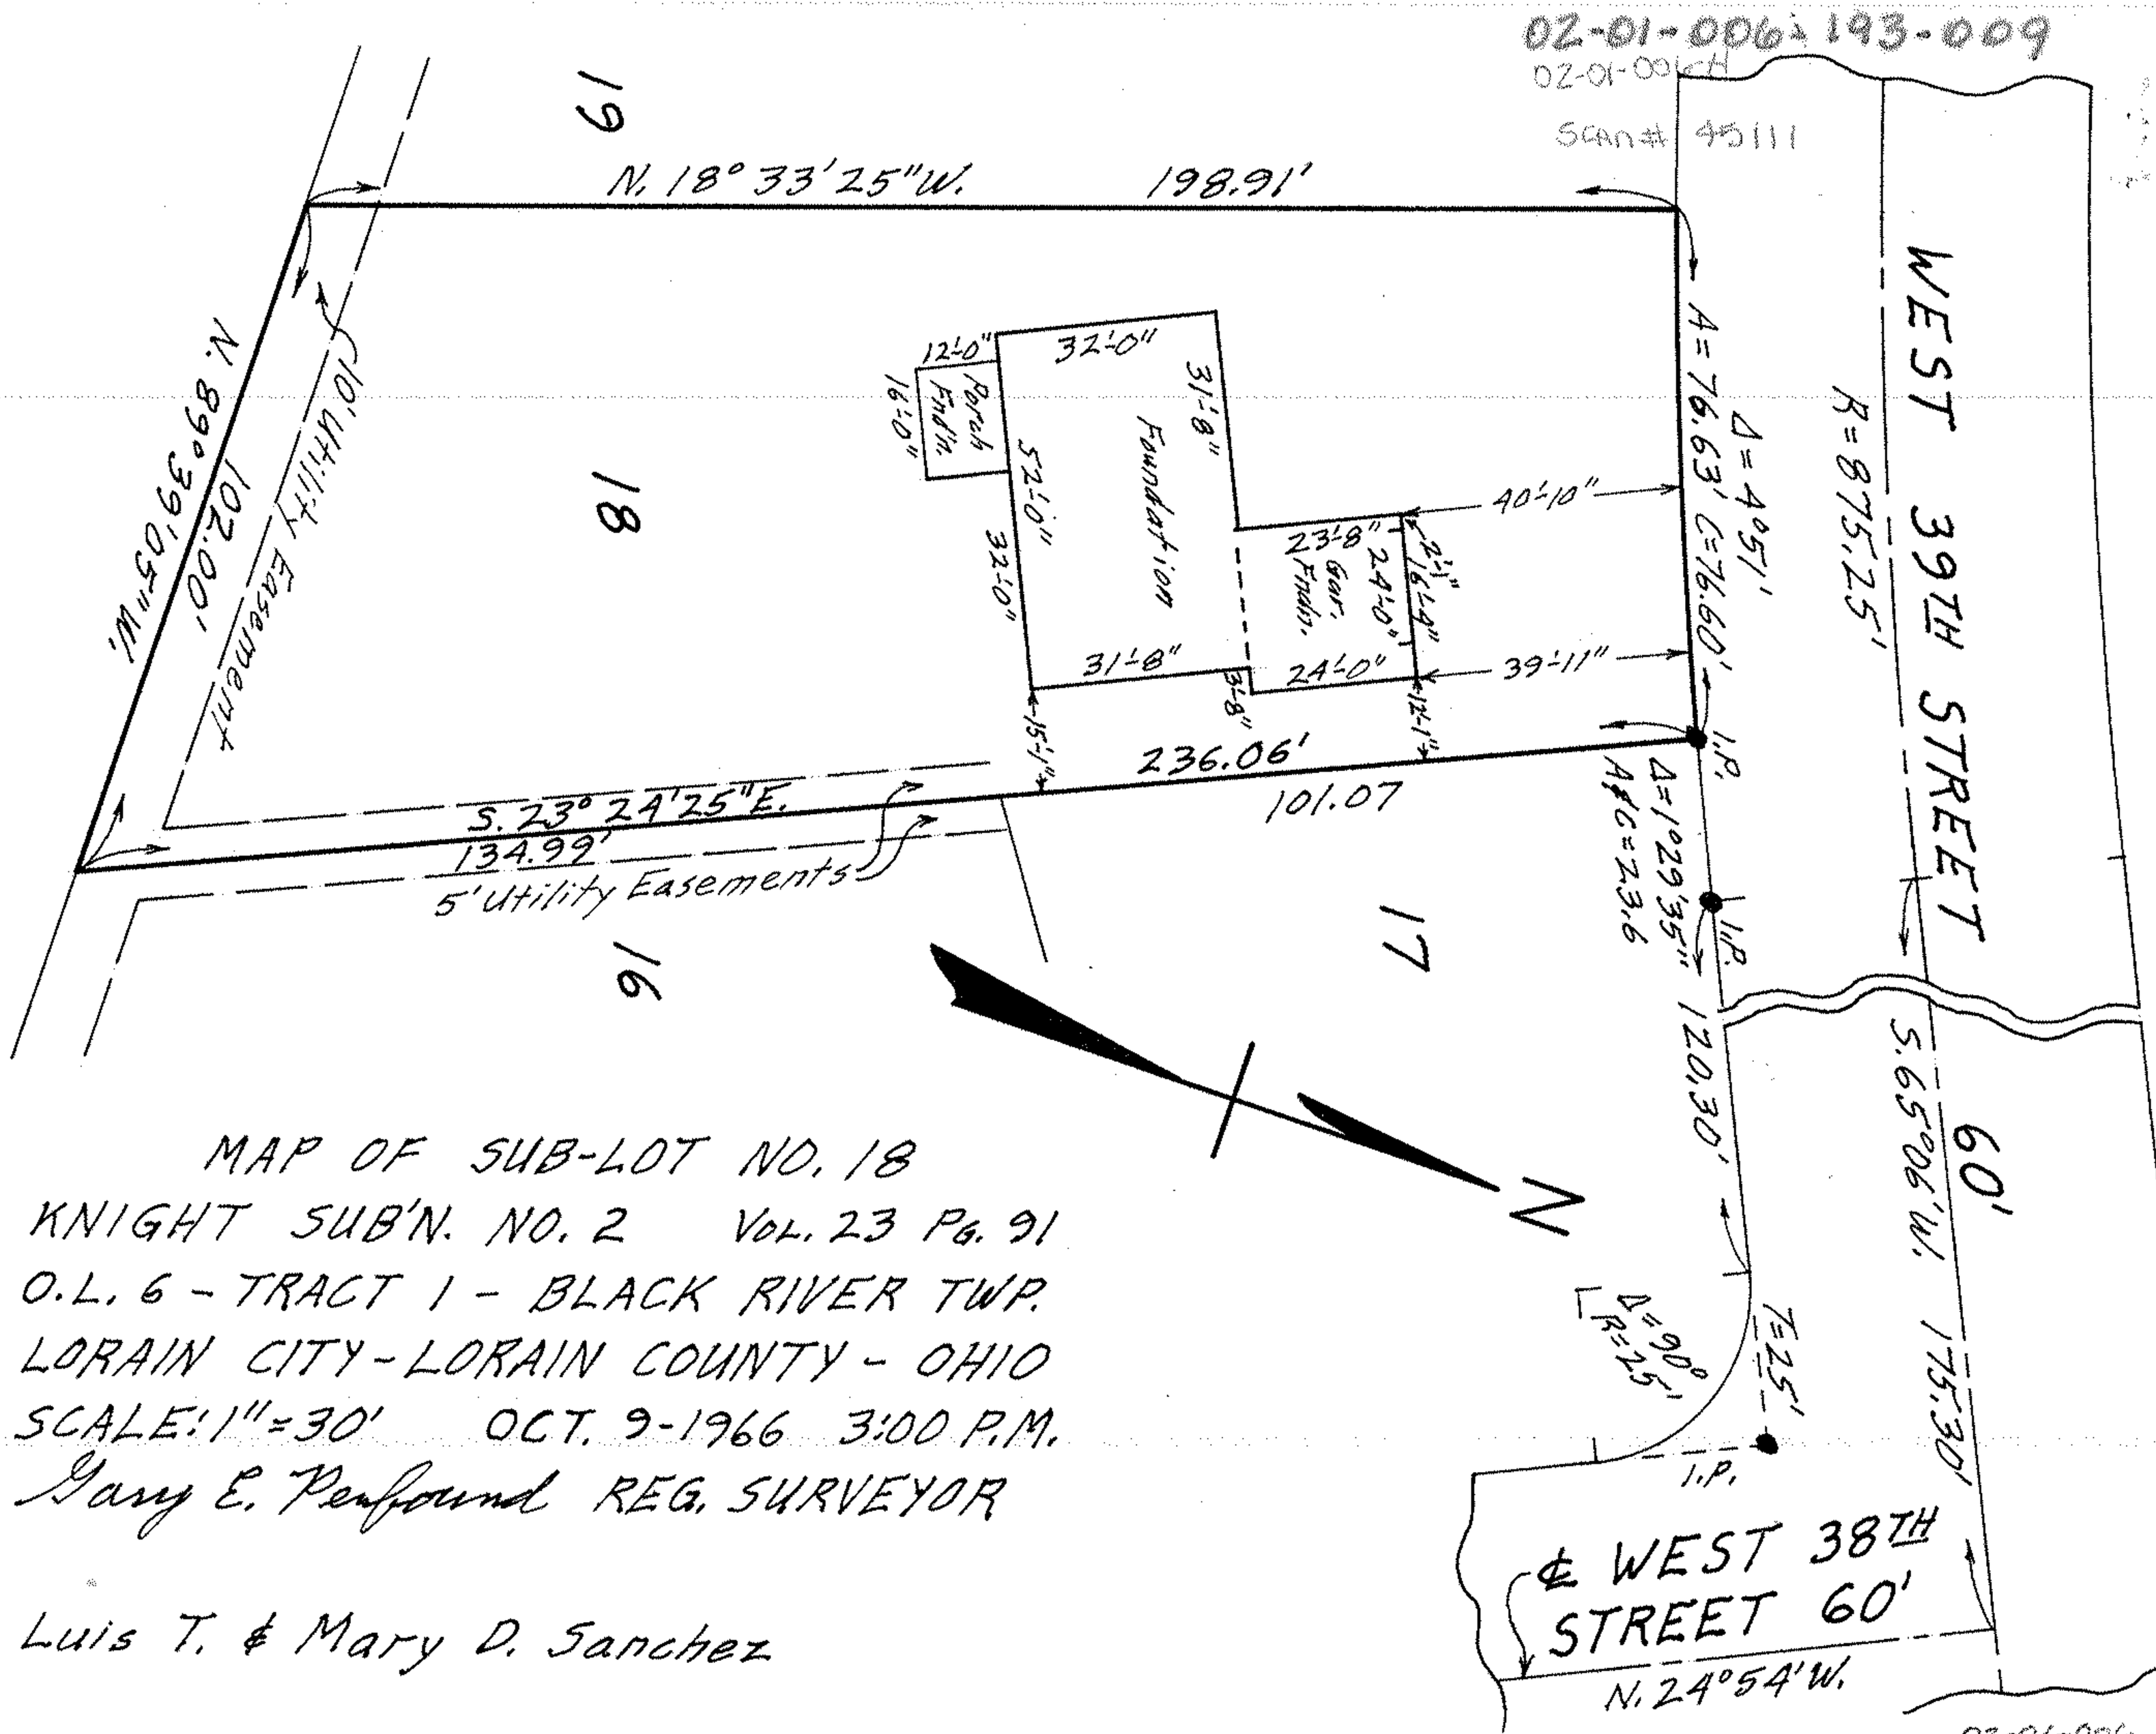

MAP OF SUB-LOT NO. 18
KNIGHT SUB'N. NO. 2 VOL. 23 PG. 91
O.L. 6 - TRACT 1 - BLACK RIVER TWP.
LORAIN CITY - LORAIN COUNTY - OHIO
SCALE: 1" = 30' OCT. 9-1966 3:00 P.M.
Gary E. Penfound REG. SURVEYOR

Luis T. & Mary D. Sanchez

02-01-006