02-01-006-194-012
02-01-006-H Scan#95113

MAP OF SUB-LOT NO. 21

KNIGHT SUB'N. NO. 2 Vol. 23 Pg. 91
ORIG. LOT 6 - TRACT 1 - BLACK RIVER TWP.
LORAIN CITY - LORAIN COUNTY - OHIO
SCALE: 1" = 30' OCT. 2-1965 10:30 A.M.
Gary E. Penfound REG. SURVEYOR

Order No. 1273
WHALEN, Robert J. & Geraldine

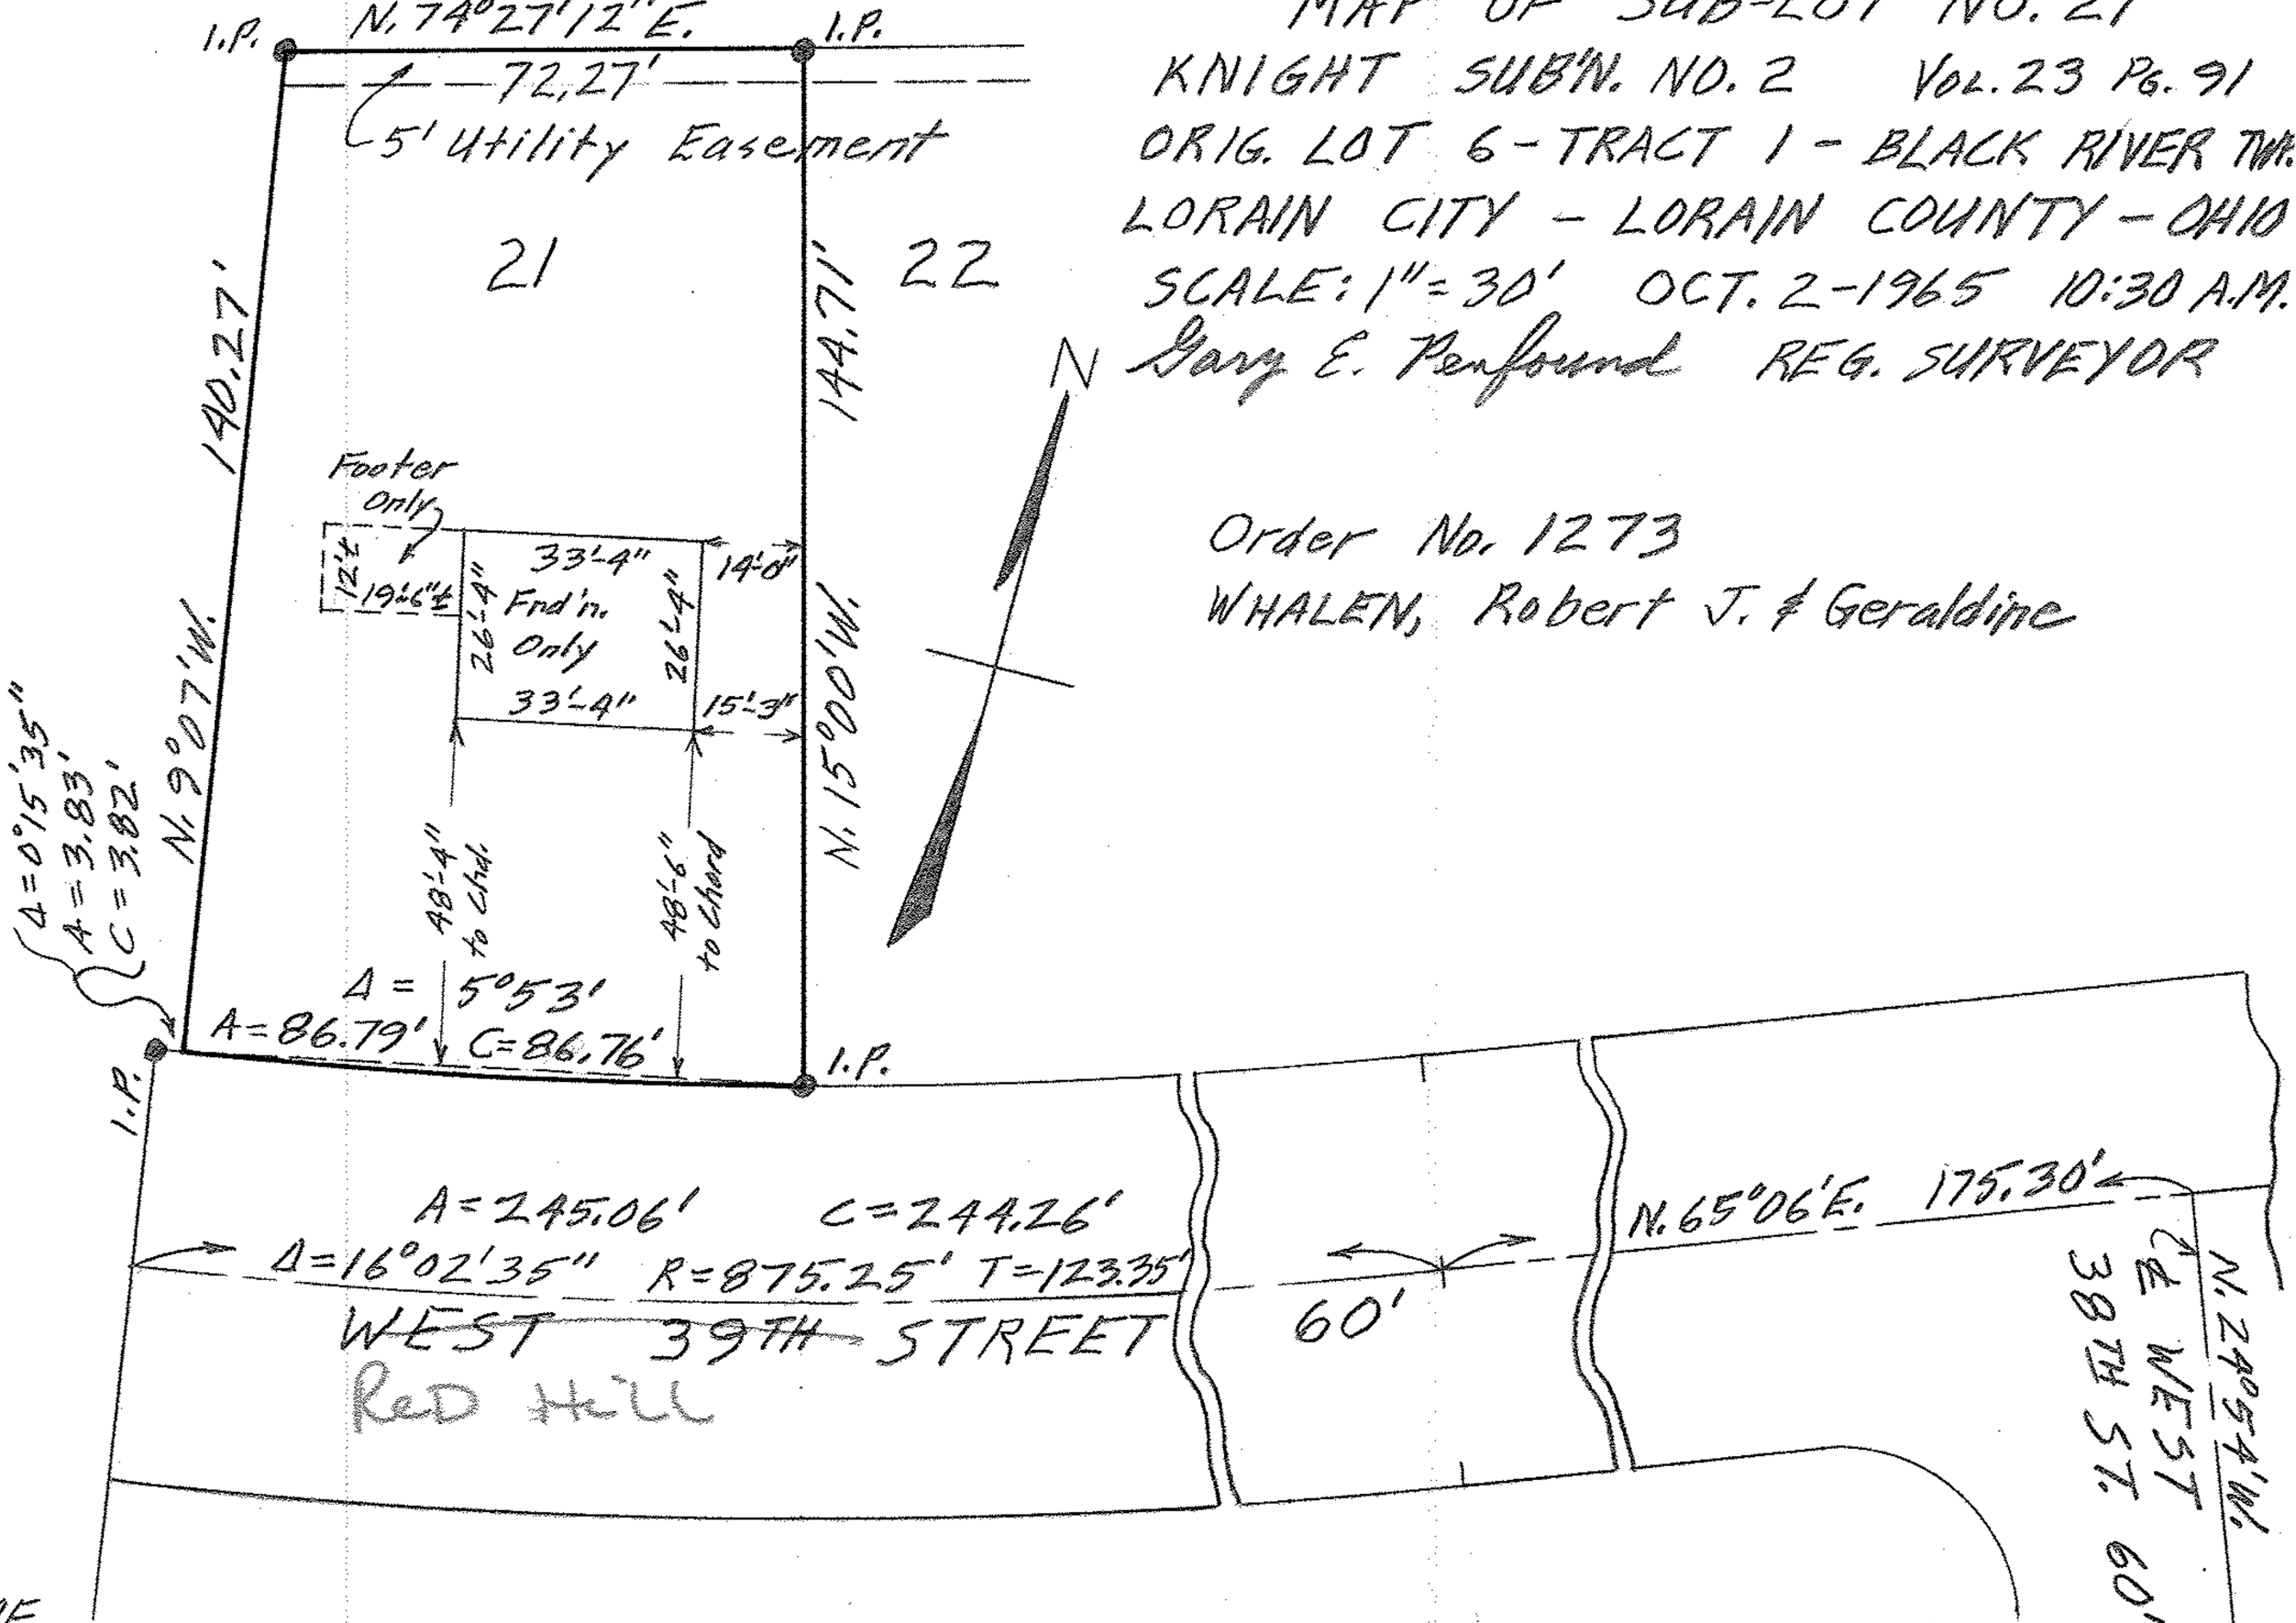

MF

02-01-006