02-01-006-194.014
02-01-006 H Scan#45114

MAP OF SUB-LOT NO. 55

KNIGHT SUB'N. NO. 3 VOL. 24 PG. 56
ORIG. LOT 6 - TRACT 1 - BLACK RIVER TWP.
LORAIN CITY - LORAIN COUNTY - OHIO
SCALE: 1" = 30' NOV. 29-1969 3:30 P.M.
NOTE: There are no encroachments
on this property.
Gary E. Penfound REG. SURVEYOR

Order No. 2050
Arnold & Mildred Belkin

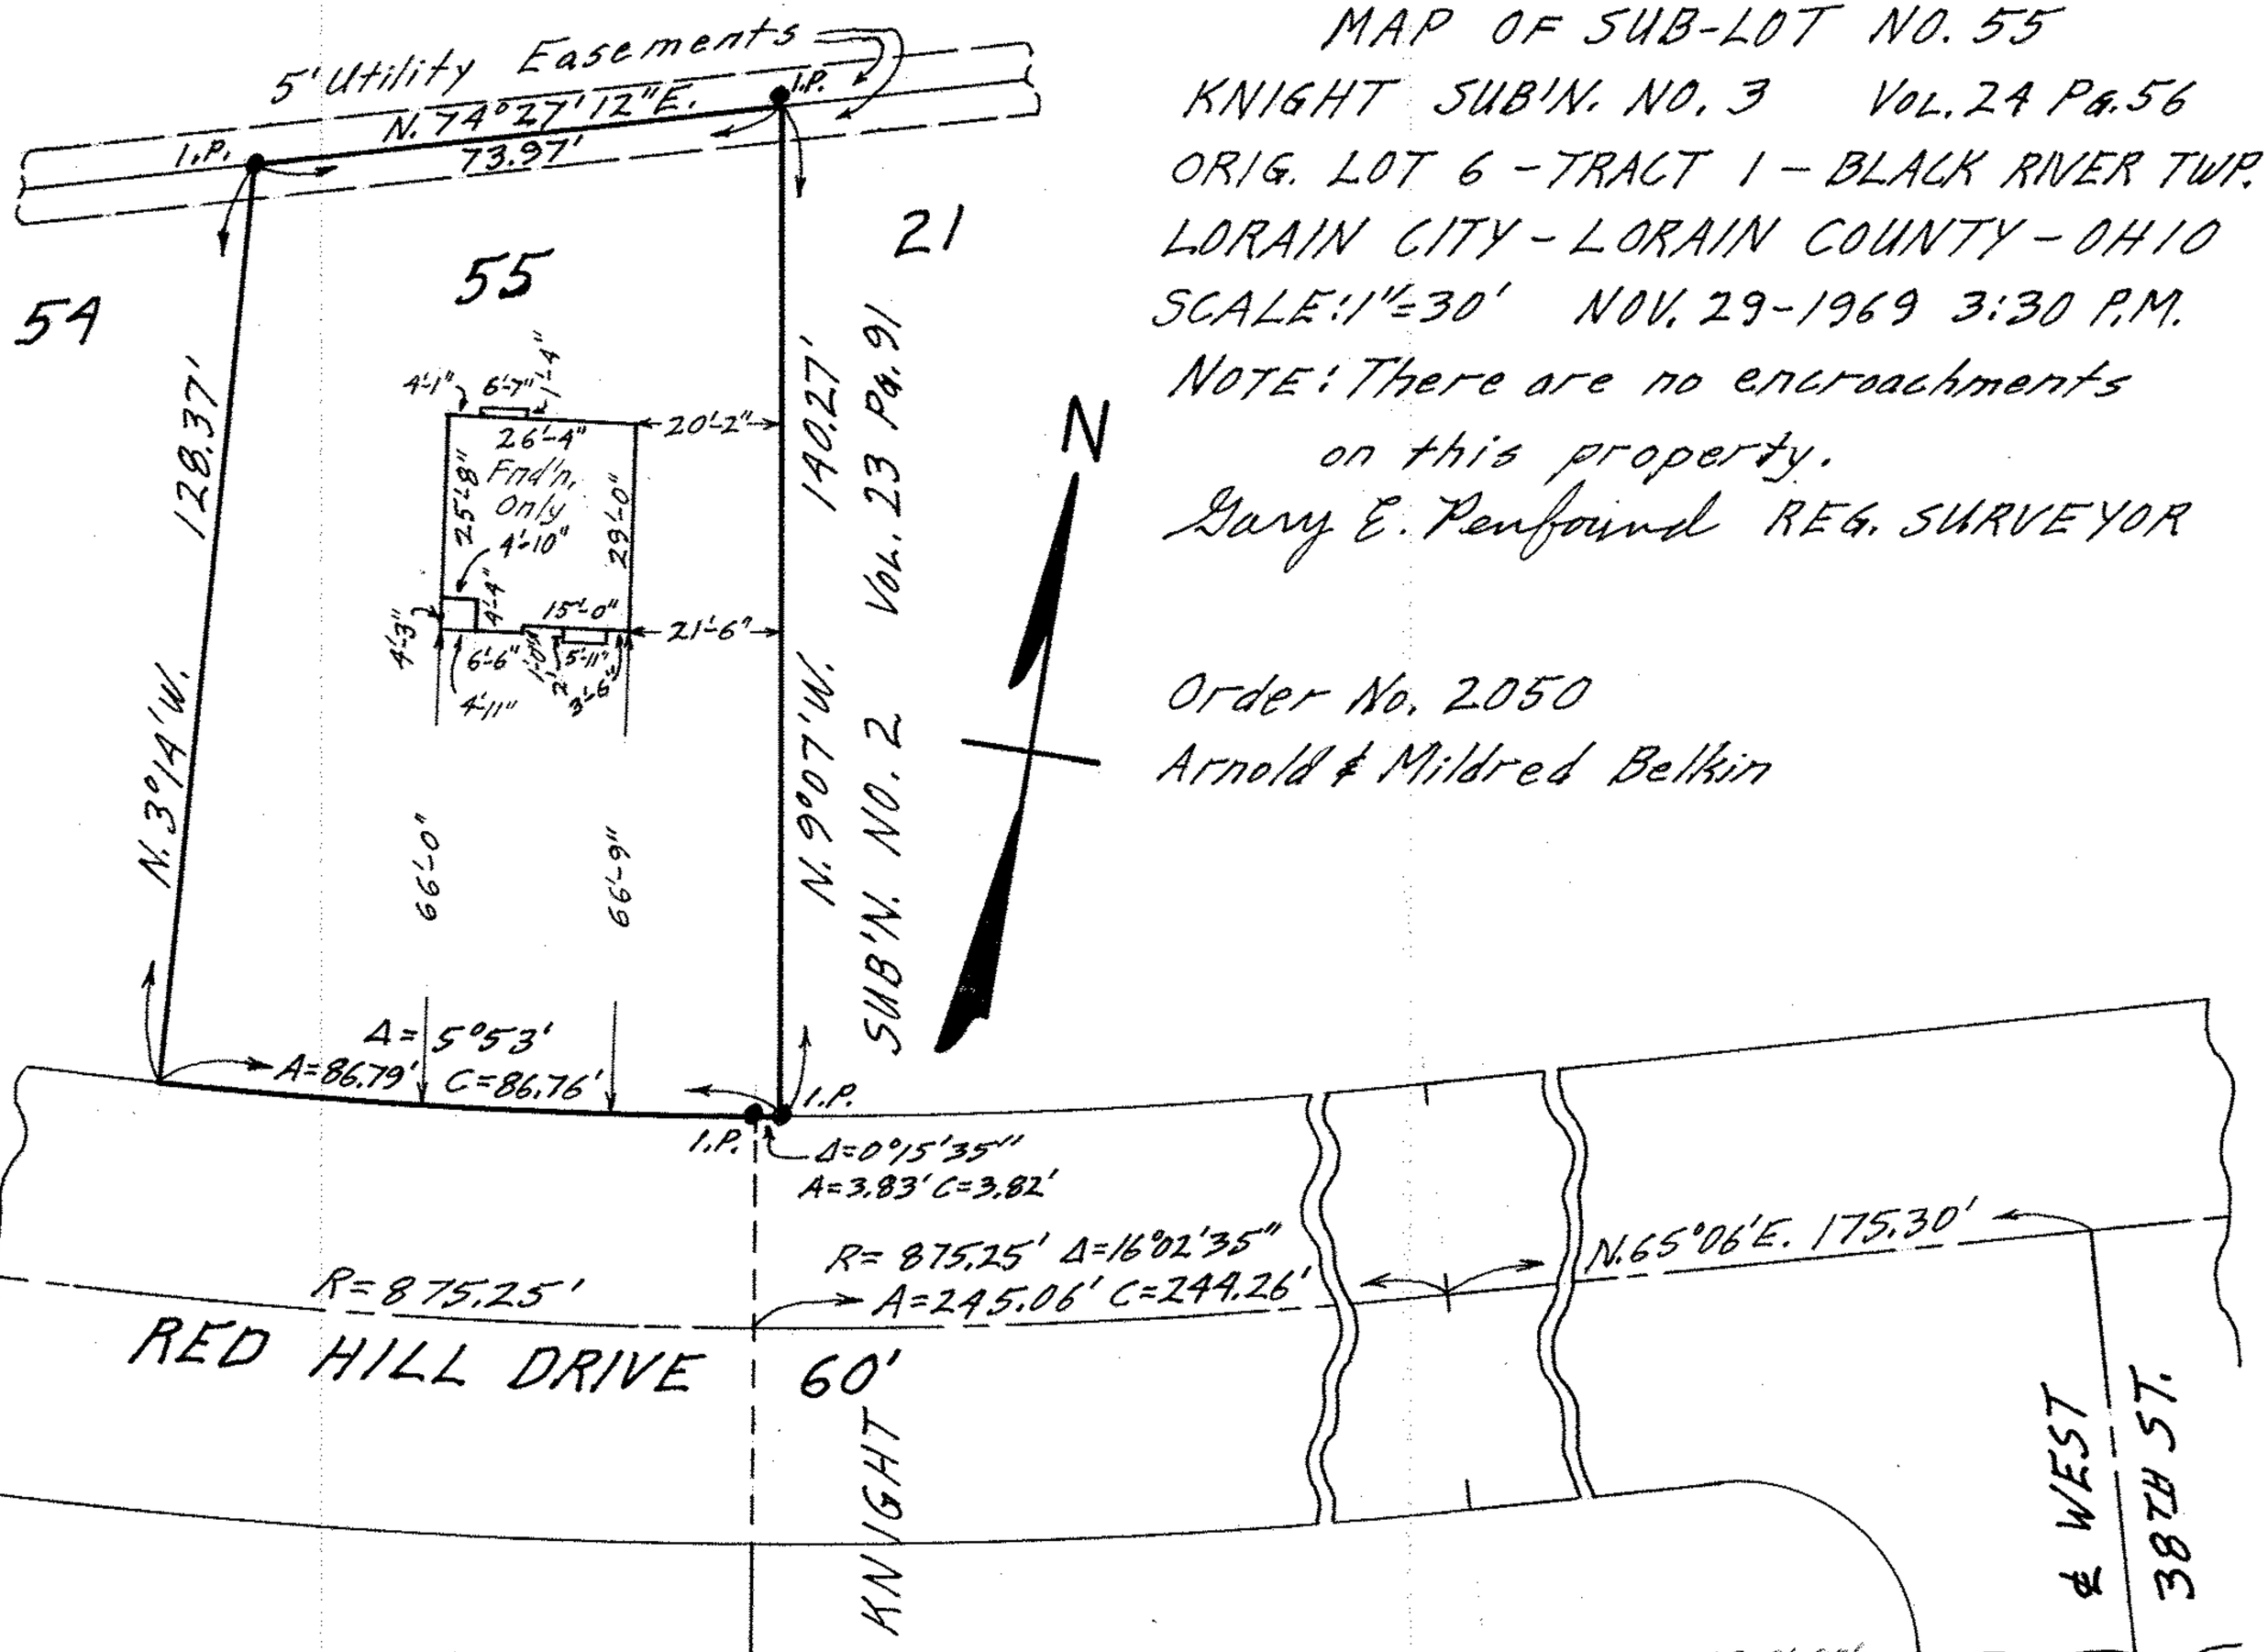

02-01-006