1" = 40'-0"

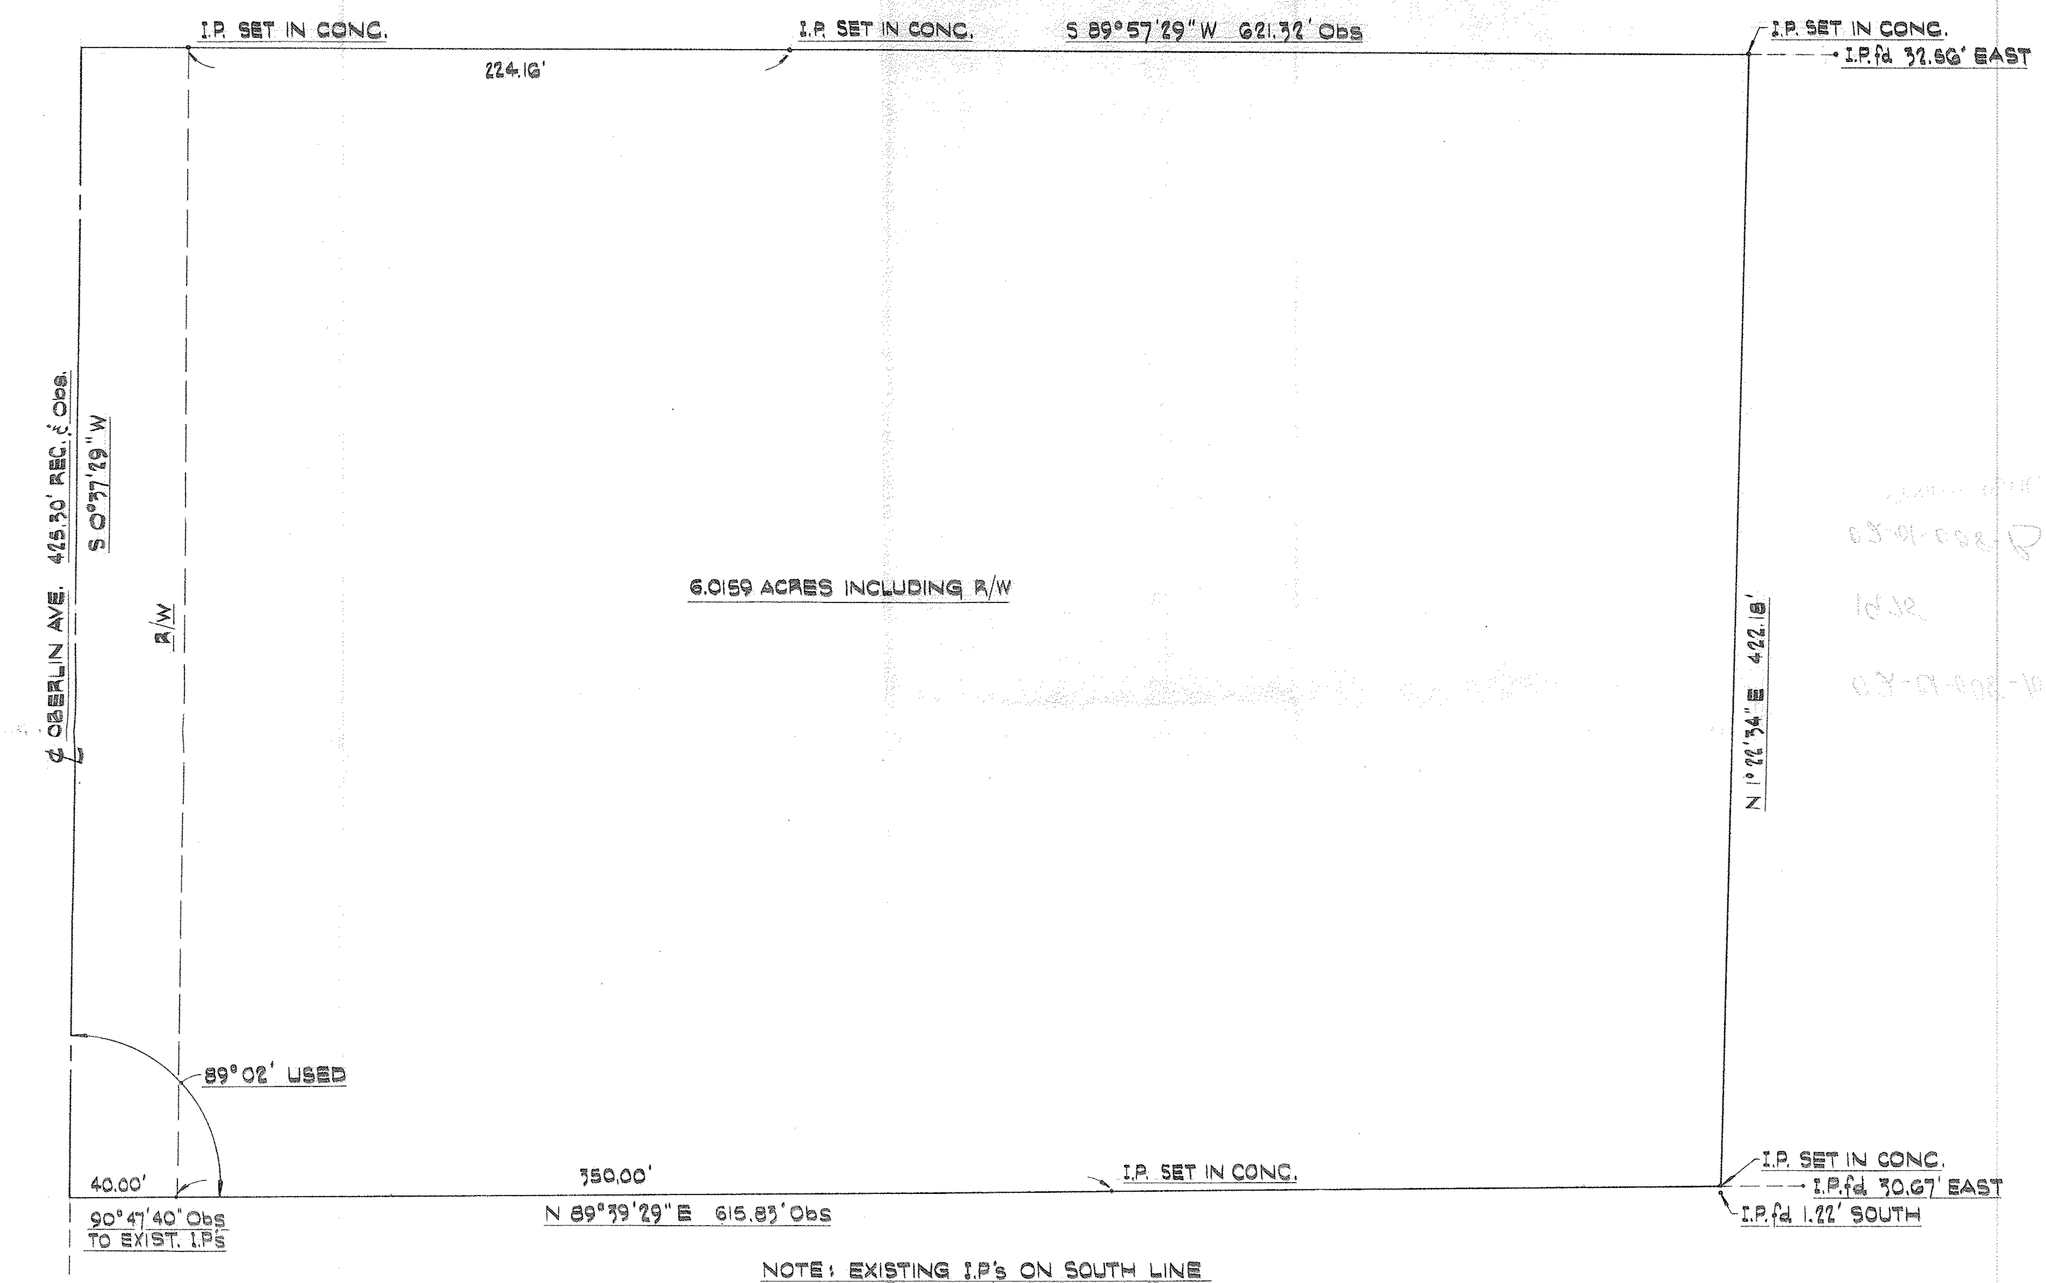

NOTE: EXISTING I.P.'s ON SOUTH LINE
INTERSECT ℄ OBERLIN AVENUE
0.16' SOUTH of THIS SURVEY

STATE OF OHIO
LAWRENCE
V.
McGLINCHY
4970
REGISTERED
SURVEYOR

PLAT of SURVEY FOR KATHERINE MOULAS
4845 OBERLIN RD. LORAIN, OH. 44052

McGLINCHY and ASSOCIATES
538 W. BROAD ST. ELYRIA, OH. 44035
NOVEMBER 1975 #75440