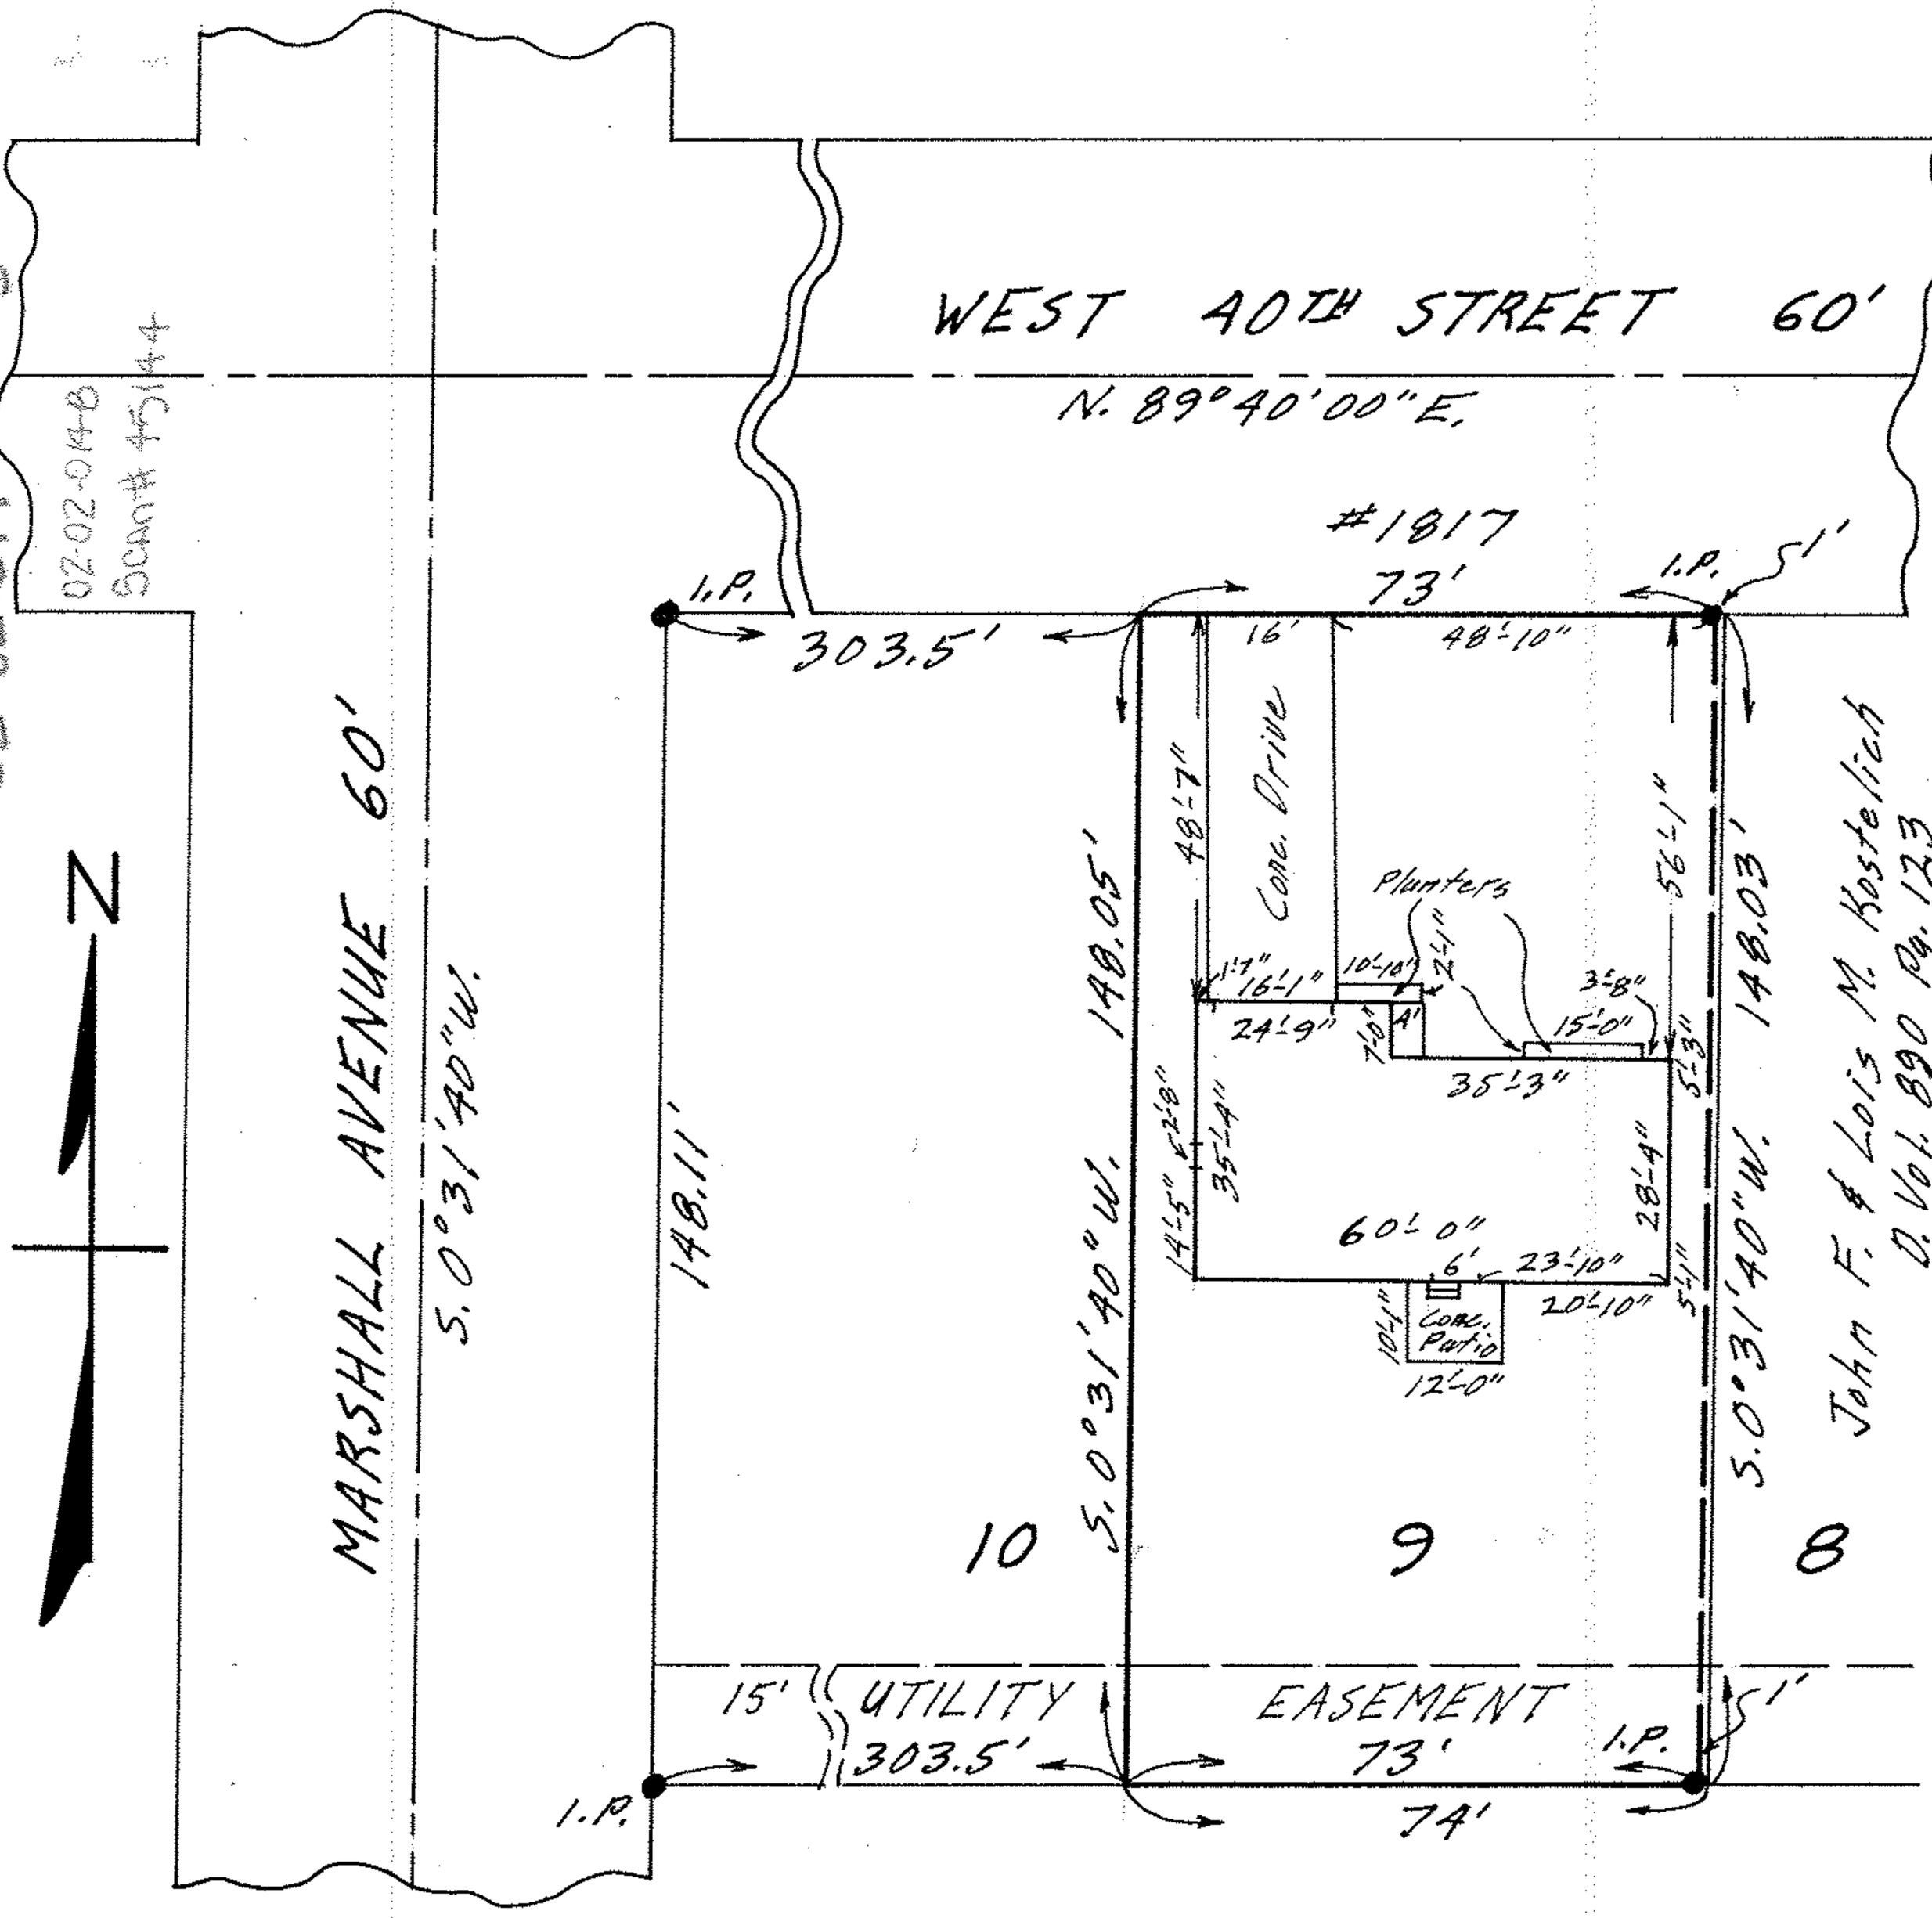

MAP OF SUB-LOT NO. 9 (EXCEPTING EASTERLY ONE FOOT)
AMELIA MEADOWS ALL'T., SUB'N. NO. 1 VOL. 22 PG. 71
ORIG. LOT 14 - TRACT 2 - BLACK RIVER TWP.
LORAIN CITY LORAIN COUNTY OHIO
SCALE: 1" = 30' SEPT. 11-1967 11:30 A.M.
Gary E. Kenfound REG. SURVEYOR

P.O. - Edward & Linda Wexler
D. Vol. 847 Pg. 518

02-02-014