02-02-015-102-003

02-02-015-A Scan #45145

MAP OF SUB-LOT NO. 16

WILLOW CREEK SUB'N. NO. 1 VOL. 14 PG. 41
ORIG. LOT 15 - TRACT 2 - BLACK RIVER TWP.
LORAIN CITY - LORAIN COUNTY - OHIO
SCALE: 1" = 40' AUG. 10-1967 11:30 A.M.
Gary E. Penfound REG. SURVEYOR

NOTE: Pool dimensions are to outside of 6" pool walls.

Order No. 1645

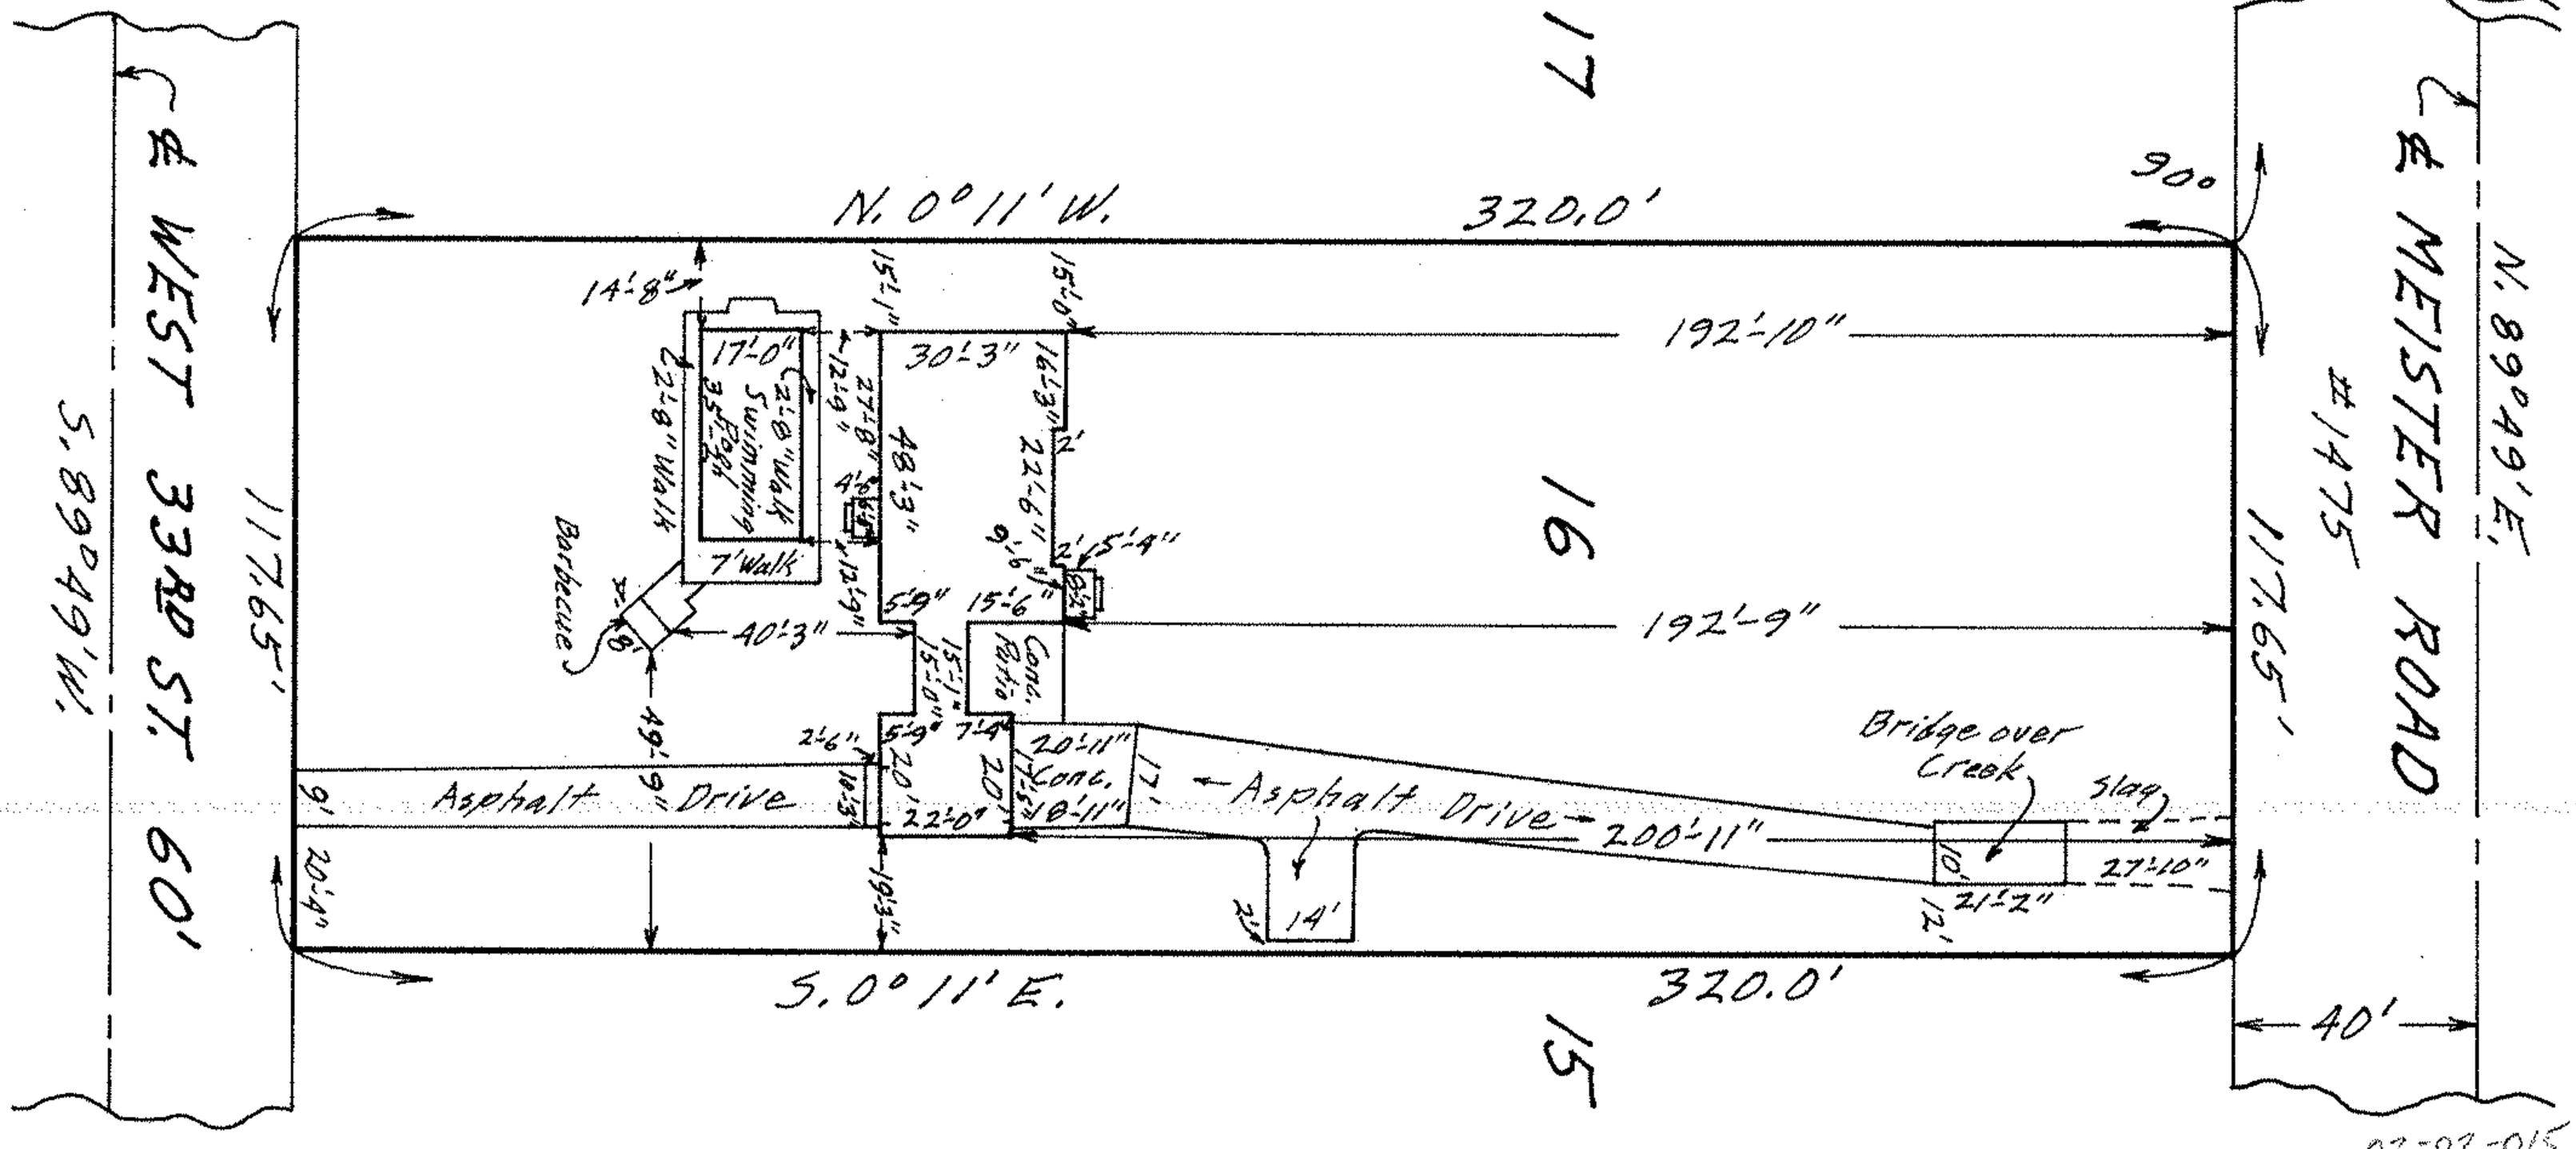

02-02-015