02-02-021-113-006
02-02-021-6
Scan# 45171

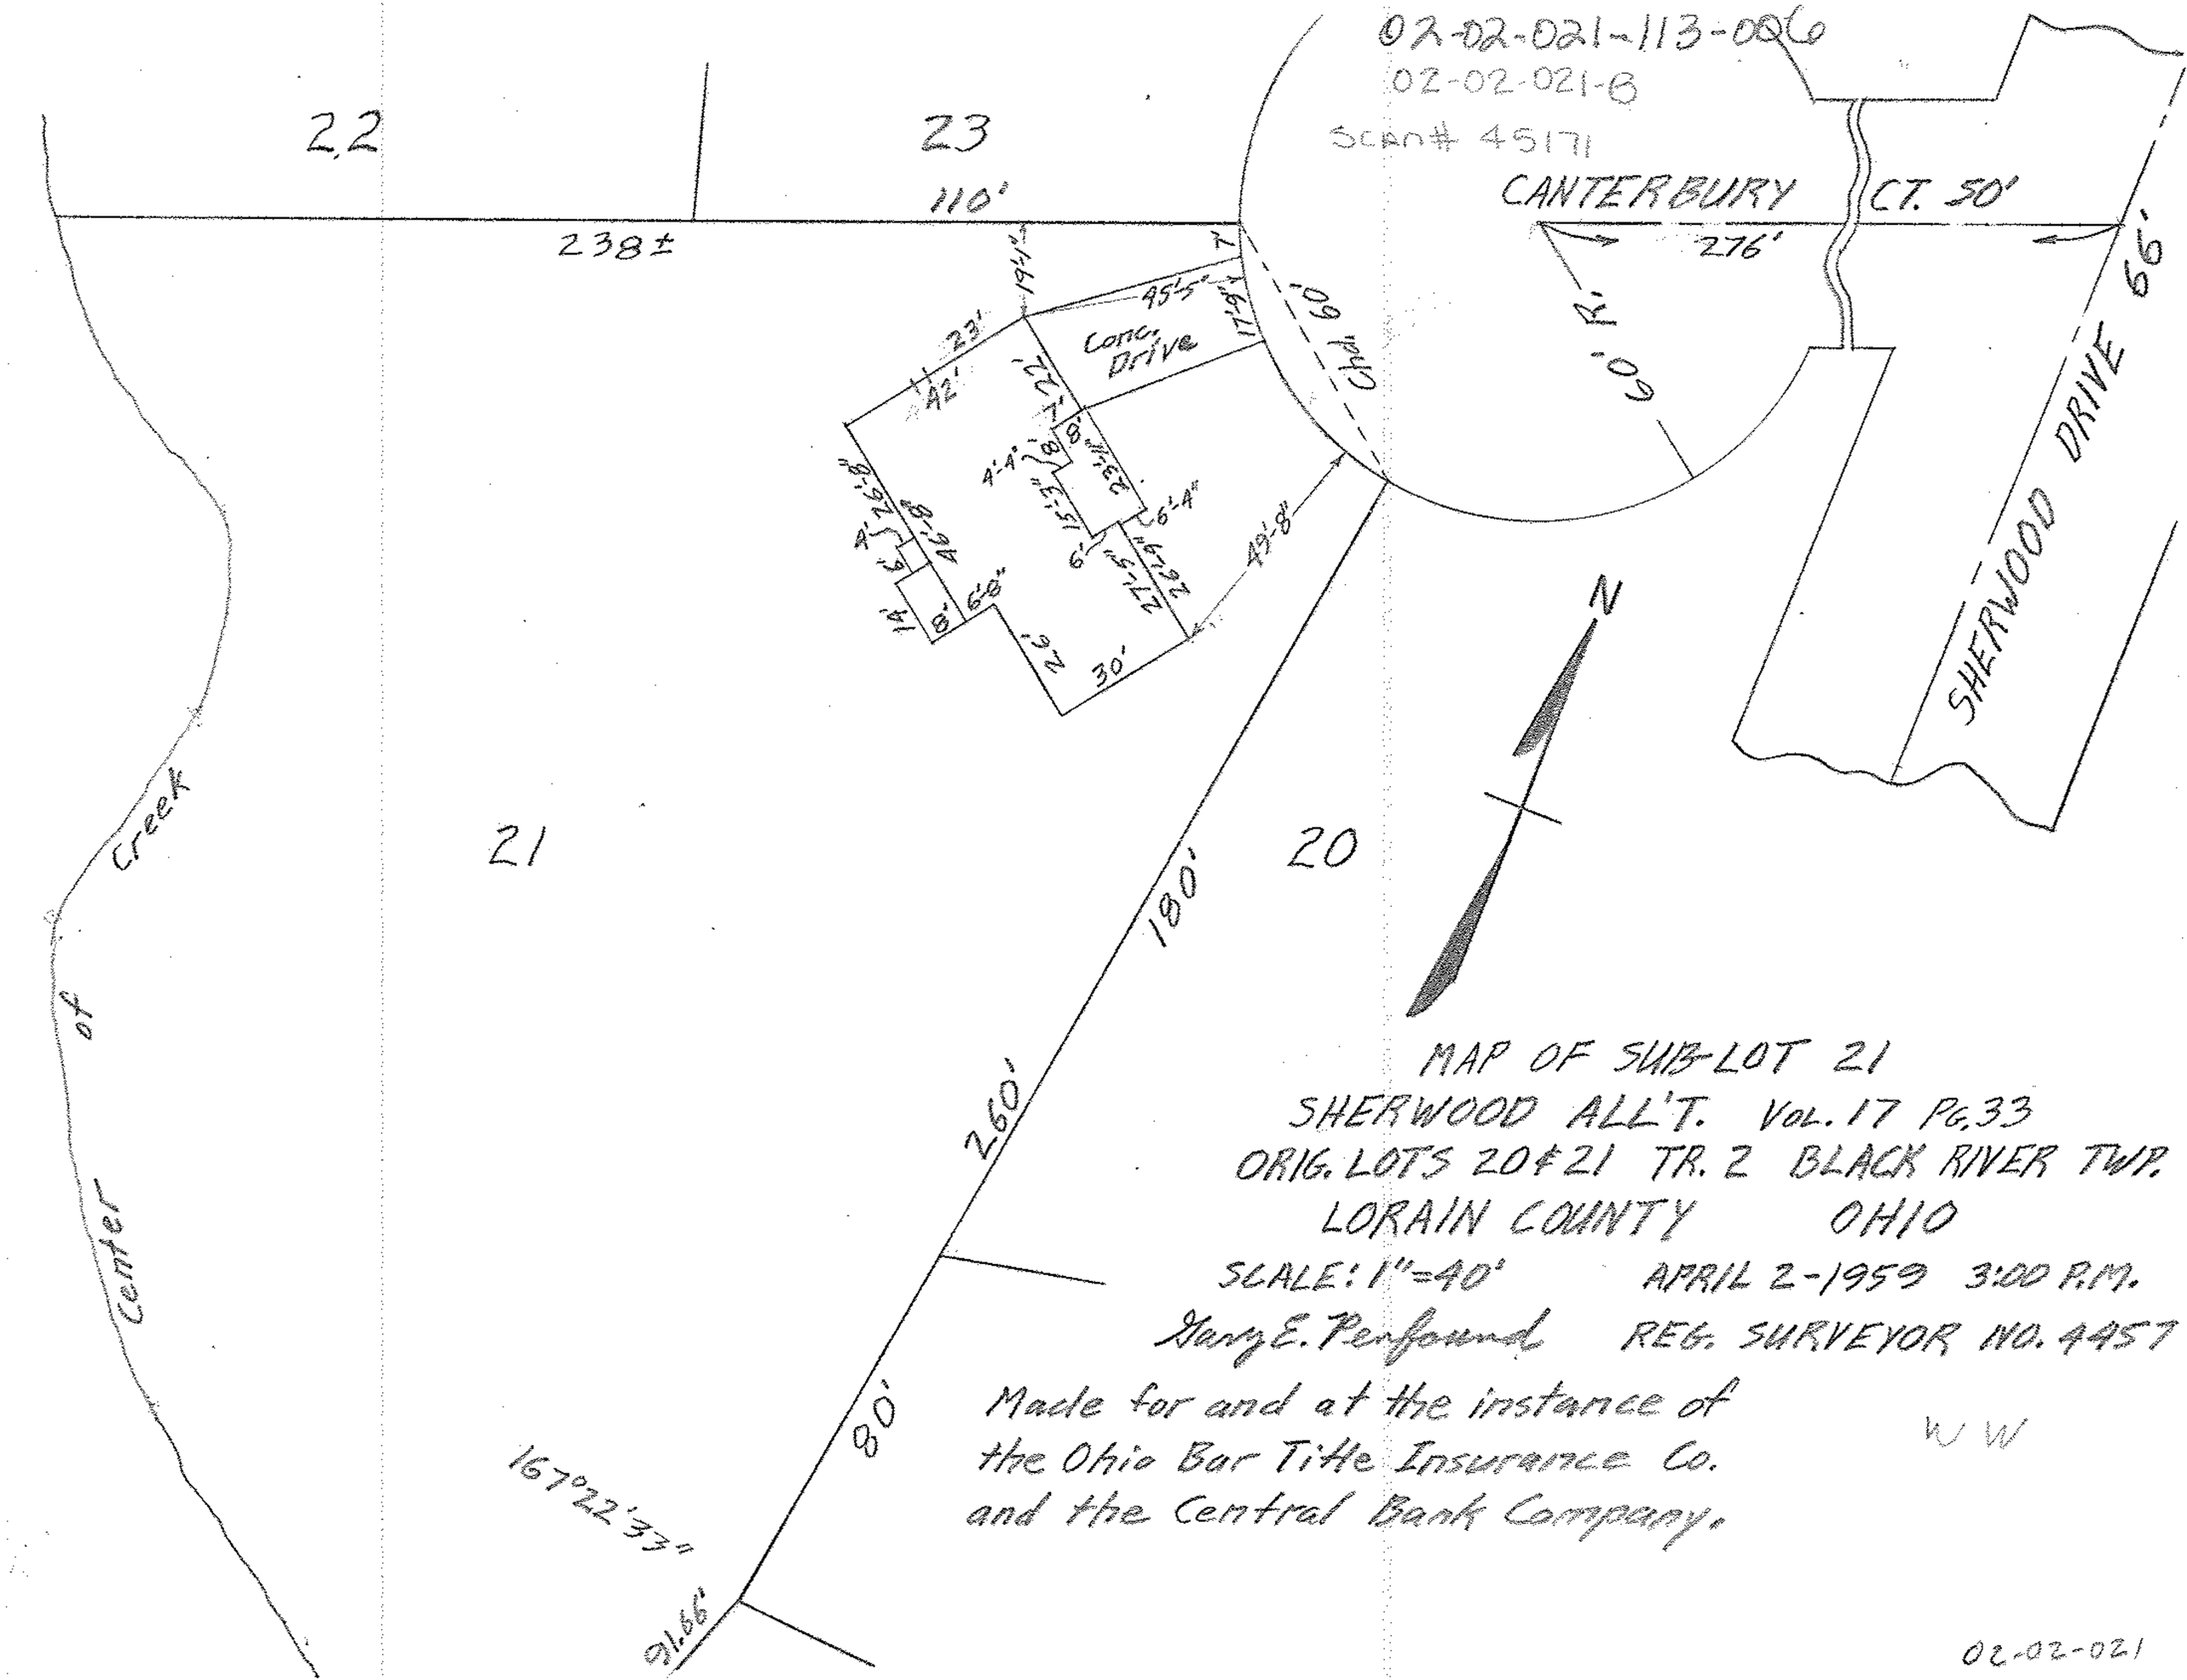

MAP OF SUB-LOT 21
SHERWOOD ALL'T. VOL. 17 PG. 33
ORIG. LOTS 20 & 21 TR. 2 BLACK RIVER TWP.
LORAIN COUNTY OHIO
SCALE: 1"=40' APRIL 2-1959 3:00 P.M.
Gary E. Penfound REG. SURVEYOR NO. 4457

Made for and at the instance of the Ohio Bar Title Insurance Co. and the Central Bank Company.

WW

02-02-021