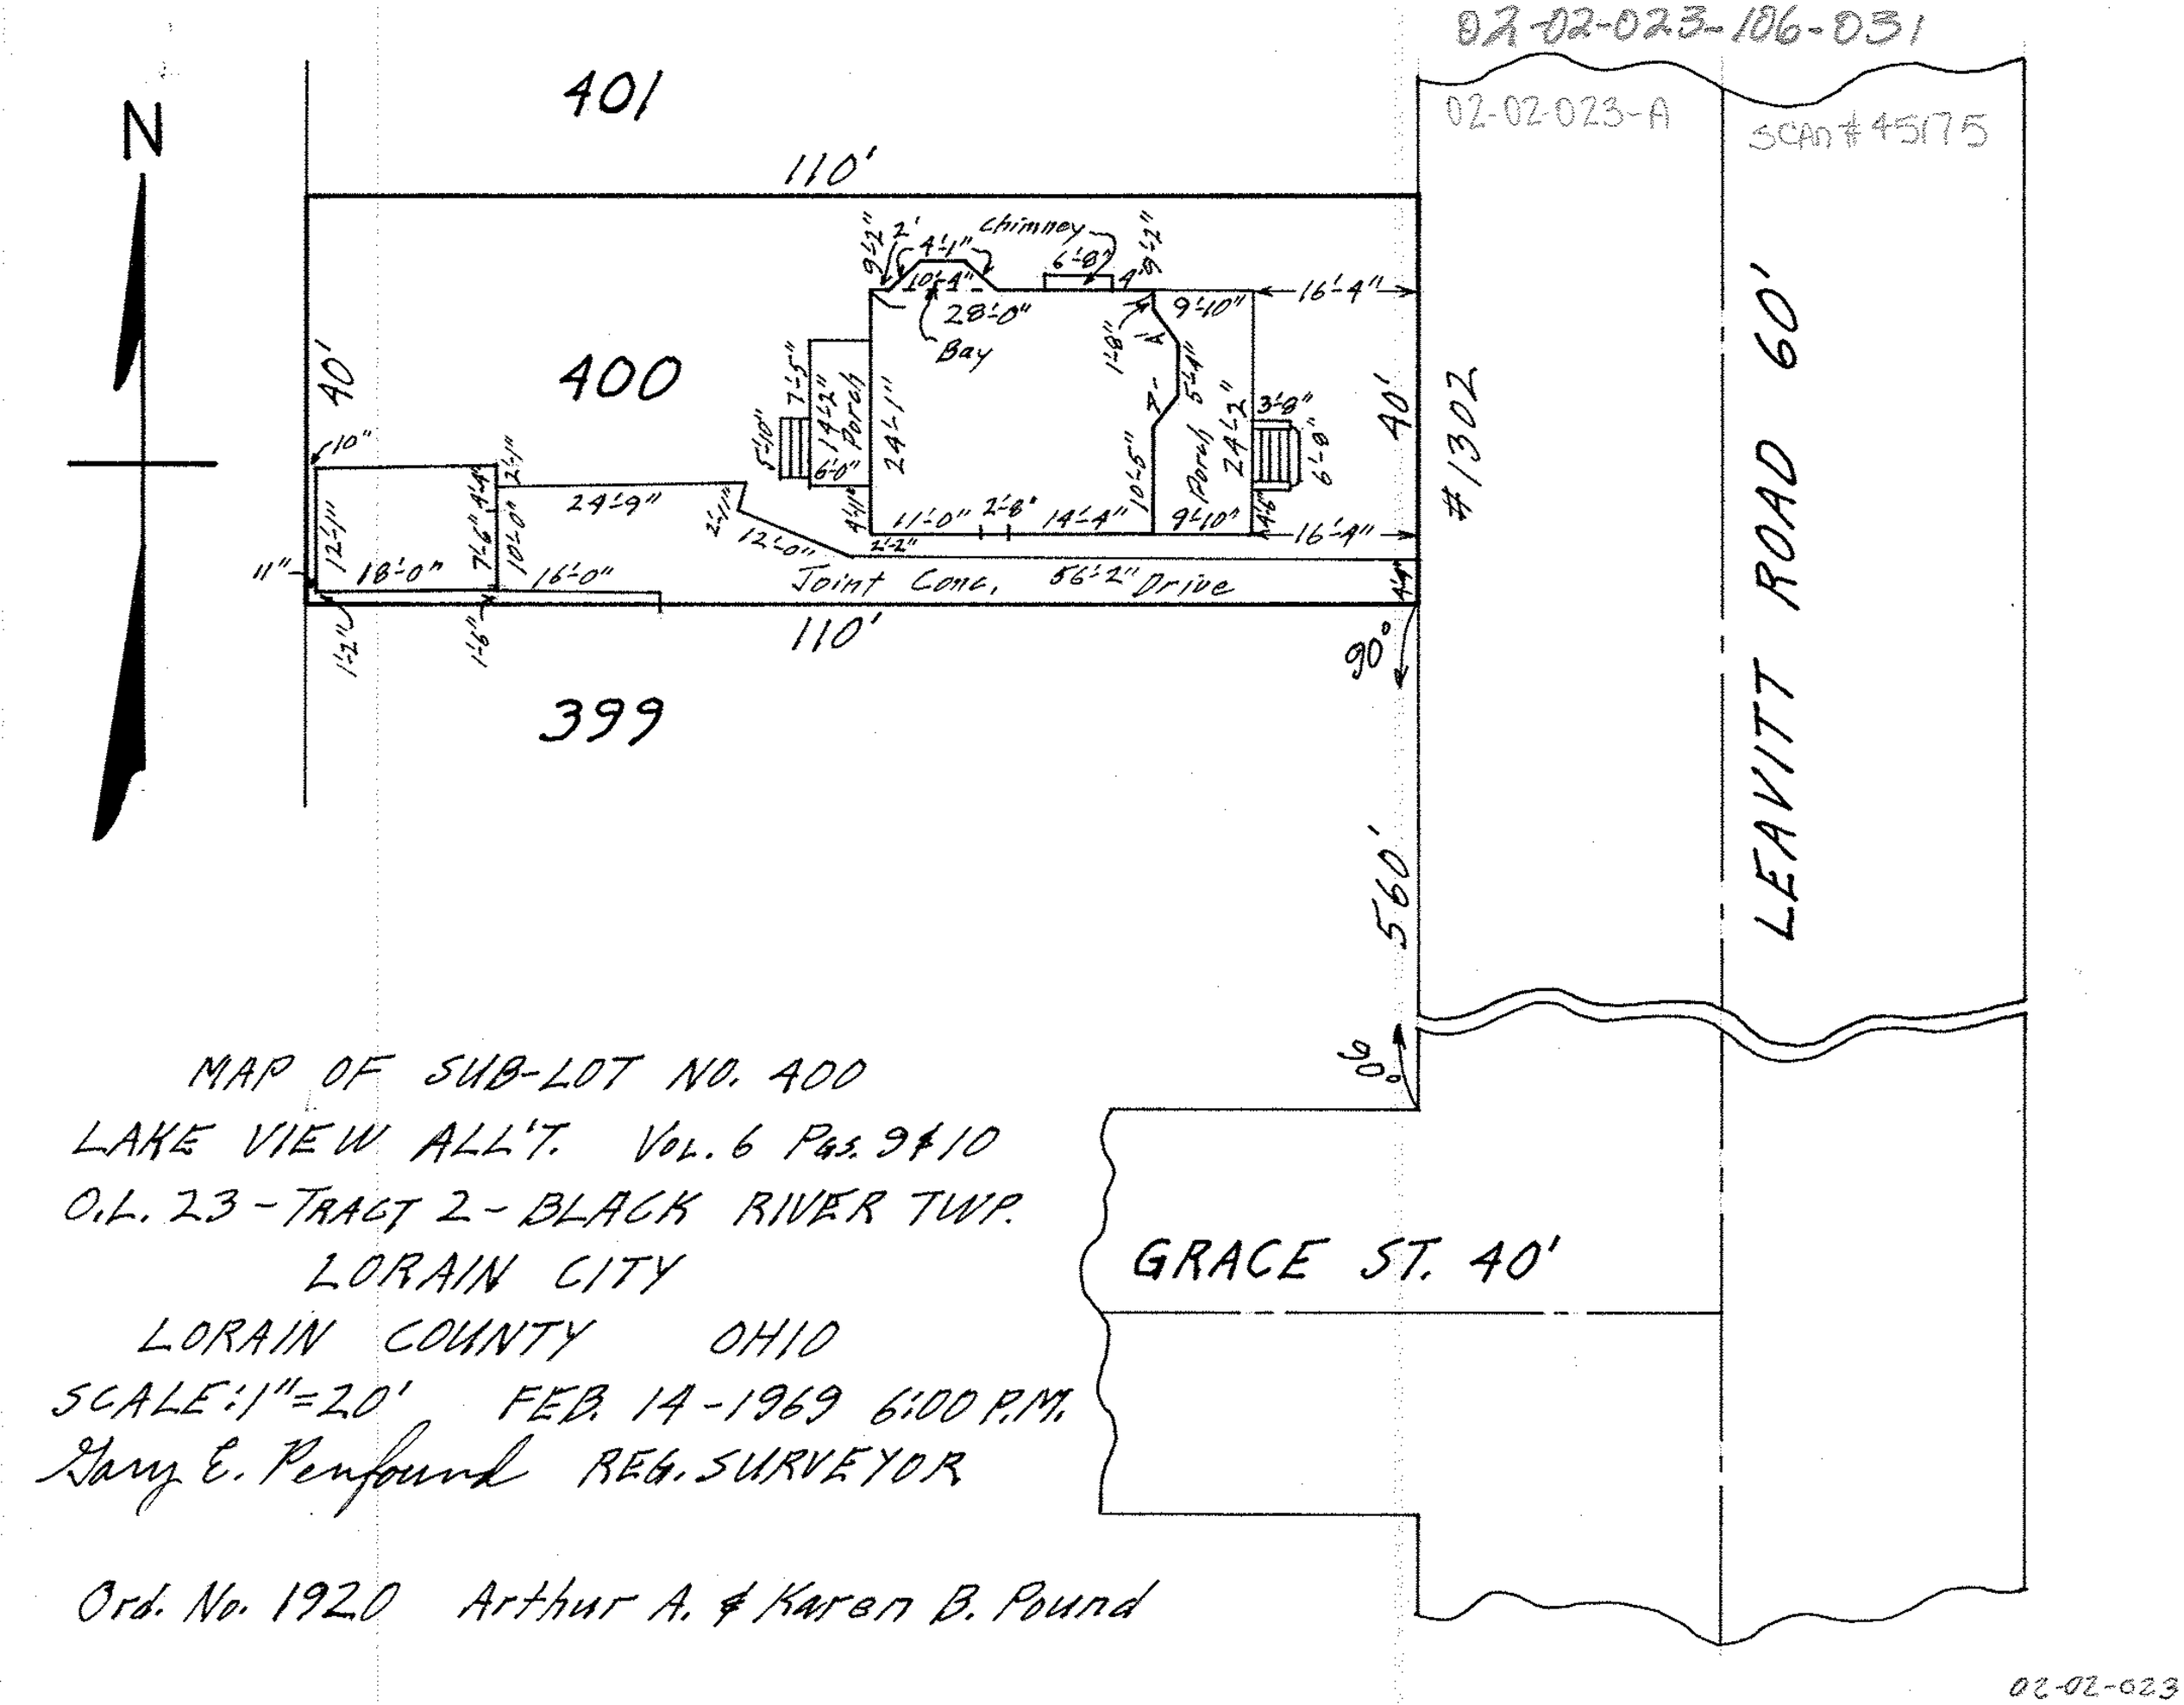
02-02-023-106-031
02-02-023-A
SCAN # 45175
N
401
110'
400
399
40'
110'
Chimney
Bay
Porch
Porch
Joint Conc. 56'-2" Drive
#1302
LEAVITT ROAD 60'
560'
90°
GRACE ST. 40'
MAP OF SUB-LOT NO. 400
LAKE VIEW ALL'T. VOL. 6 PGS. 9 & 10
O.L. 23 - TRACT 2 - BLACK RIVER TWP.
LORAIN CITY
LORAIN COUNTY OHIO
SCALE: 1" = 20' FEB. 14 - 1969 6:00 P.M.
Gary E. Penfound REG. SURVEYOR
Ord. No. 1920 Arthur A. & Karen B. Pound

02-02-023