02-02-023-108-00
02-02-023-8
02-02-023

MAP OF SUB-LOTS NOS. 97 & 98

LAKE VIEW ALL'T. VOL. 6 PGS. 9 & 10 PLATS
O.L. 23 - TRACT 2 - BLACK RIVER TWP.
LORAIN CITY - LORAIN COUNTY - OHIO
SCALE: 1" = 20' APR. 29-1971 6:15 P.M.

NOTE: There are no encroachments on this property.
Gary E. Penfound
REG. SURVEYOR NO. 4457
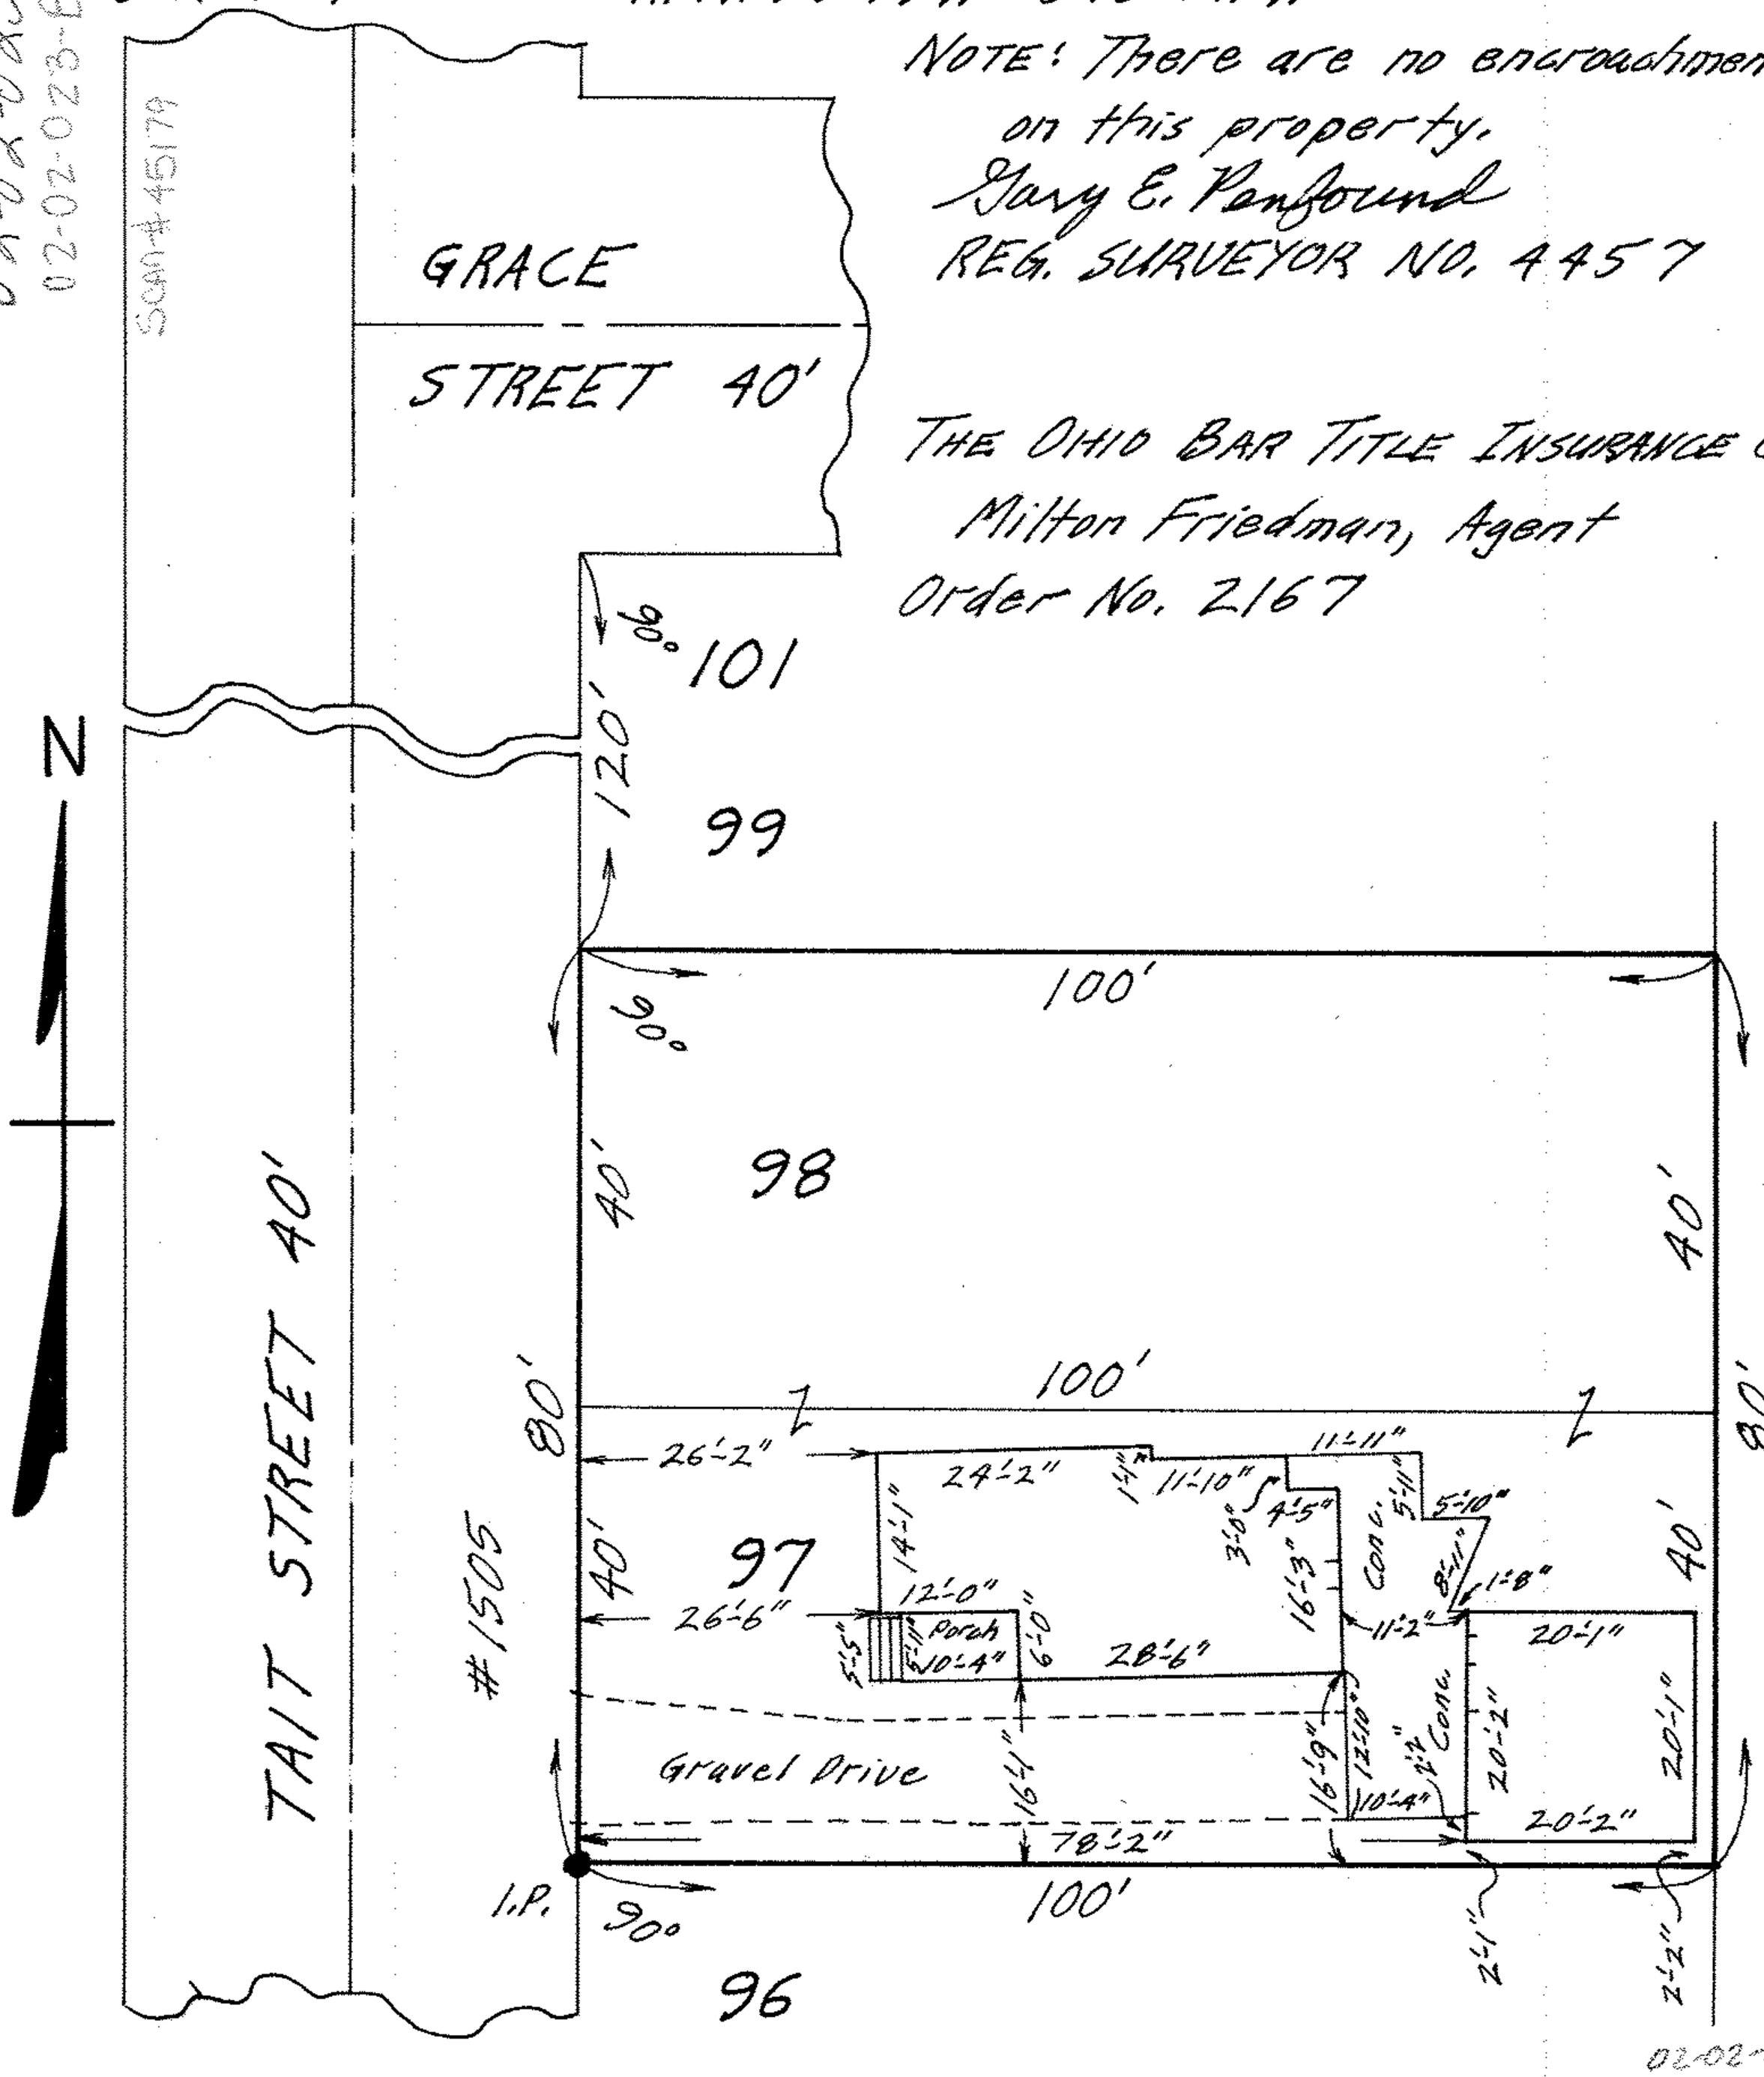
THE OHIO BAR TITLE INSURANCE CO.
Milton Friedman, Agent
Order No. 2167