02-02-027-15-020

02-02-027 Sum #45211

MAP OF SUB-LOT NO. 217

LAKE VIEW PARK REALTY CO. ALL'T. SECOND ADD'N. Vol. 9 Pg. 28

ORIG. LOT 27 - TRACT 2 - BLACK RIVER TWP.

LORAIN CITY - LORAIN COUNTY - OHIO

SCALE: 1" = 30' OCT. 2-1965 12:15 P.M.

Gary E. Perfound REG. SURVEYOR

Order No. 1276

WAGNER, William W. & Linda S.

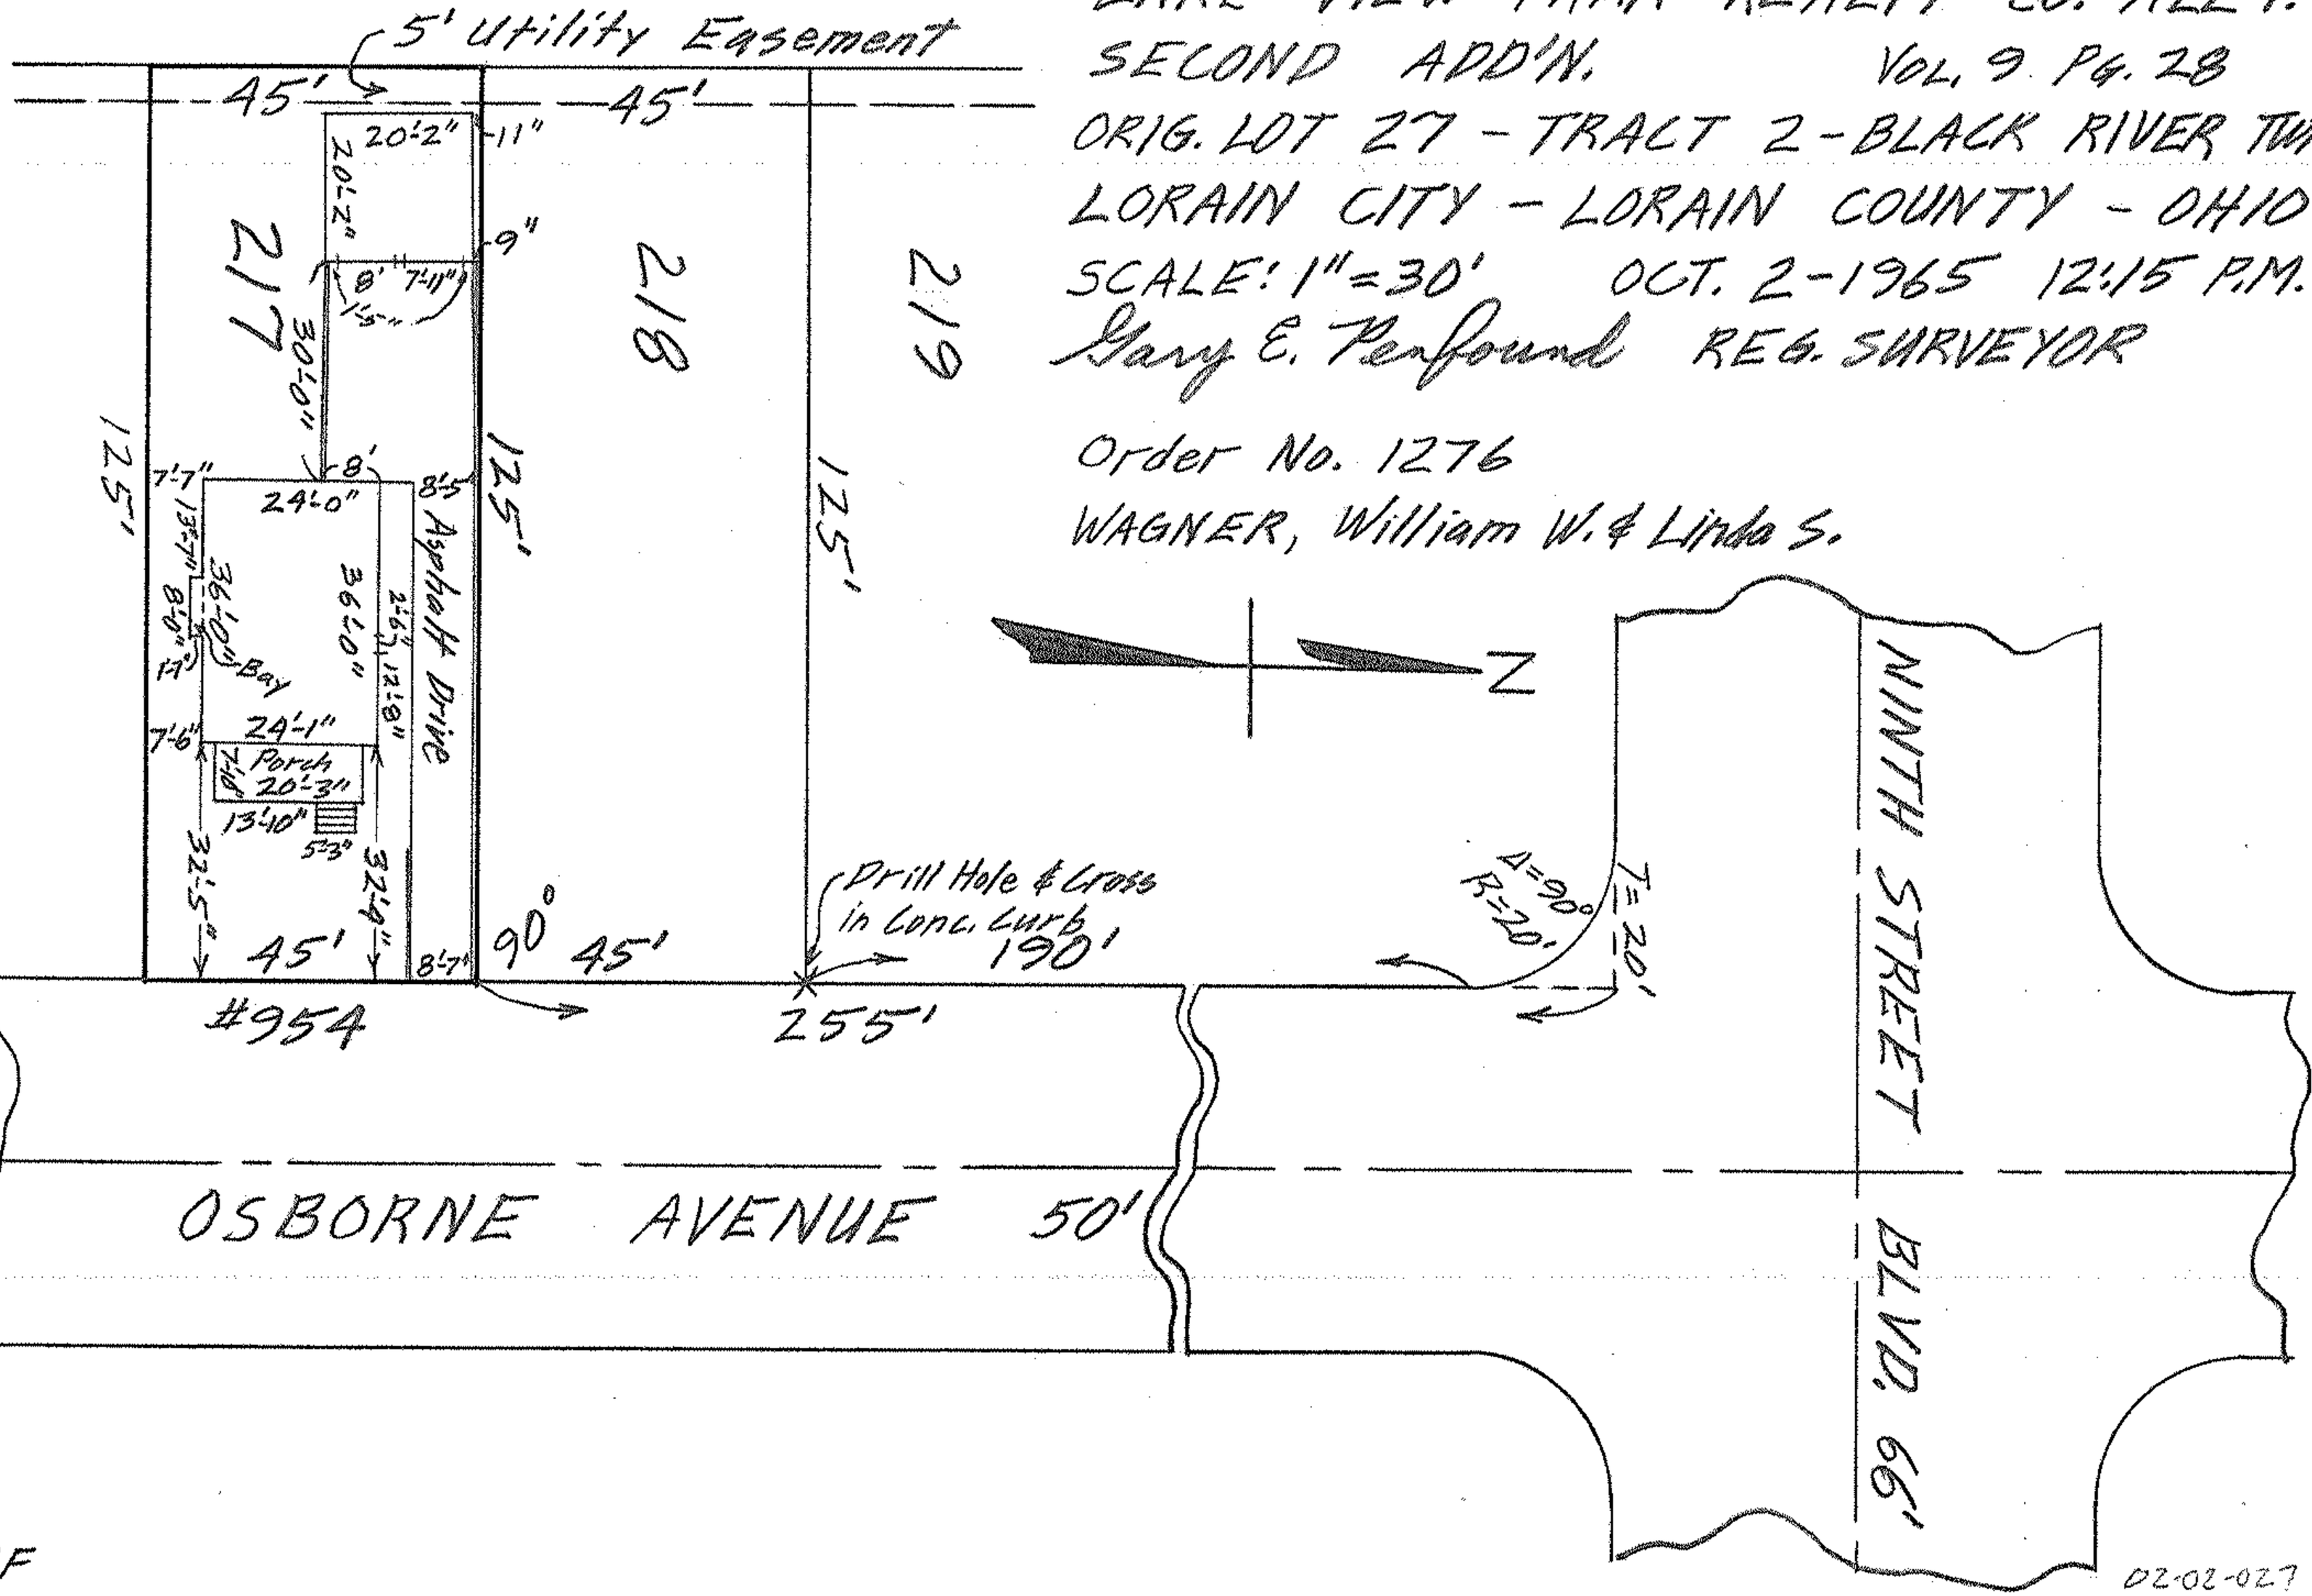

MF

02-02-027