02-02-029-103-012

02-02-029

SCAN # 45217

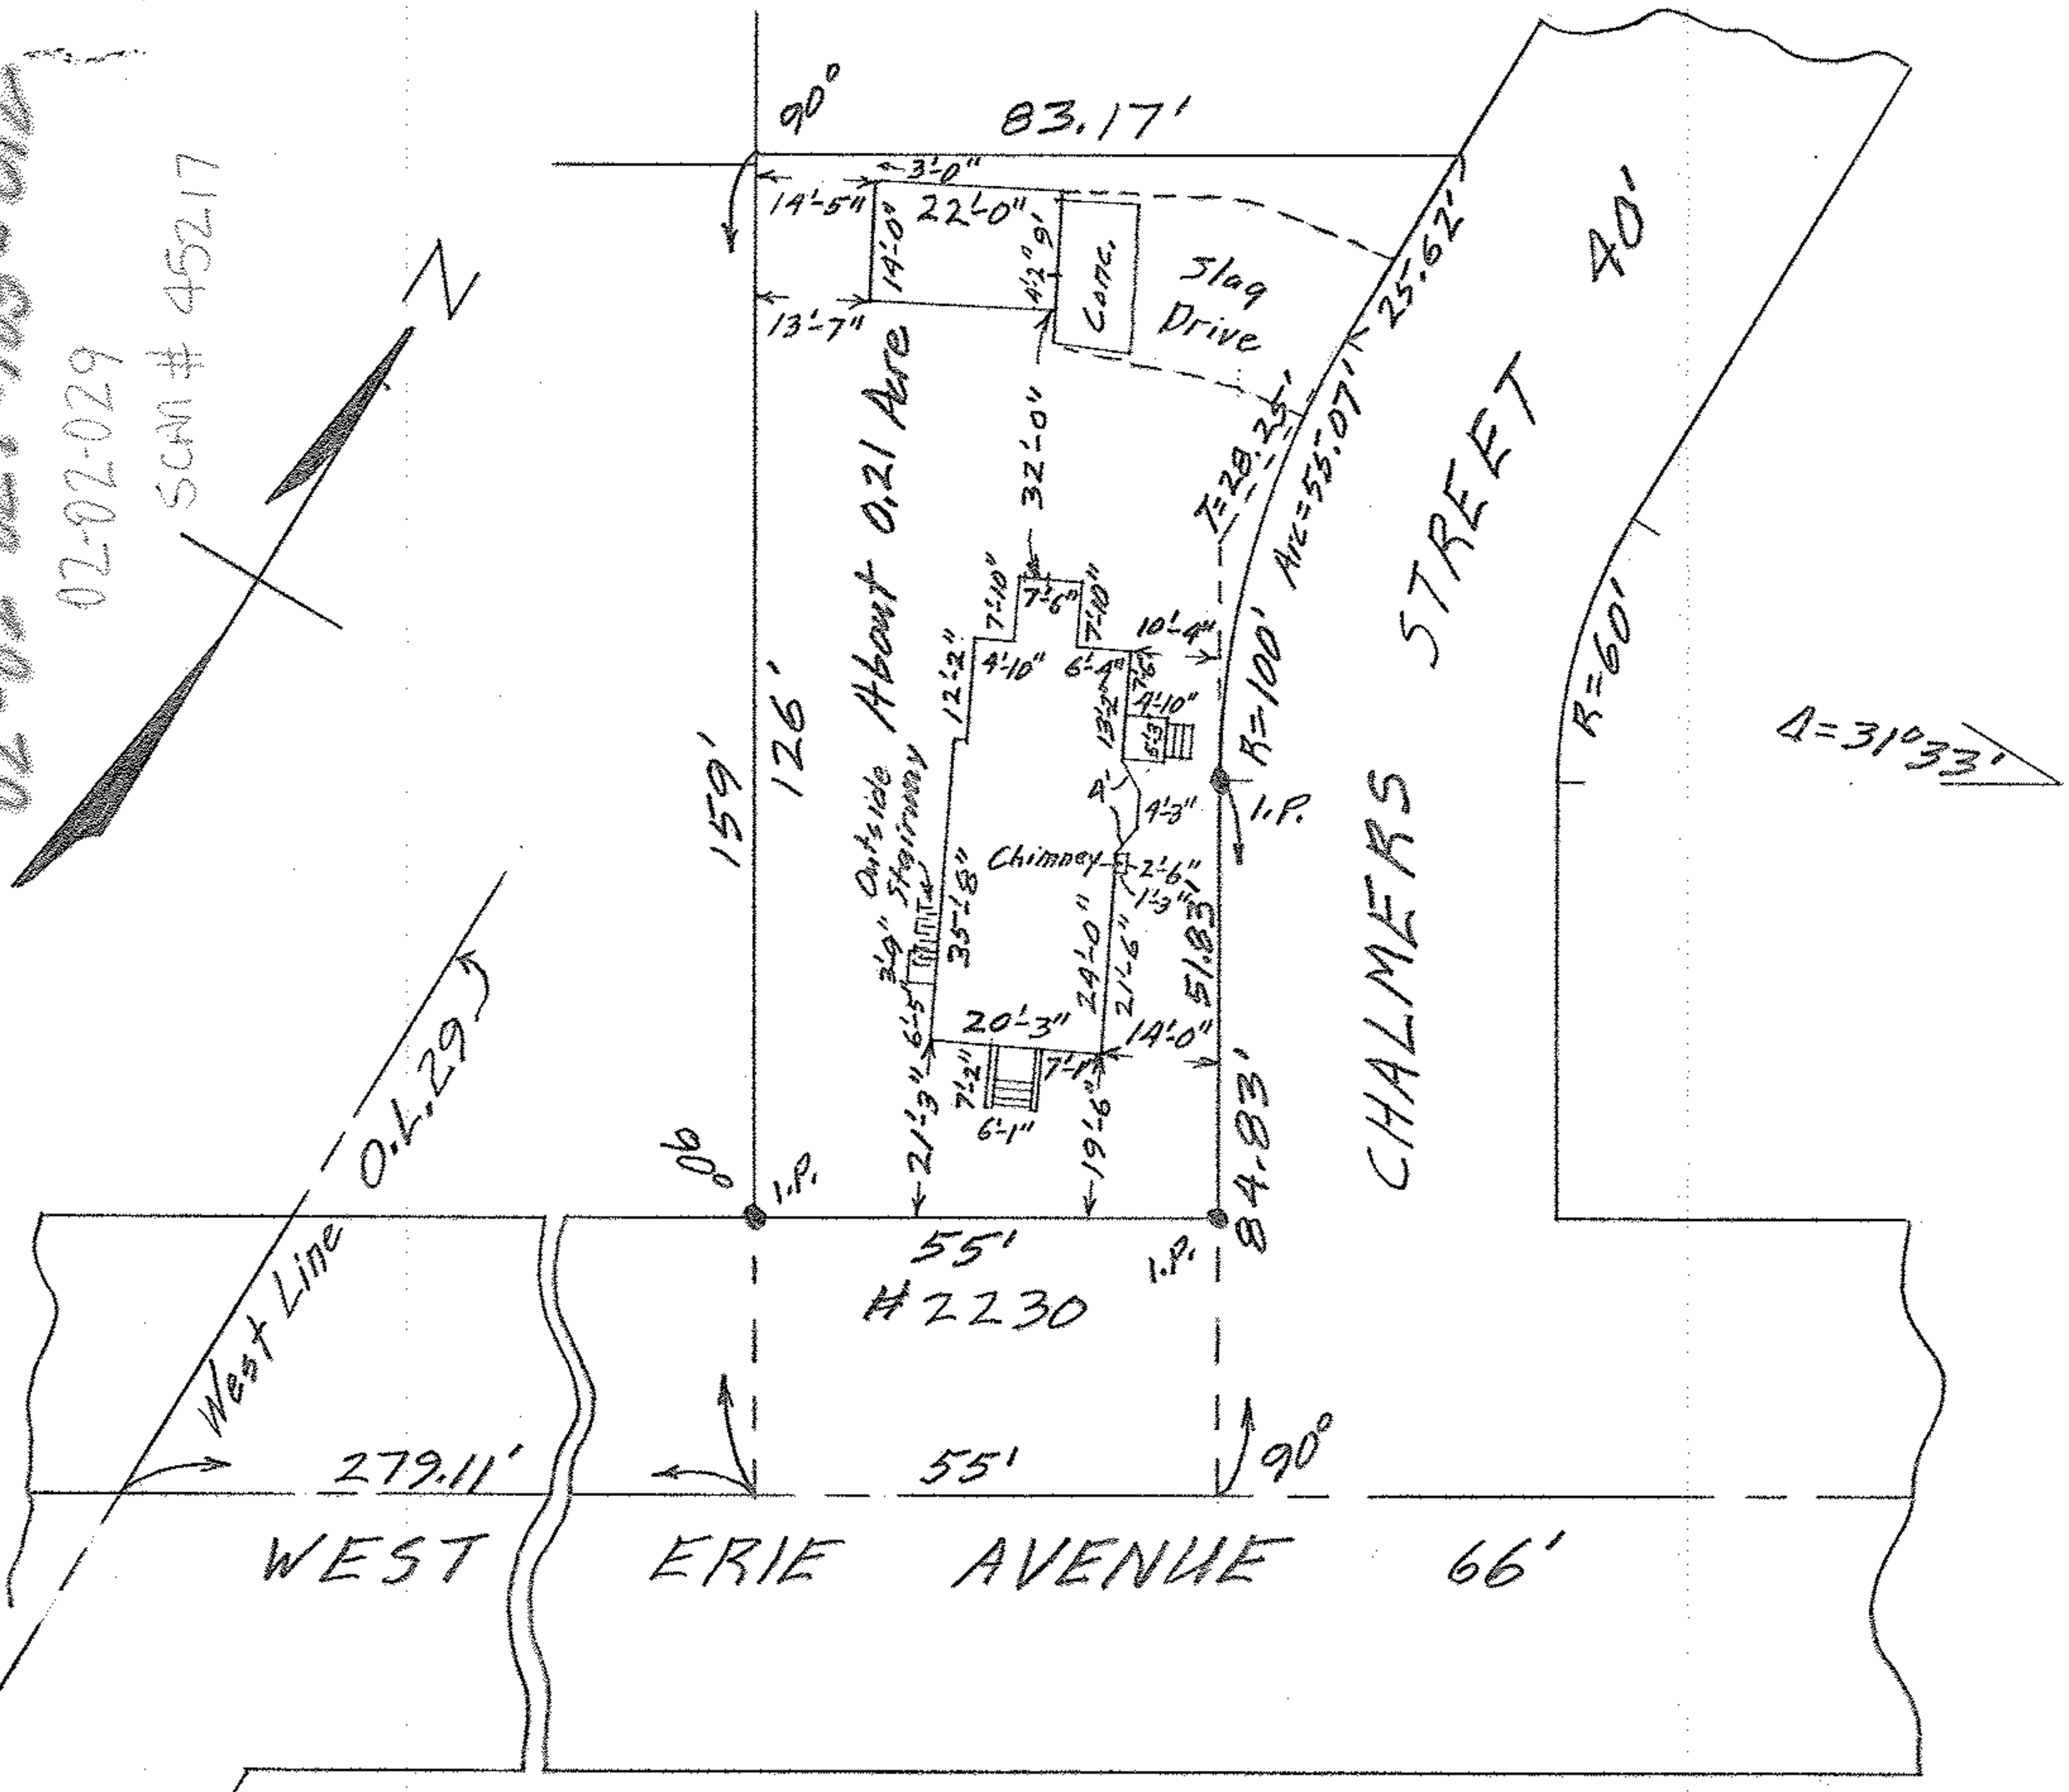

MAP OF PART OF ORIG. LOT 29 - TRACT 2

BLACK RIVER TWP. LORAIN CITY

LORAIN COUNTY OHIO

SCALE: 1" = 30' NOV. 6-1964 11:00 A.M.

Gary E. Penfound REG. SURVEYOR

Jessie L. & Ollie B. Scates

PC

02-02-029