02-02-029-110-001-003

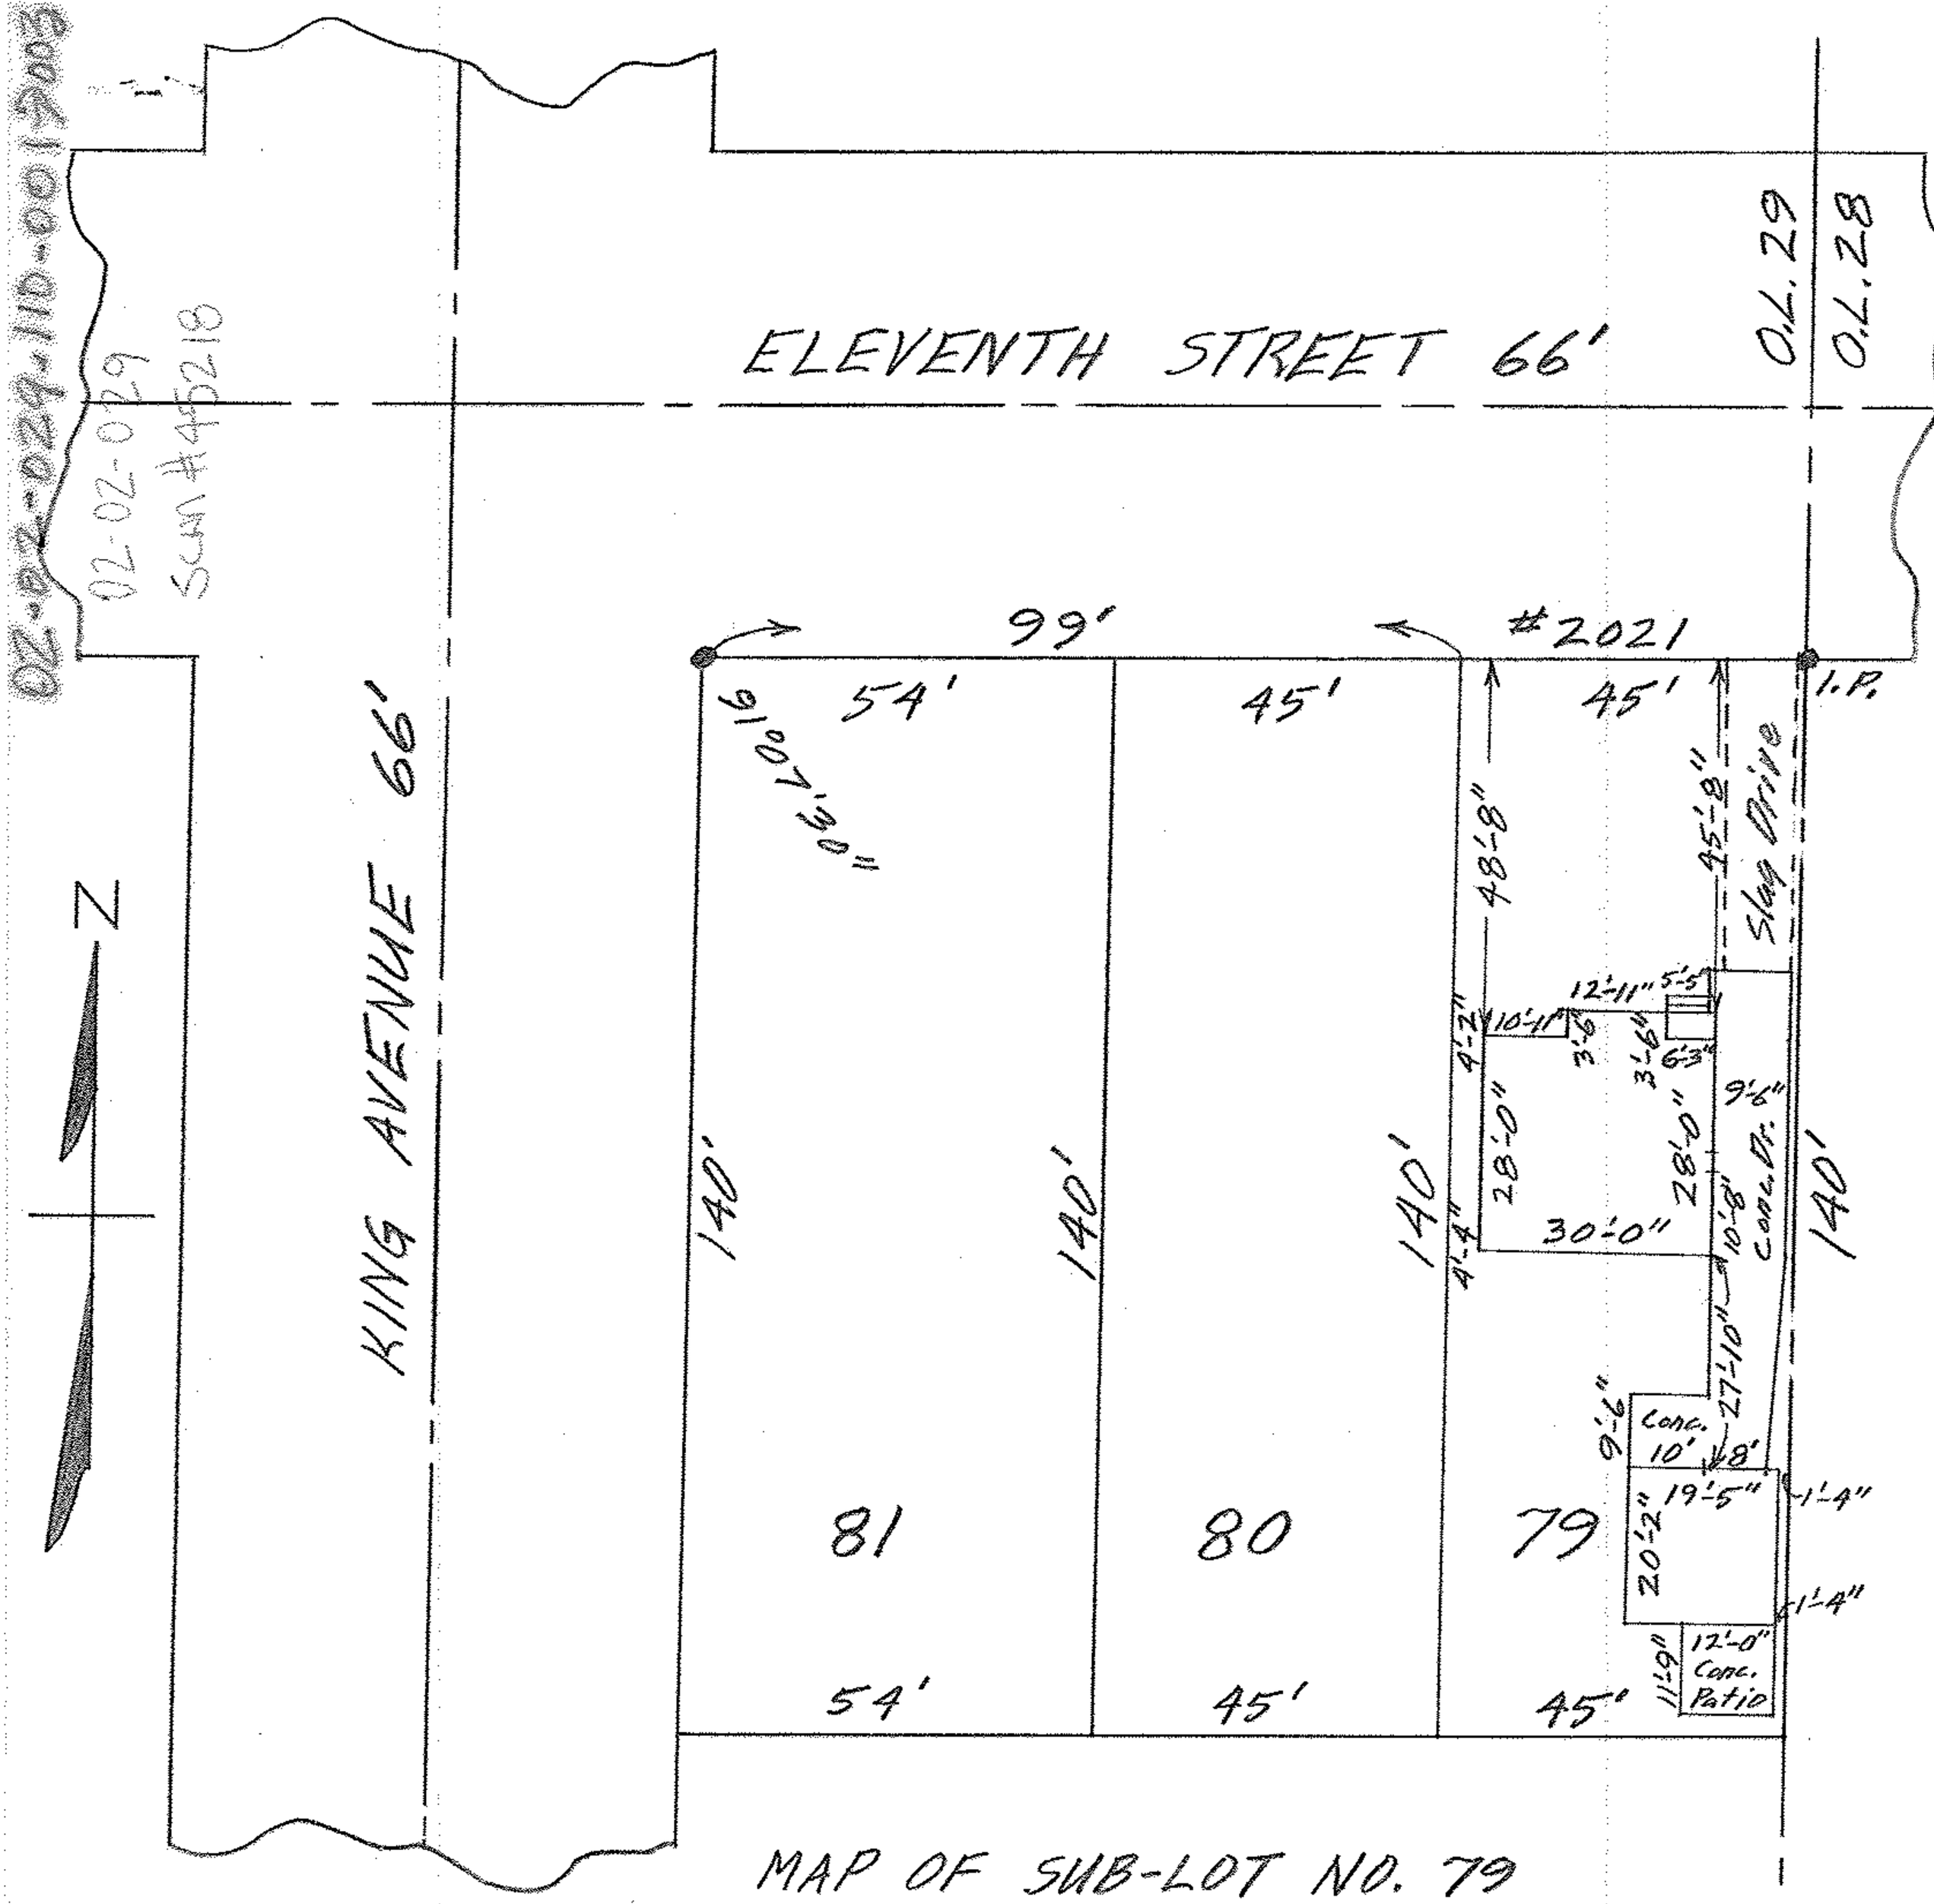

MAP OF SUB-LOT NO. 79

WEST ERIE PARK ALL'T. VOL. 9 PG. 23

ORIG. LOT 29 - TRACT 2 - BLACK RIVER TWP.

LORAIN CITY - LORAIN COUNTY - OHIO

SCALE: 1"=30' DEC. 19-1964 11:45 A.M.

Gary E. Penfound REG. SURVEYOR

Warren W. & Patricia A. Westwood

PC

02-02-029