Scan #45221

02-03-002-106-012

02-03-002-B

MAP OF SUB-LOT NO. 51 (Now Vacated)
THE BEAVER PARK SUB'N. VOL. 10 PG. 35
PART OF ORIG. LOT NO. 2 - TRACT 3
BLACK RIVER TWP.
LORAIN COUNTY OHIO
SCALE: 1"=30' SEPT. 1-1965 2:15 P.M.
Gary E. Penfound REG. SURVEYOR

James M. & Aurelia Looney

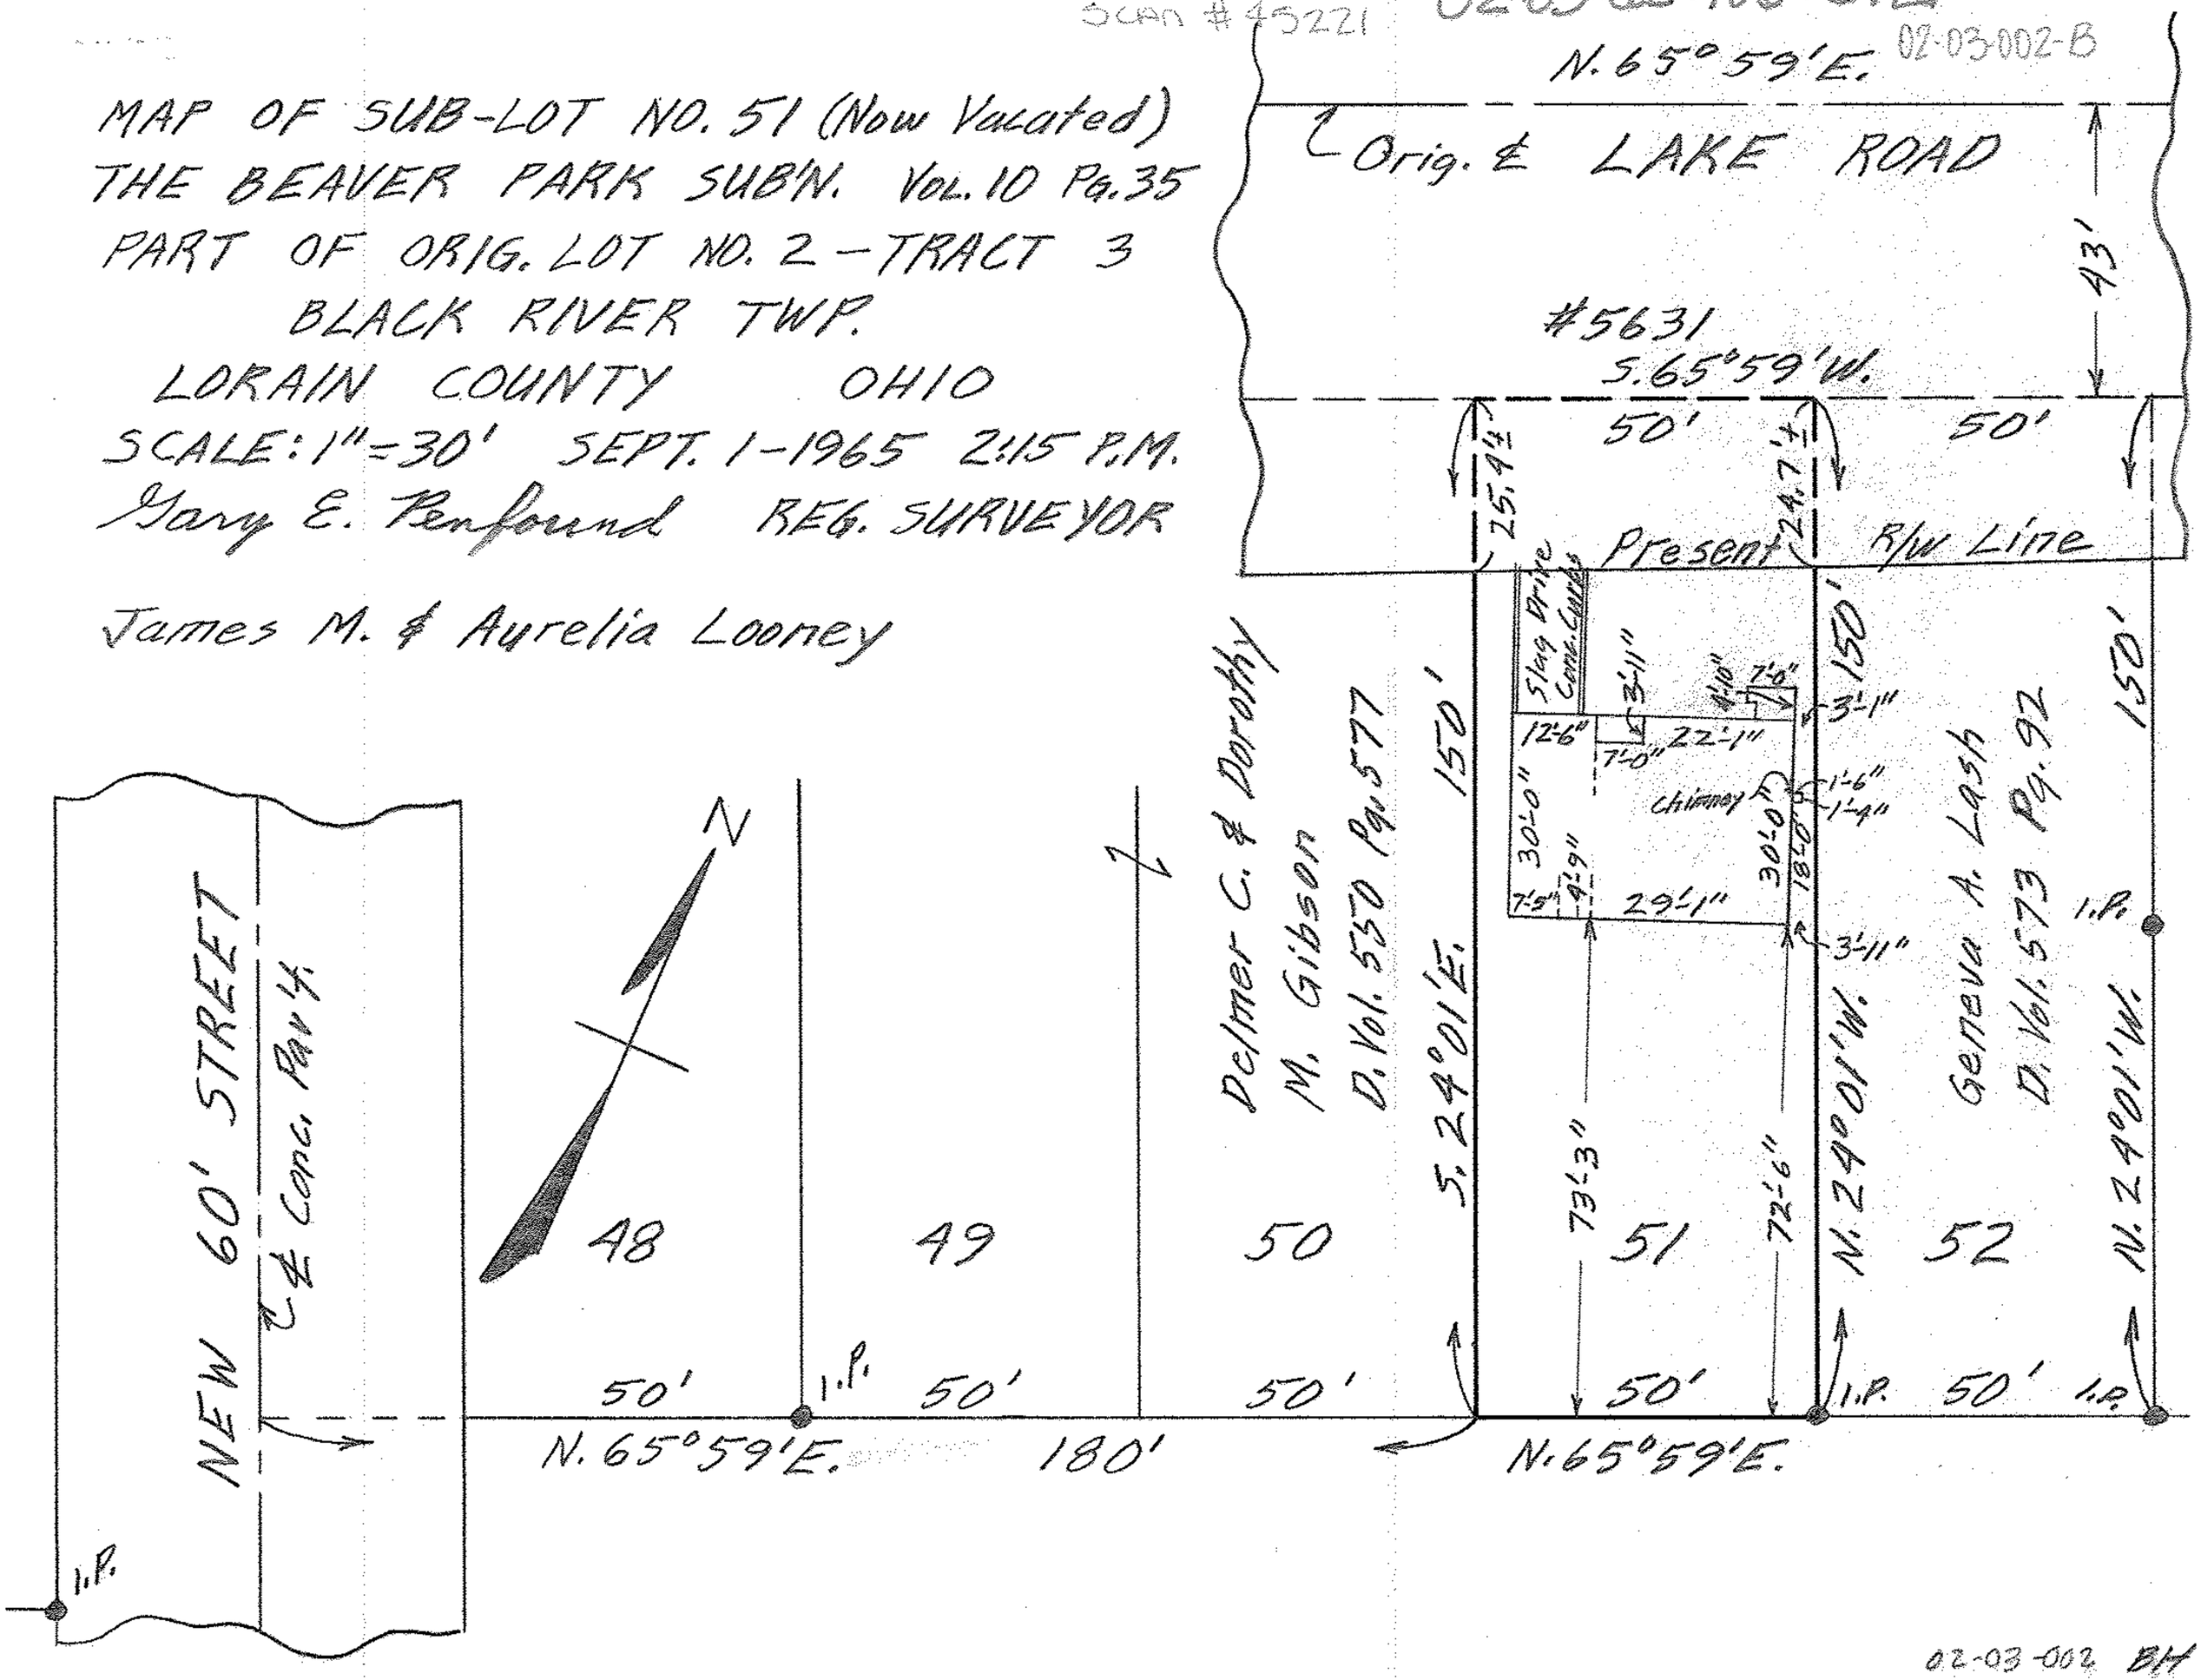

02-03-002 BH