


02-03-005-101-007,008

02-03 005-A

SCAN# 45224

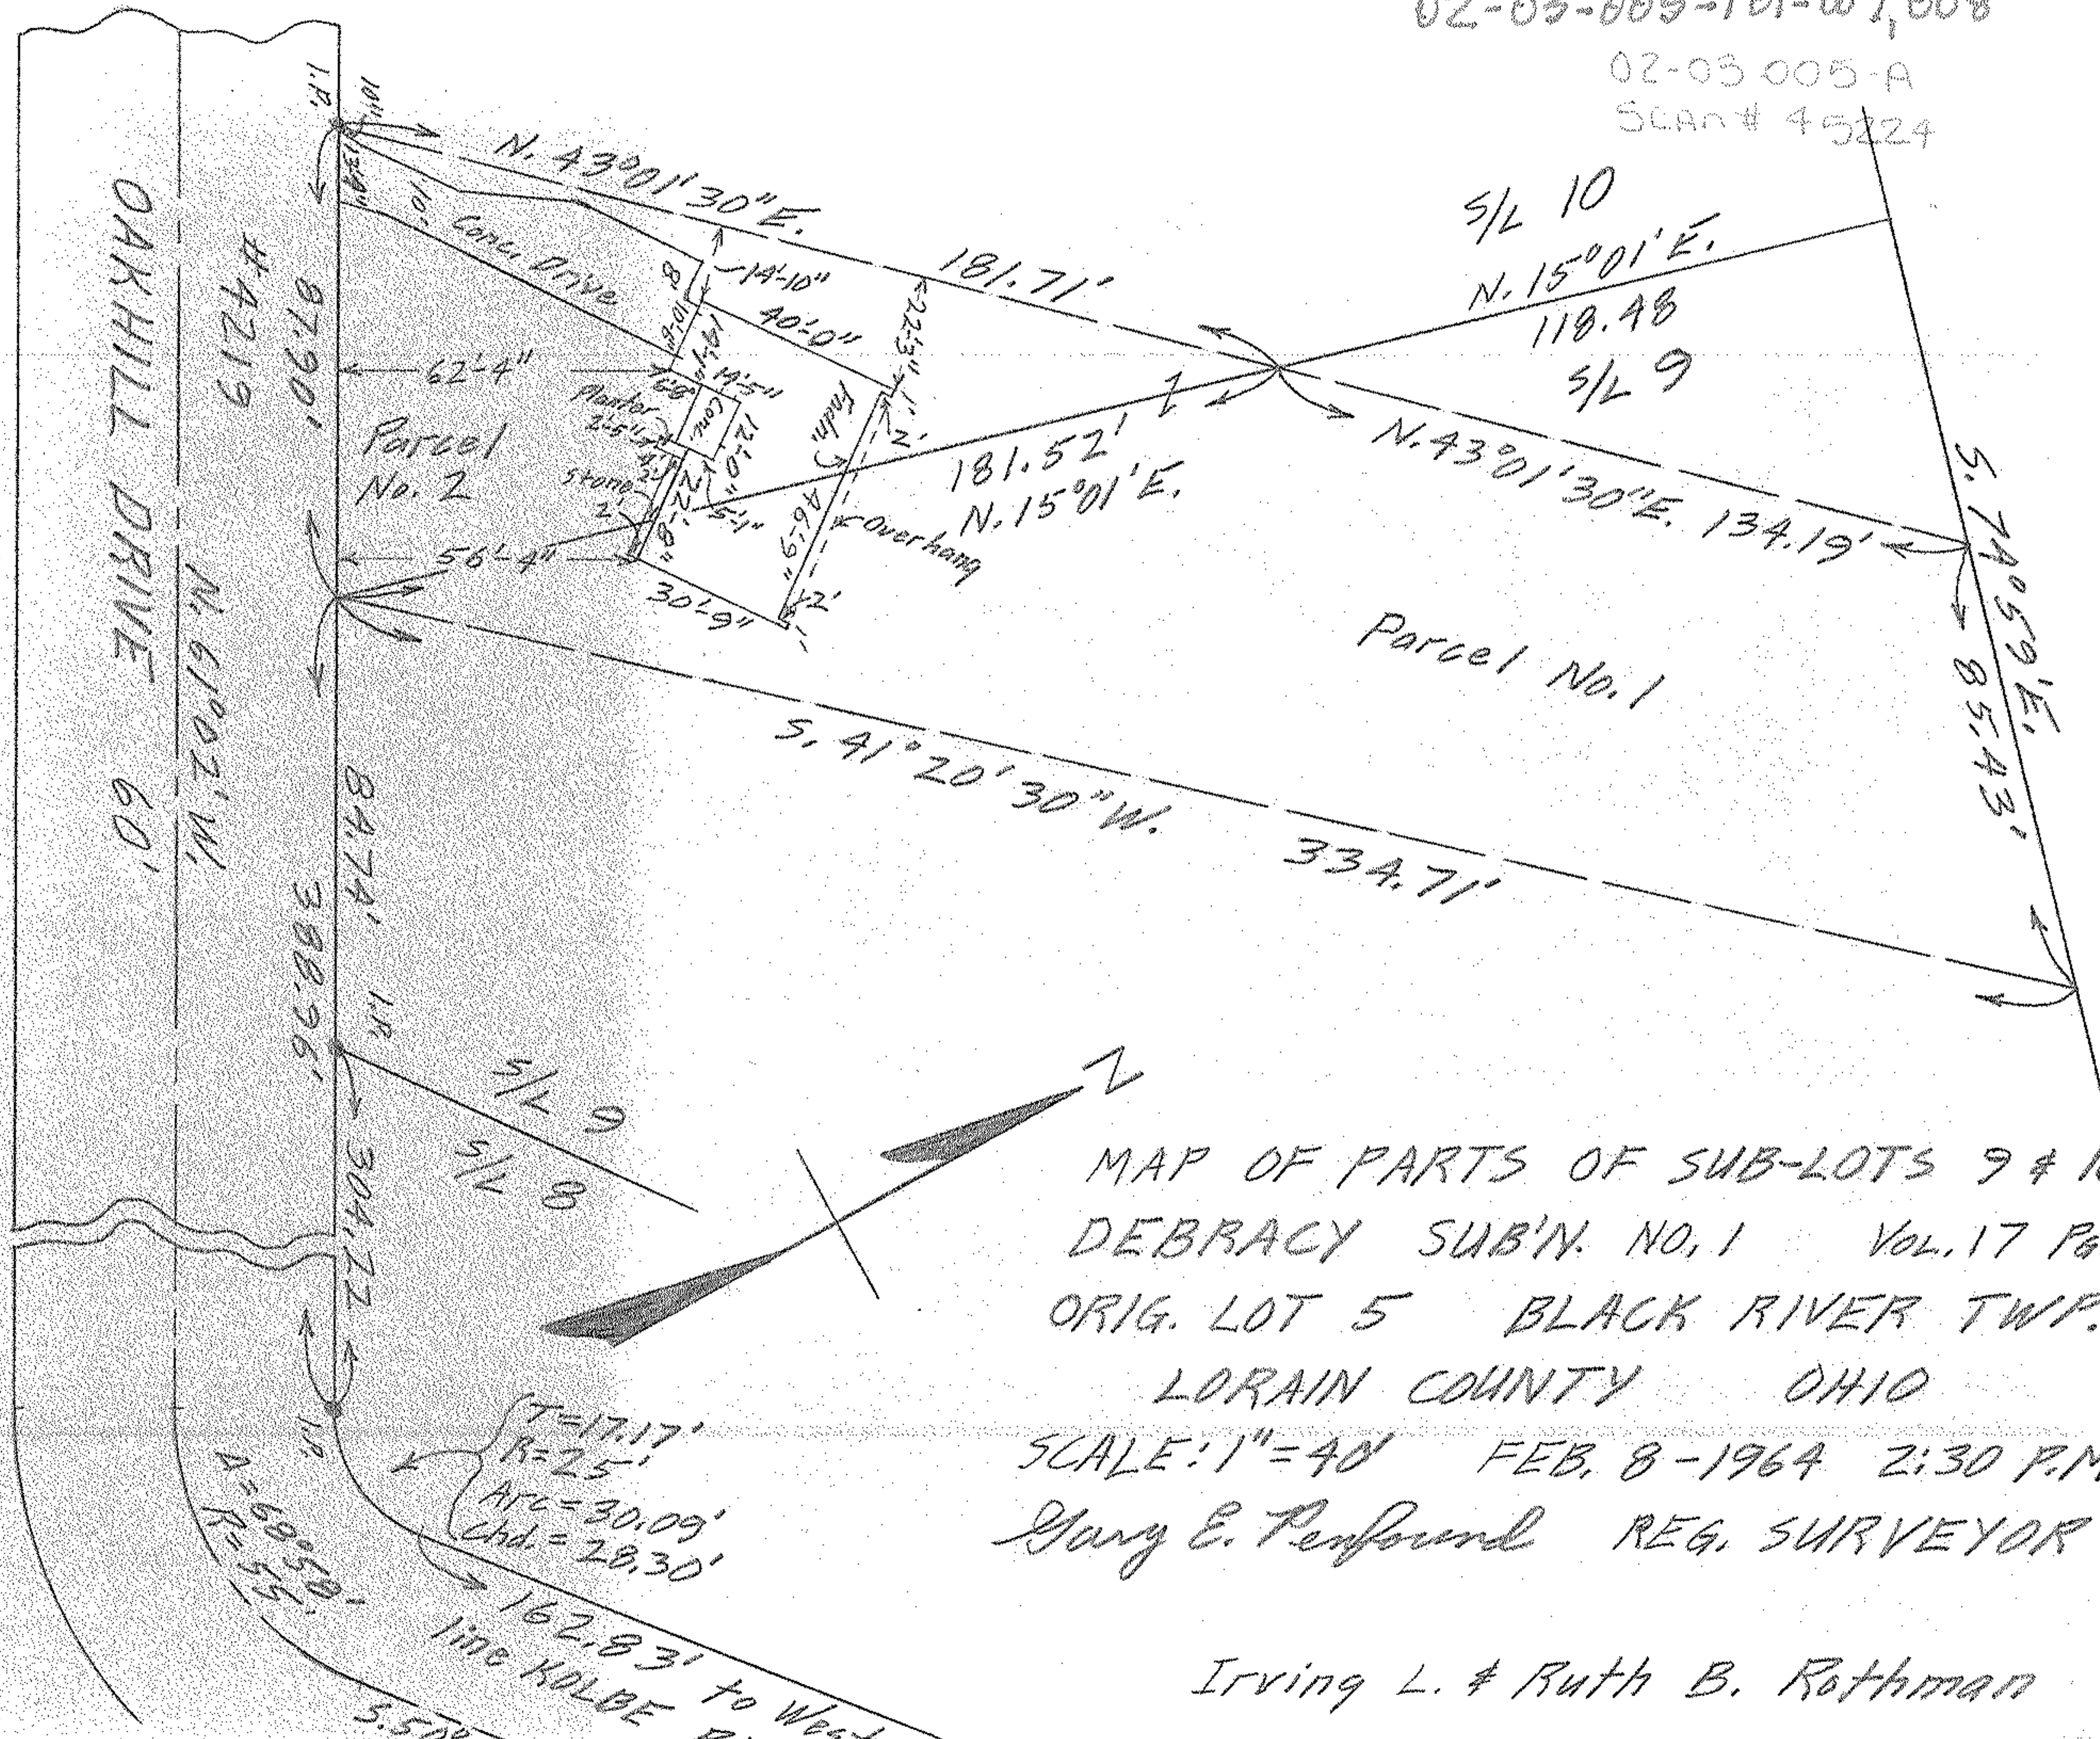

OAKHILL DRIVE 60'

#4219

N. 61°02' W.

181.71'
 181.52'
 134.19'
 85.43'
 334.71'
 304.72'
 308.96'
 84.79'
 87.90'
 181.71'

Parcel No. 2

Parcel No. 1

S/L 10
 N. 15°01' E.
 118.48
 S/L 9

S/L 9
 S/L 8

T=17.17'
 R=25'
 Arc.=30.09'
 Chd.=28.30'

162.83' to West
 line KOLBE RD.
 S. 50°00' W.



MAP OF PARTS OF SUB-LOTS 9 & 10
 DEBRACY SUB'N. NO. 1 Vol. 17 Pg. 8
 ORIG. LOT 5 BLACK RIVER TWP.
 LORAIN COUNTY OHIO
 SCALE: 1"=40' FEB. 8-1964 2:30 P.M.
 Gary E. Penfound REG. SURVEYOR

Irving L. & Ruth B. Rothman

02-03-005