


03-00-0229-106-048  
03-00-029-80  
SCAN # 45238

SHEFFIELD ROAD 50'

ctr. of Pole  
2'-2" South  
0'-11" West  
of P/L's

7' OHIO EDISON EASEMENT

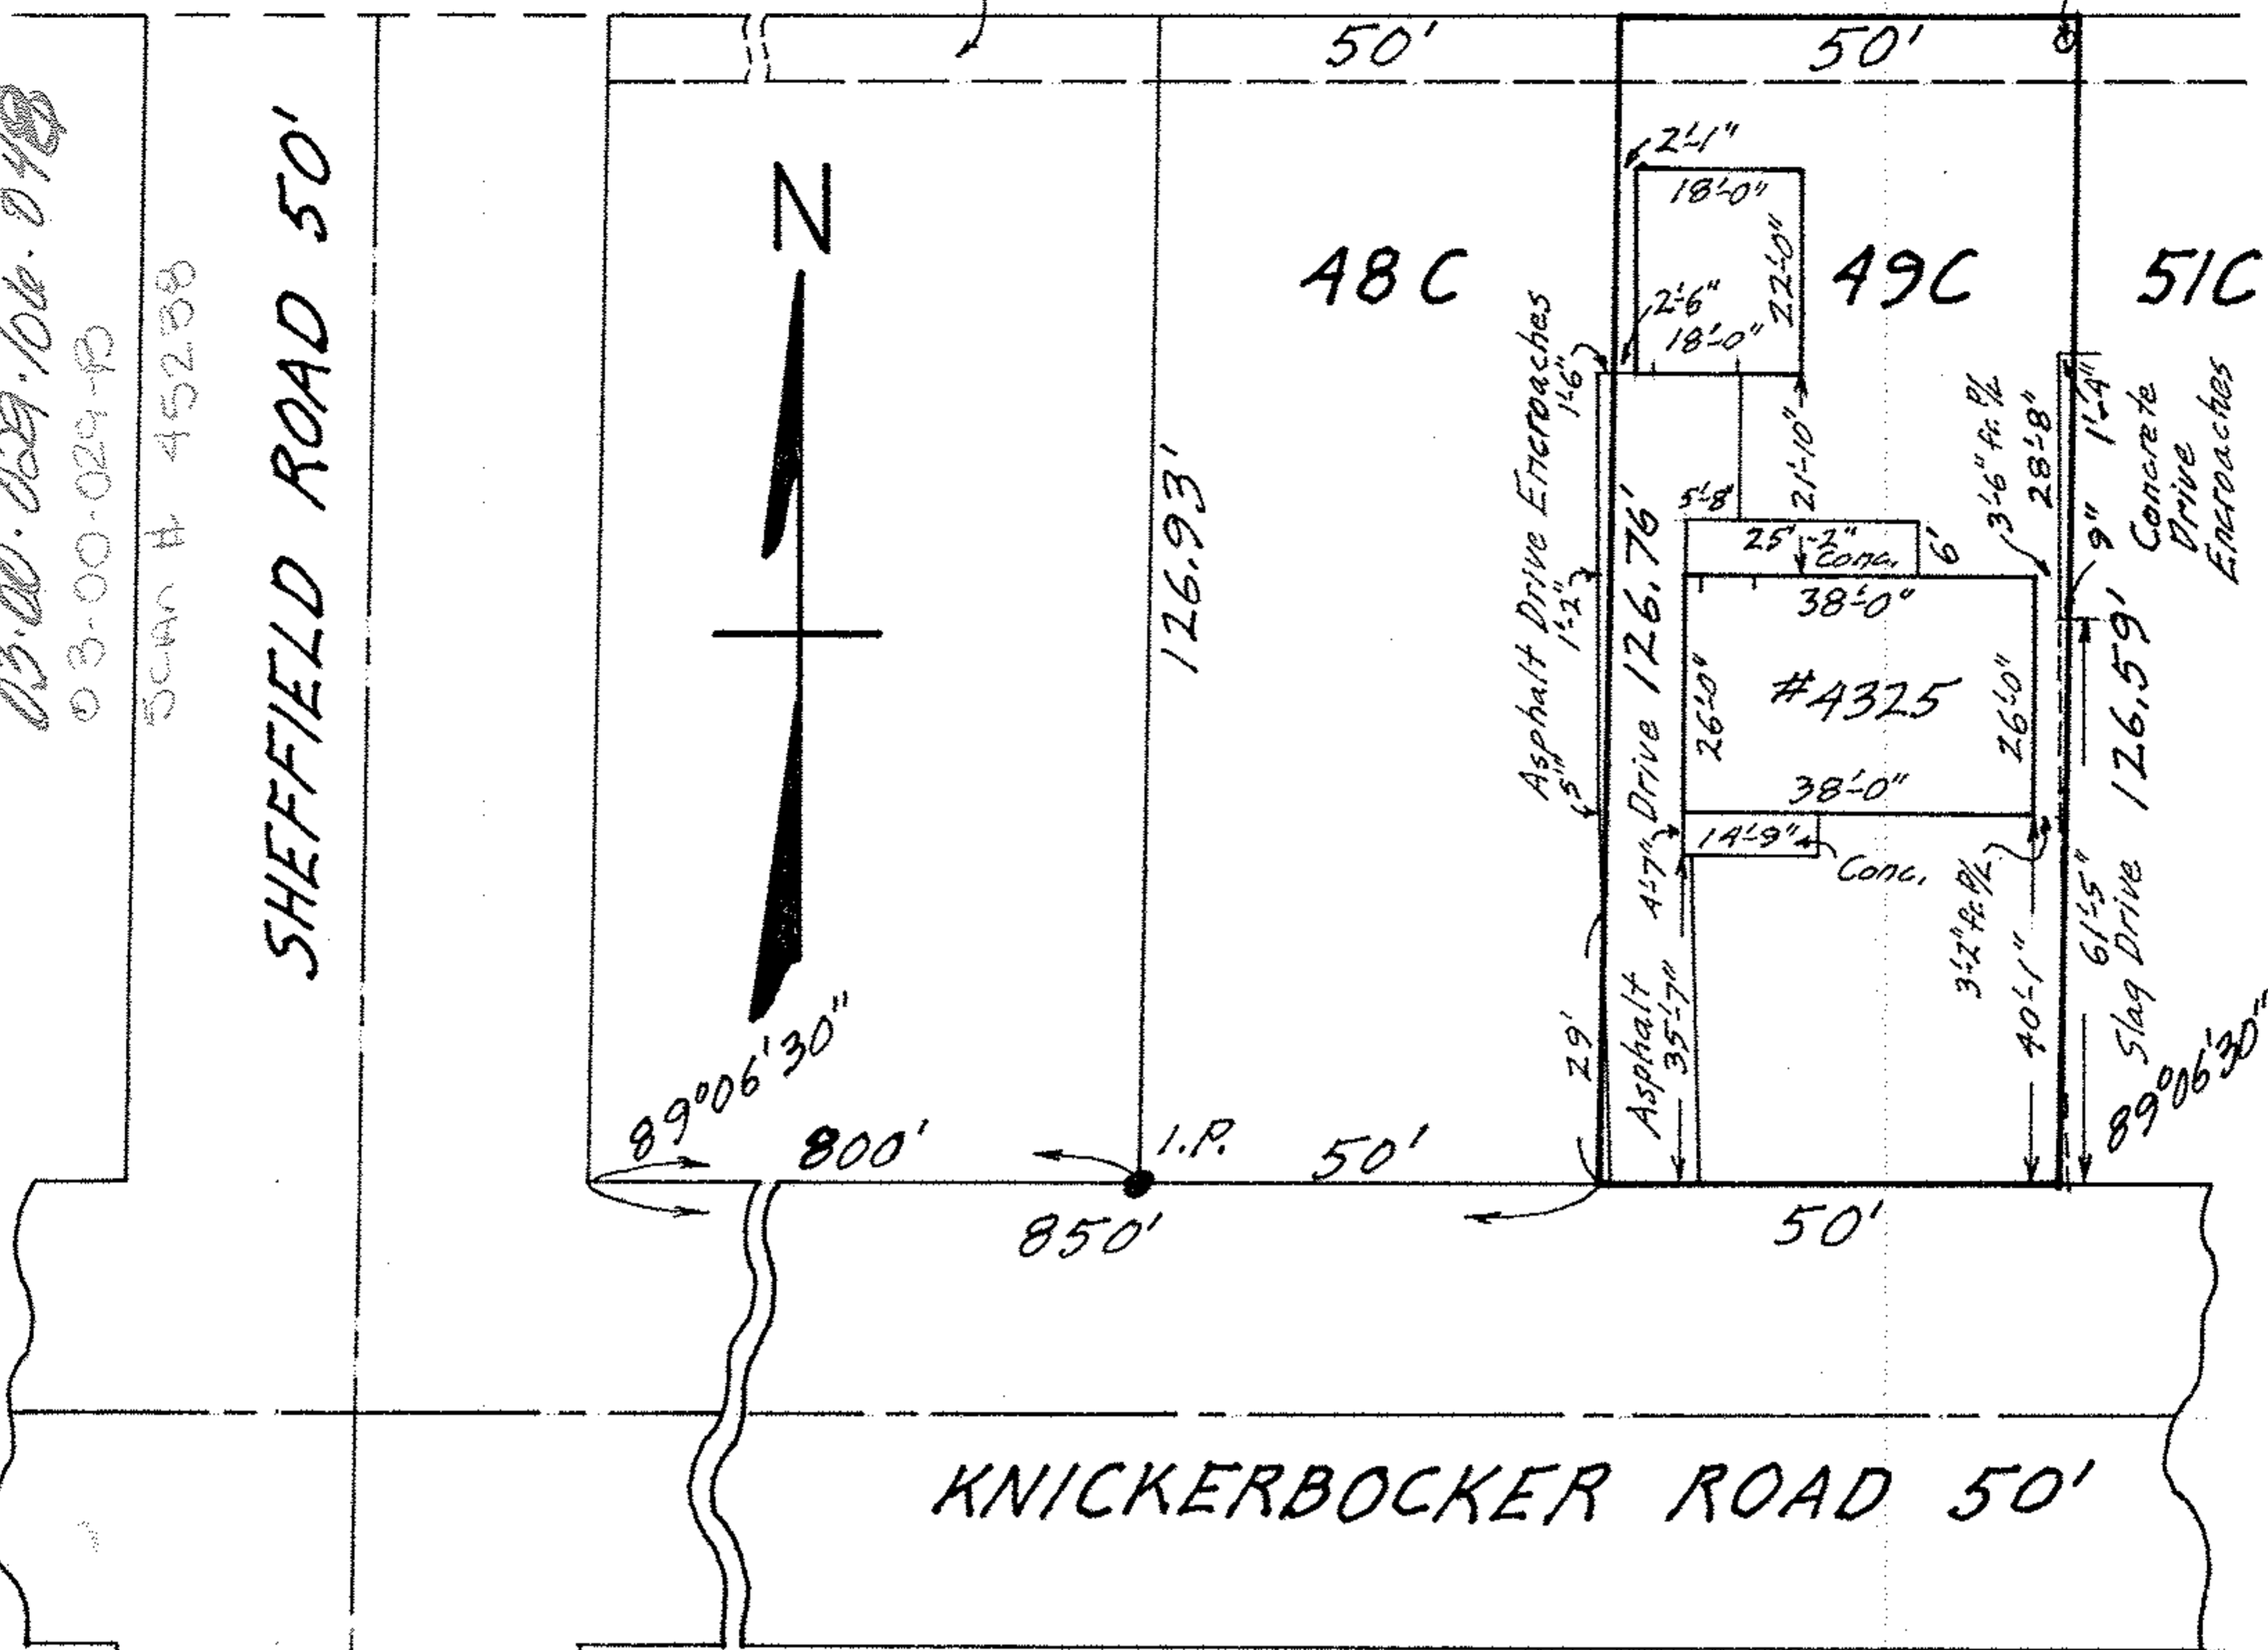

KNICKERBOCKER ROAD 50'

Colonial Title Corporation  
L-4942 Karhusz to McDermott

MAP OF SUB-LOT NO. 49C

KNICKERBOCKER ROAD SUB'N. VOL. 22 PG. 64

ORIG. LOT 29 SHEFFIELD TWP.

SHEFFIELD LAKE CITY - LORAIN COUNTY - OHIO

SCALE: 1" = 30' MAR. 22-1969 4:00 P.M.

Gary E. Penfound REG. SURVEYOR

03-00-0229-106-048  
03-00-029-80  
SCAN # 45238