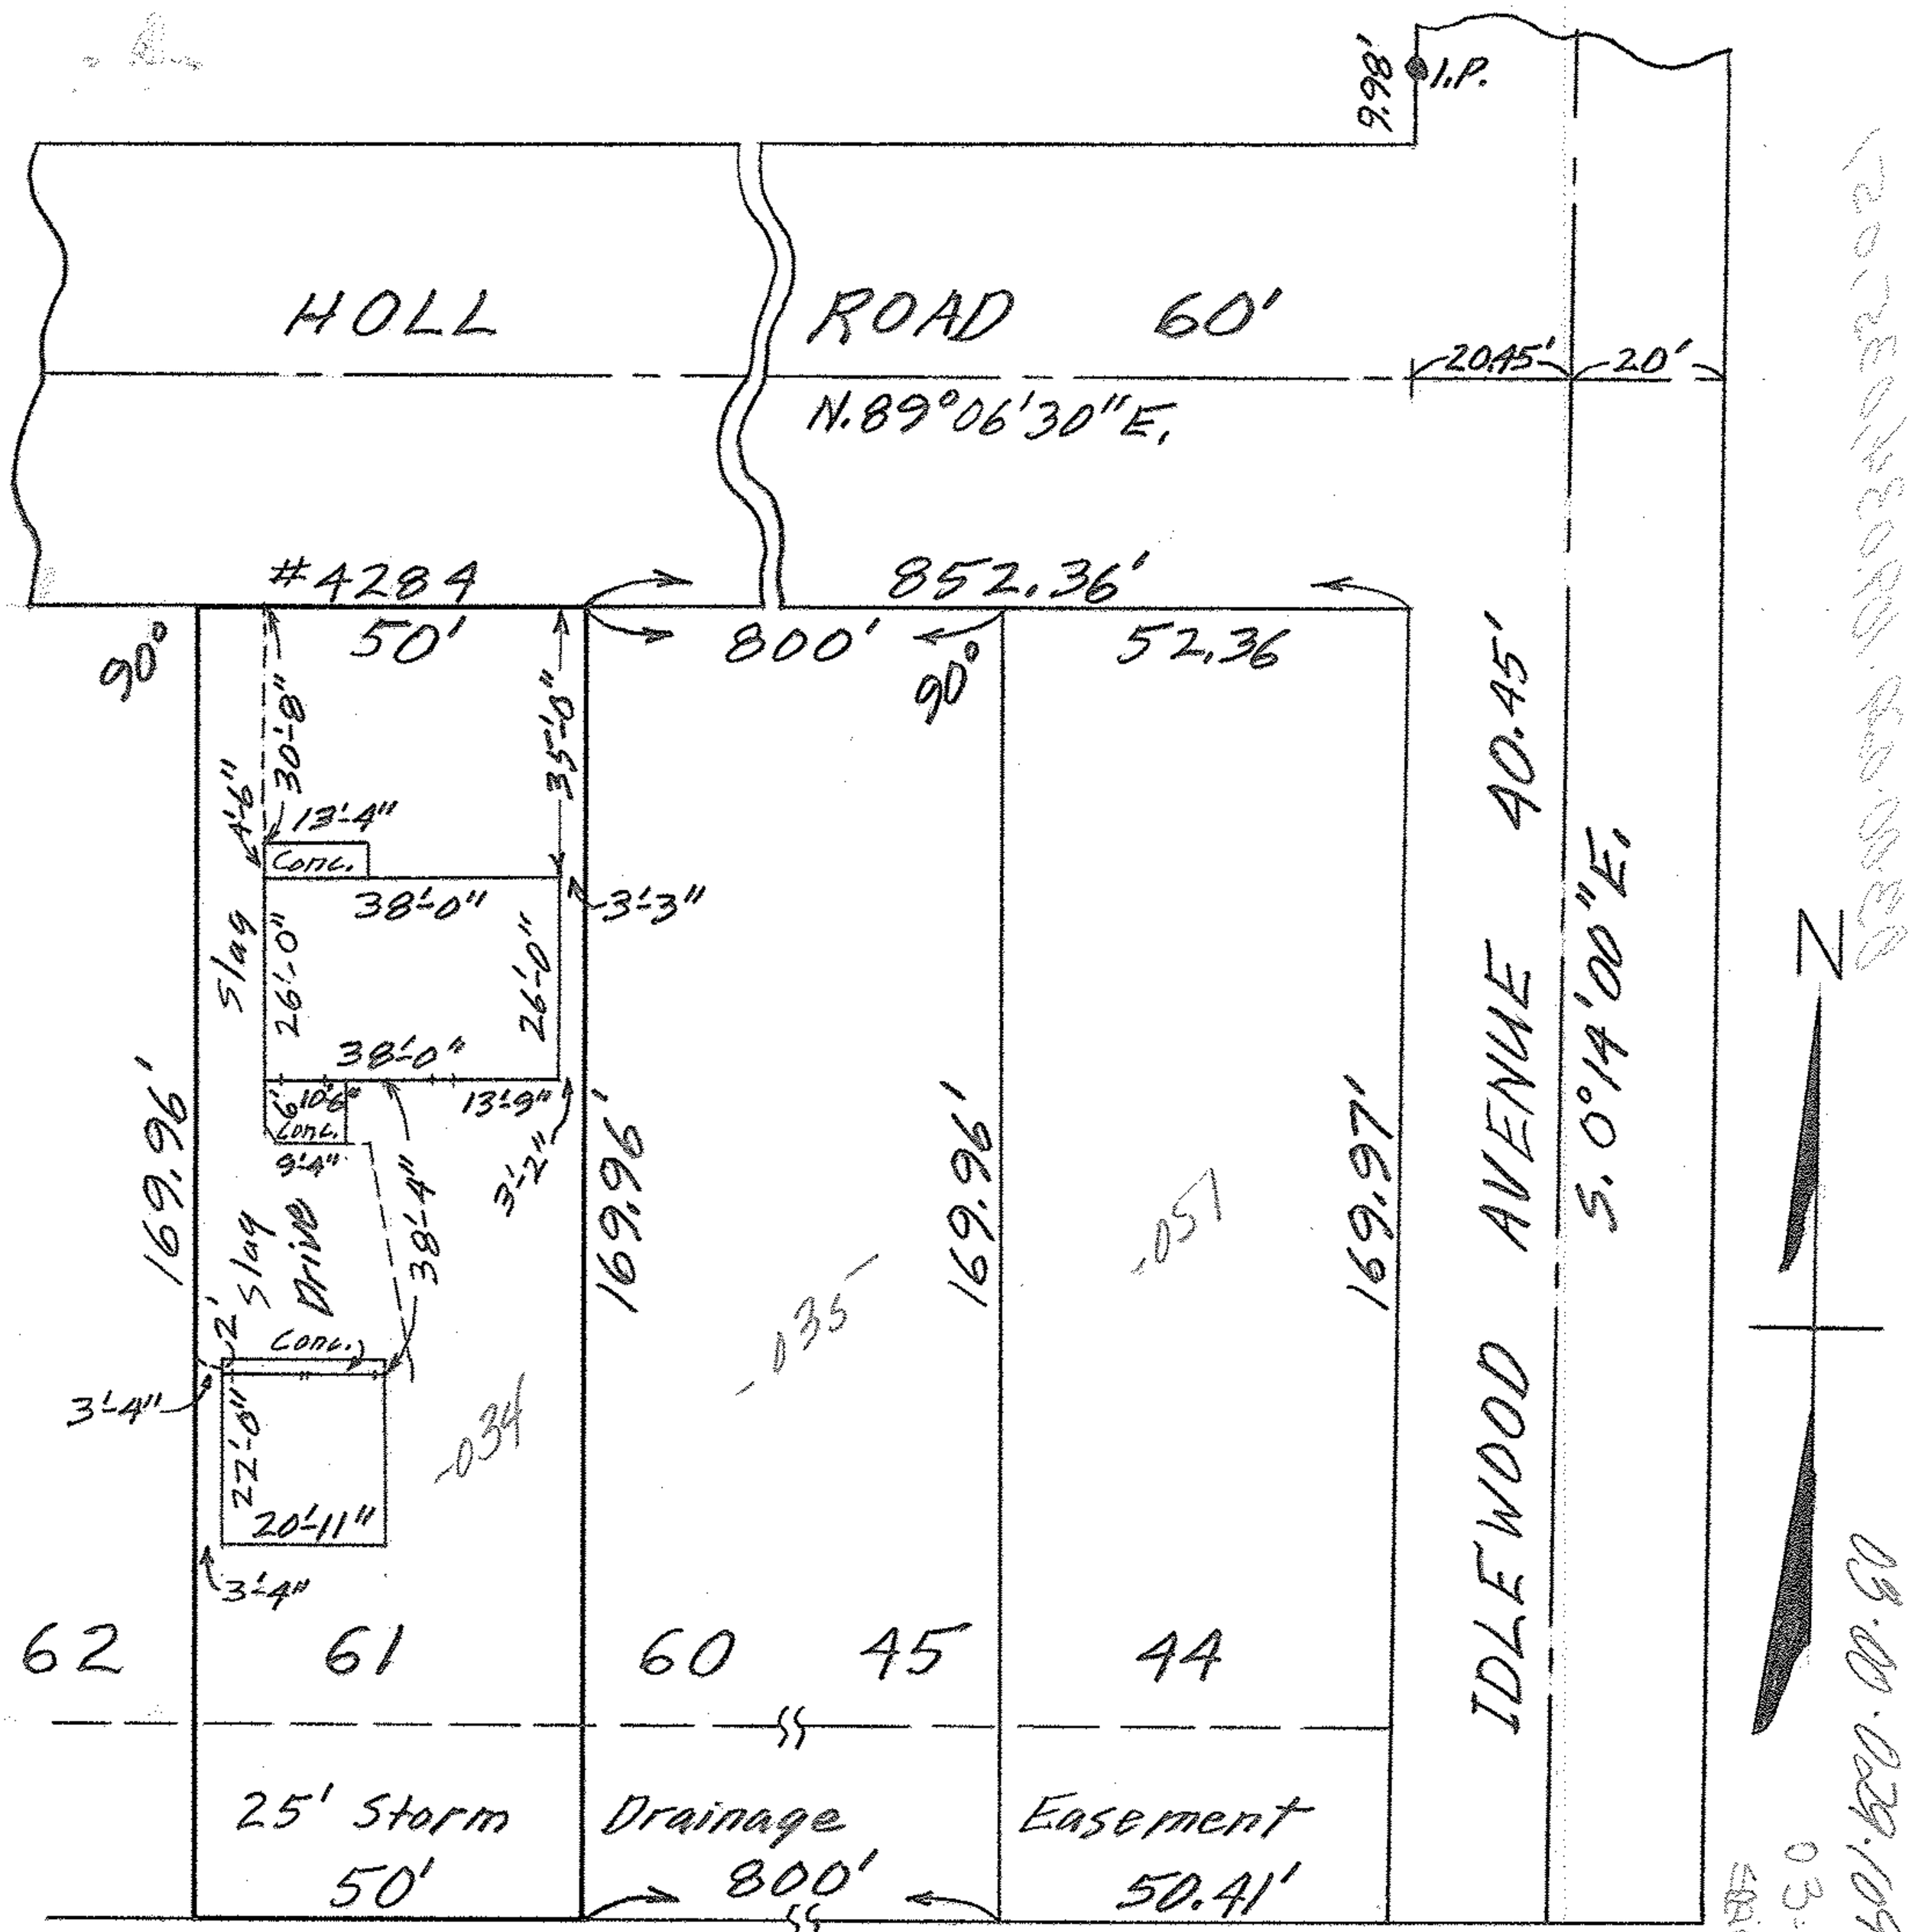

MAP OF SUB-LOT NO. 61
HOLL ROAD SUB'N. Vol. 22 Pg. 80
ORIG. LOT 29 SHEFFIELD TWP.
SHEFFIELD LAKE CITY - LORAIN CO. - OHIO
SCALE: 1" = 30' NOV. 11 - 1965 11:30 A.M.
Gary E. Penfound for C.E. Penfound REG. SURVEYORS
GL-1353 Tom & Norma Crnko