03-00-033-18-005, 006

Scan # 45246

03-00-033-B

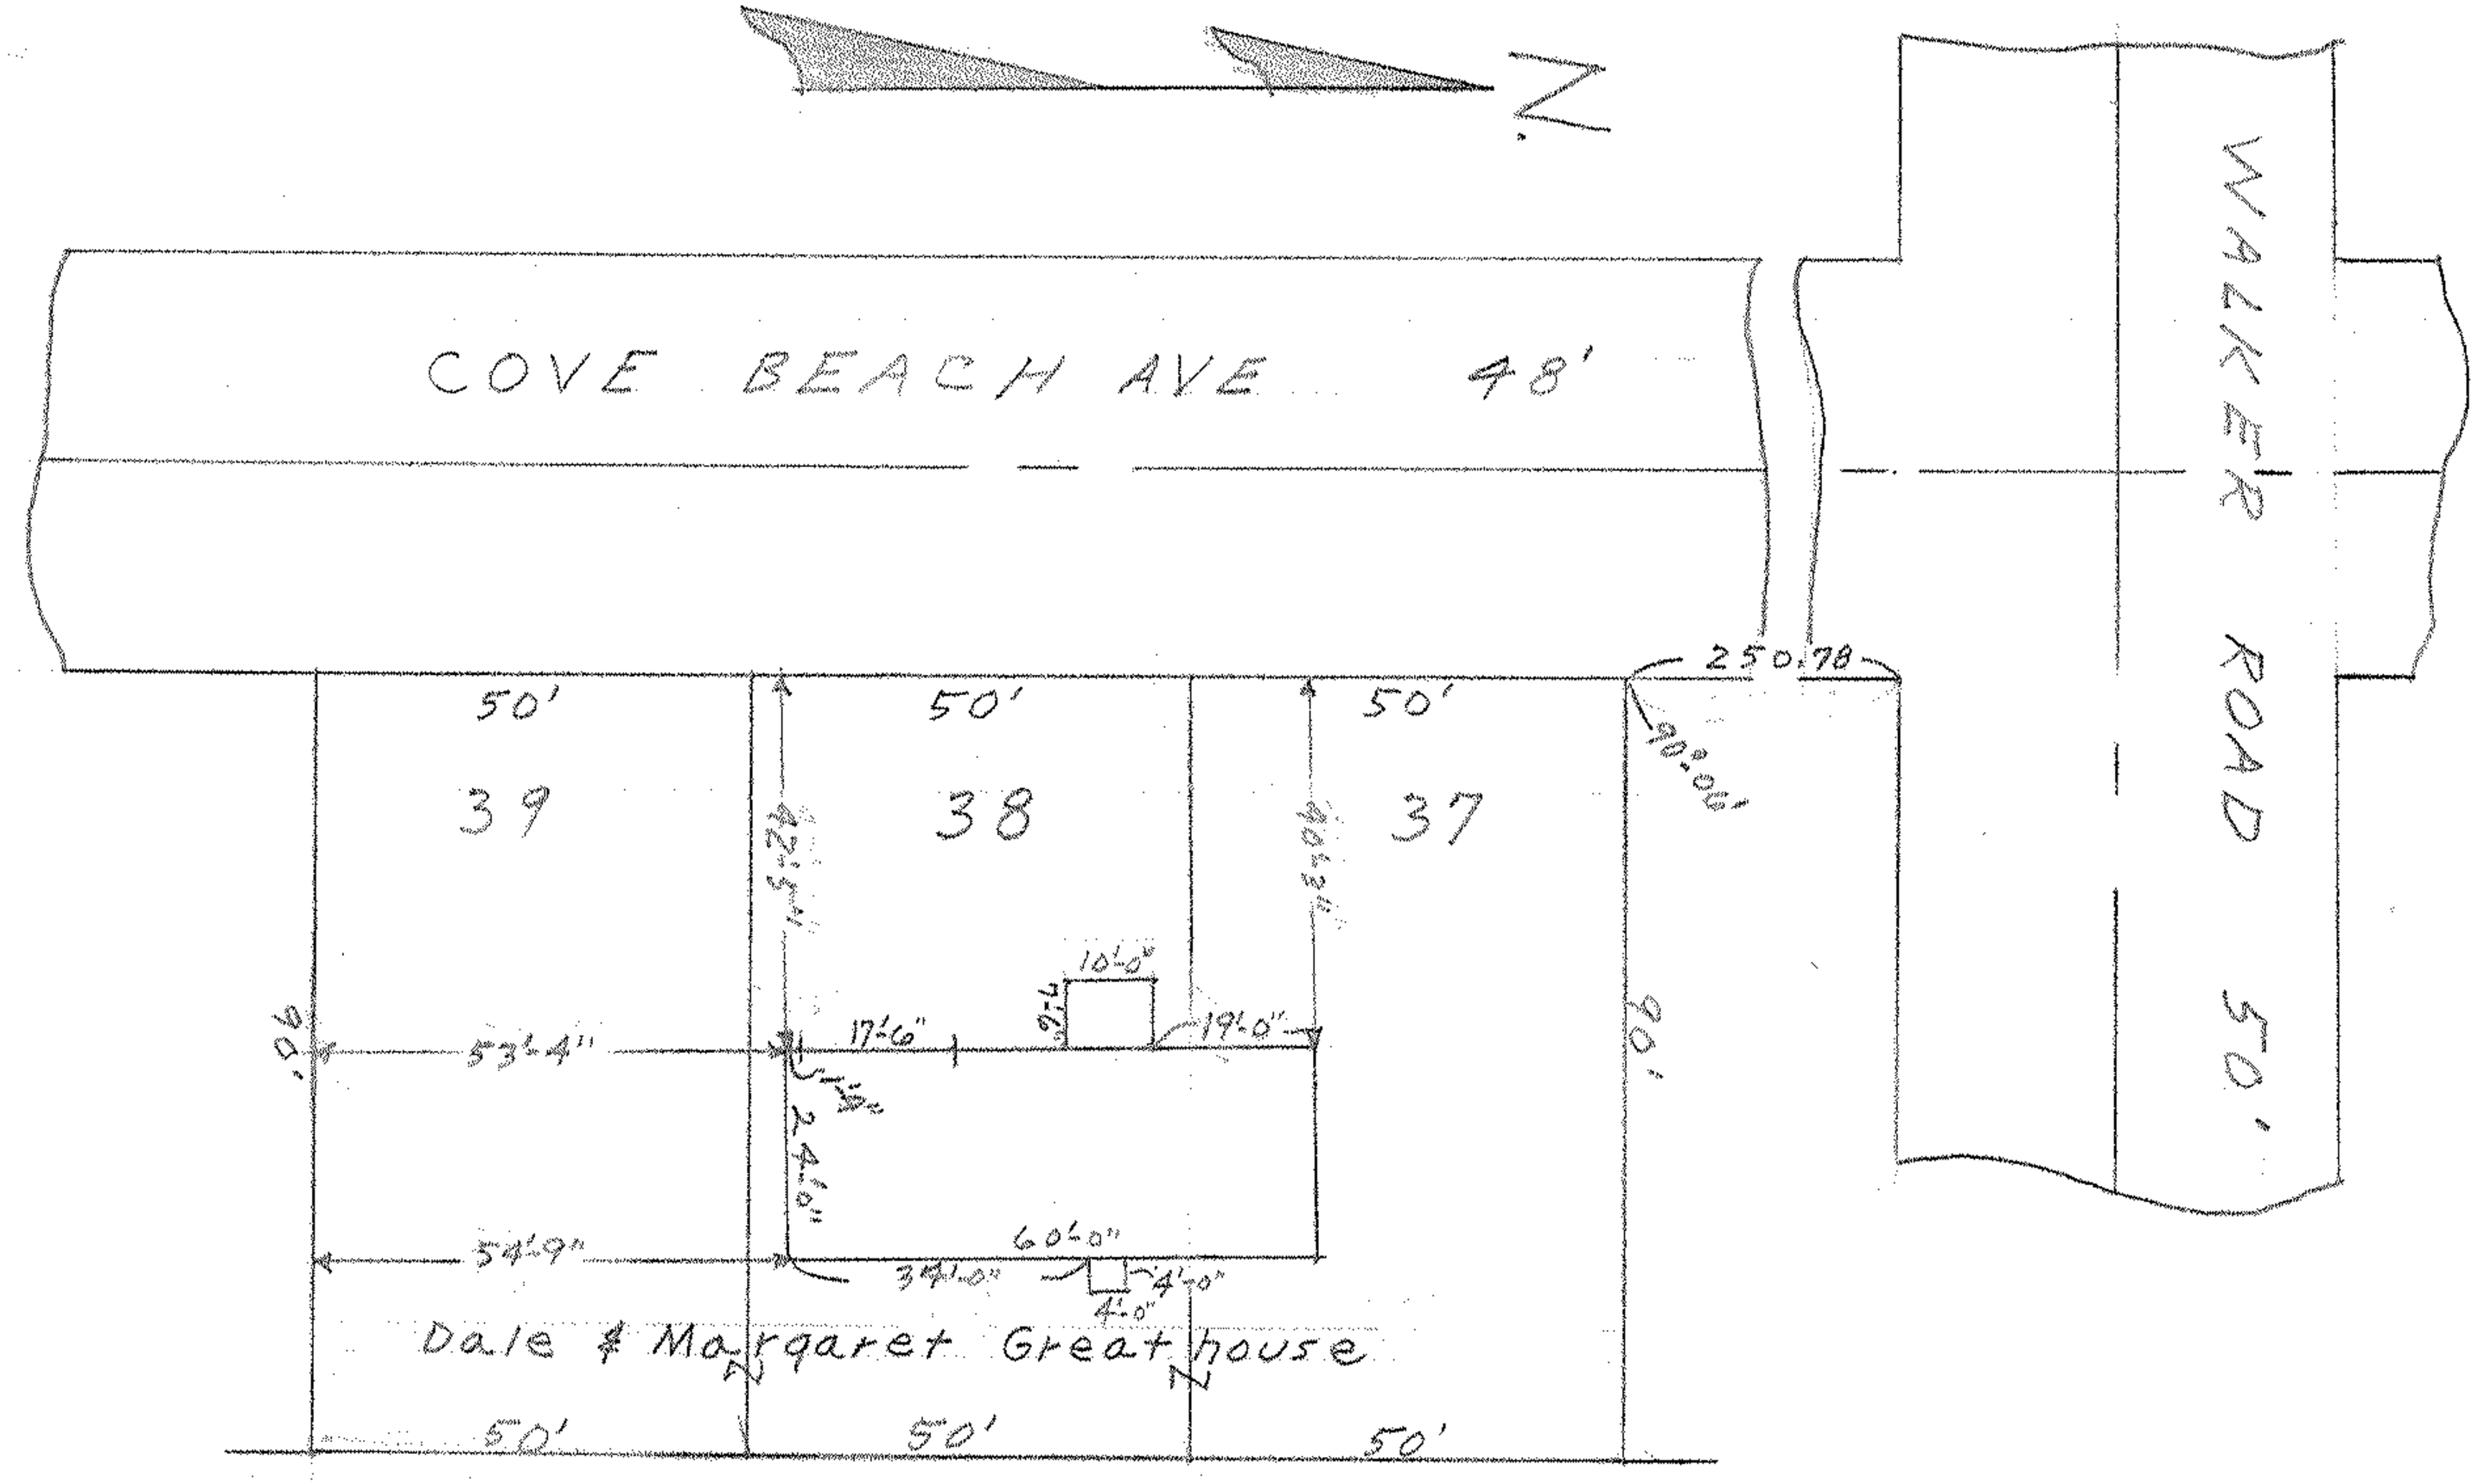

MAP of SUB-LOTS 37, 38, 39
COVE BEACH ALL'T Vol. 11, Pg. 11
O.L. 33 SHEFFIELD TWP.
SHEFFIELD LAKE VILL. - LORAIN COUNTY - OHIO
SCALE: 1" = 30' MAY 1, 1958 3:00 P.M.

Barry E. Rayhound
for E.E. Penfound
REG. SURVEYORS

WW

ORDER NO. 6360