


NORTH

LAKE ROAD- 60'

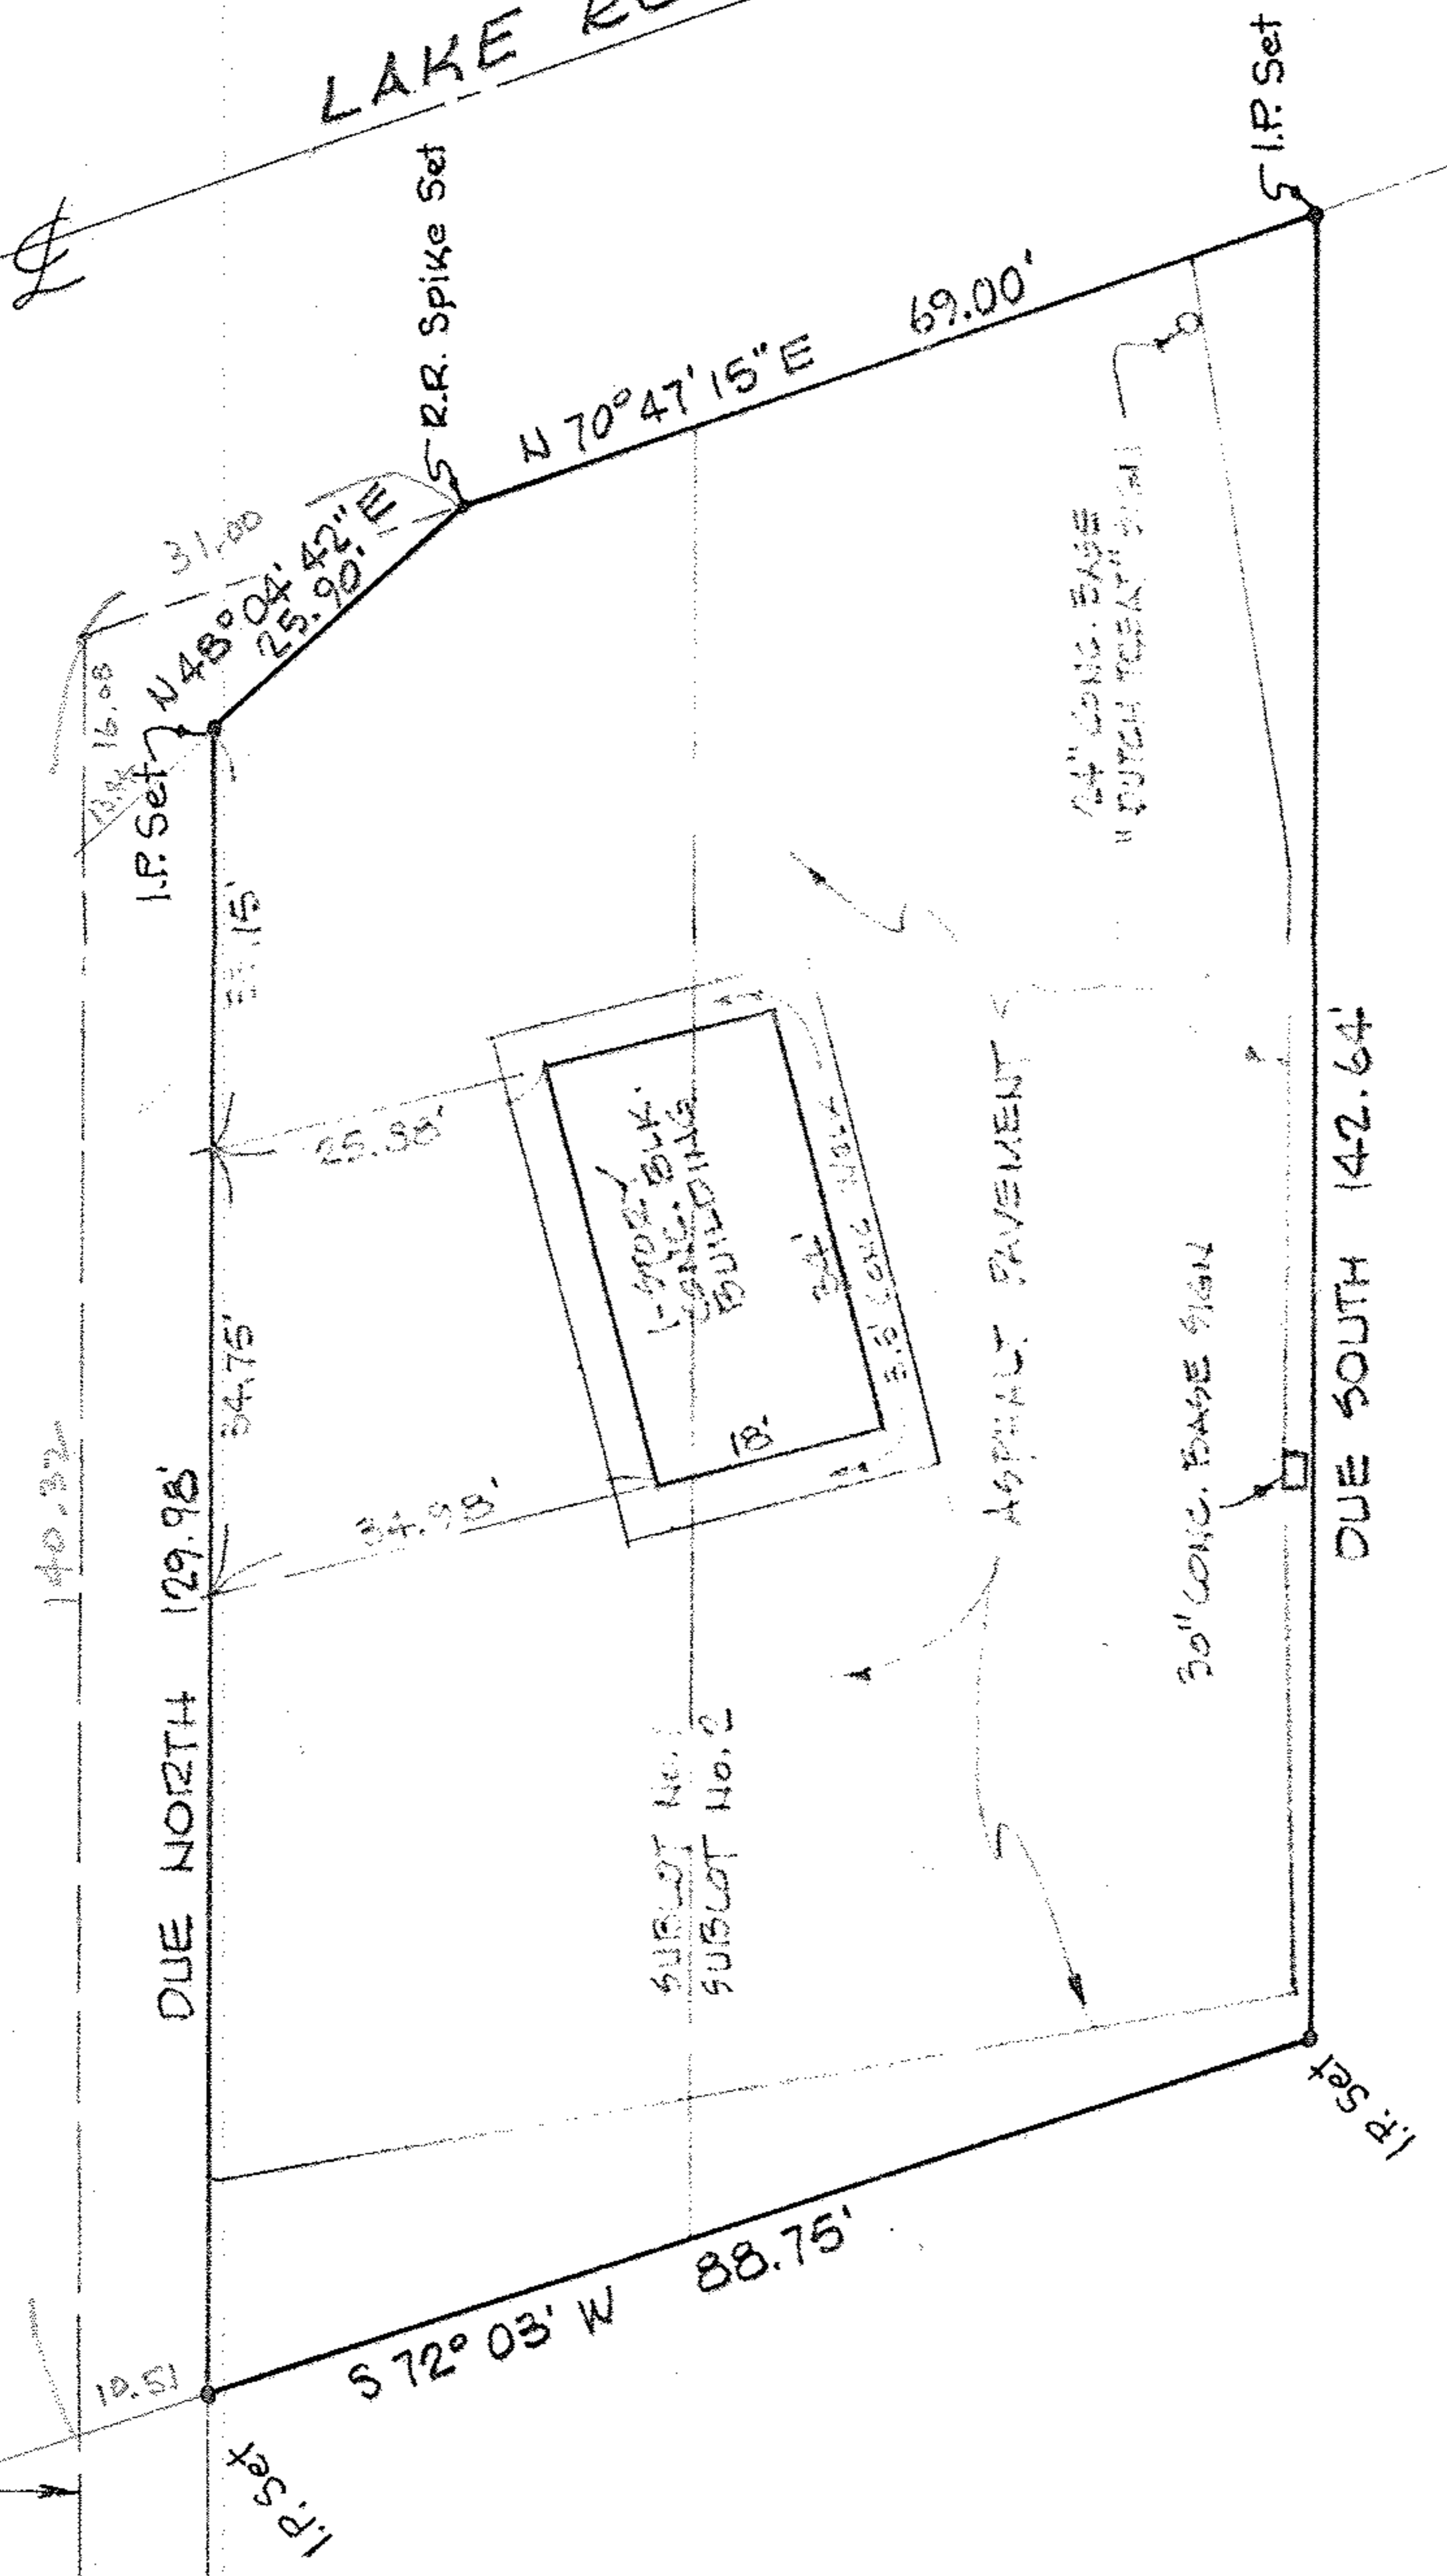

MAP of SURVEY

PREPARED FOR GEORGE FRAM

PART of SUBLOT No.1 and ALL of SUBLOT No.2 in SUNSET COUNTRY CLUBS ALLOTMENT (BLOCK-B) - PLAT VOL.11, Pg.6