Scan # 45248 03-00-033-A 09-00-033-112-004

MAP OF SUB-LOT NO. 7 OF COVE BEACH ALL'T. VOL. 11 PAGE 11 PLAT RECORDS AND PART OF ORIGINAL LOT NO. 33 SHEFFIELD TWP. - SHEFFIELD LAKE VILL. LORAIN COUNTY OHIO

SCALE: 1" = 30' OCT. 2-1964 6:30 P.M.

Gary E. Penfound REG. SURVEYOR

Frank & Helen Mick

Rose & Mary E. Cotabish
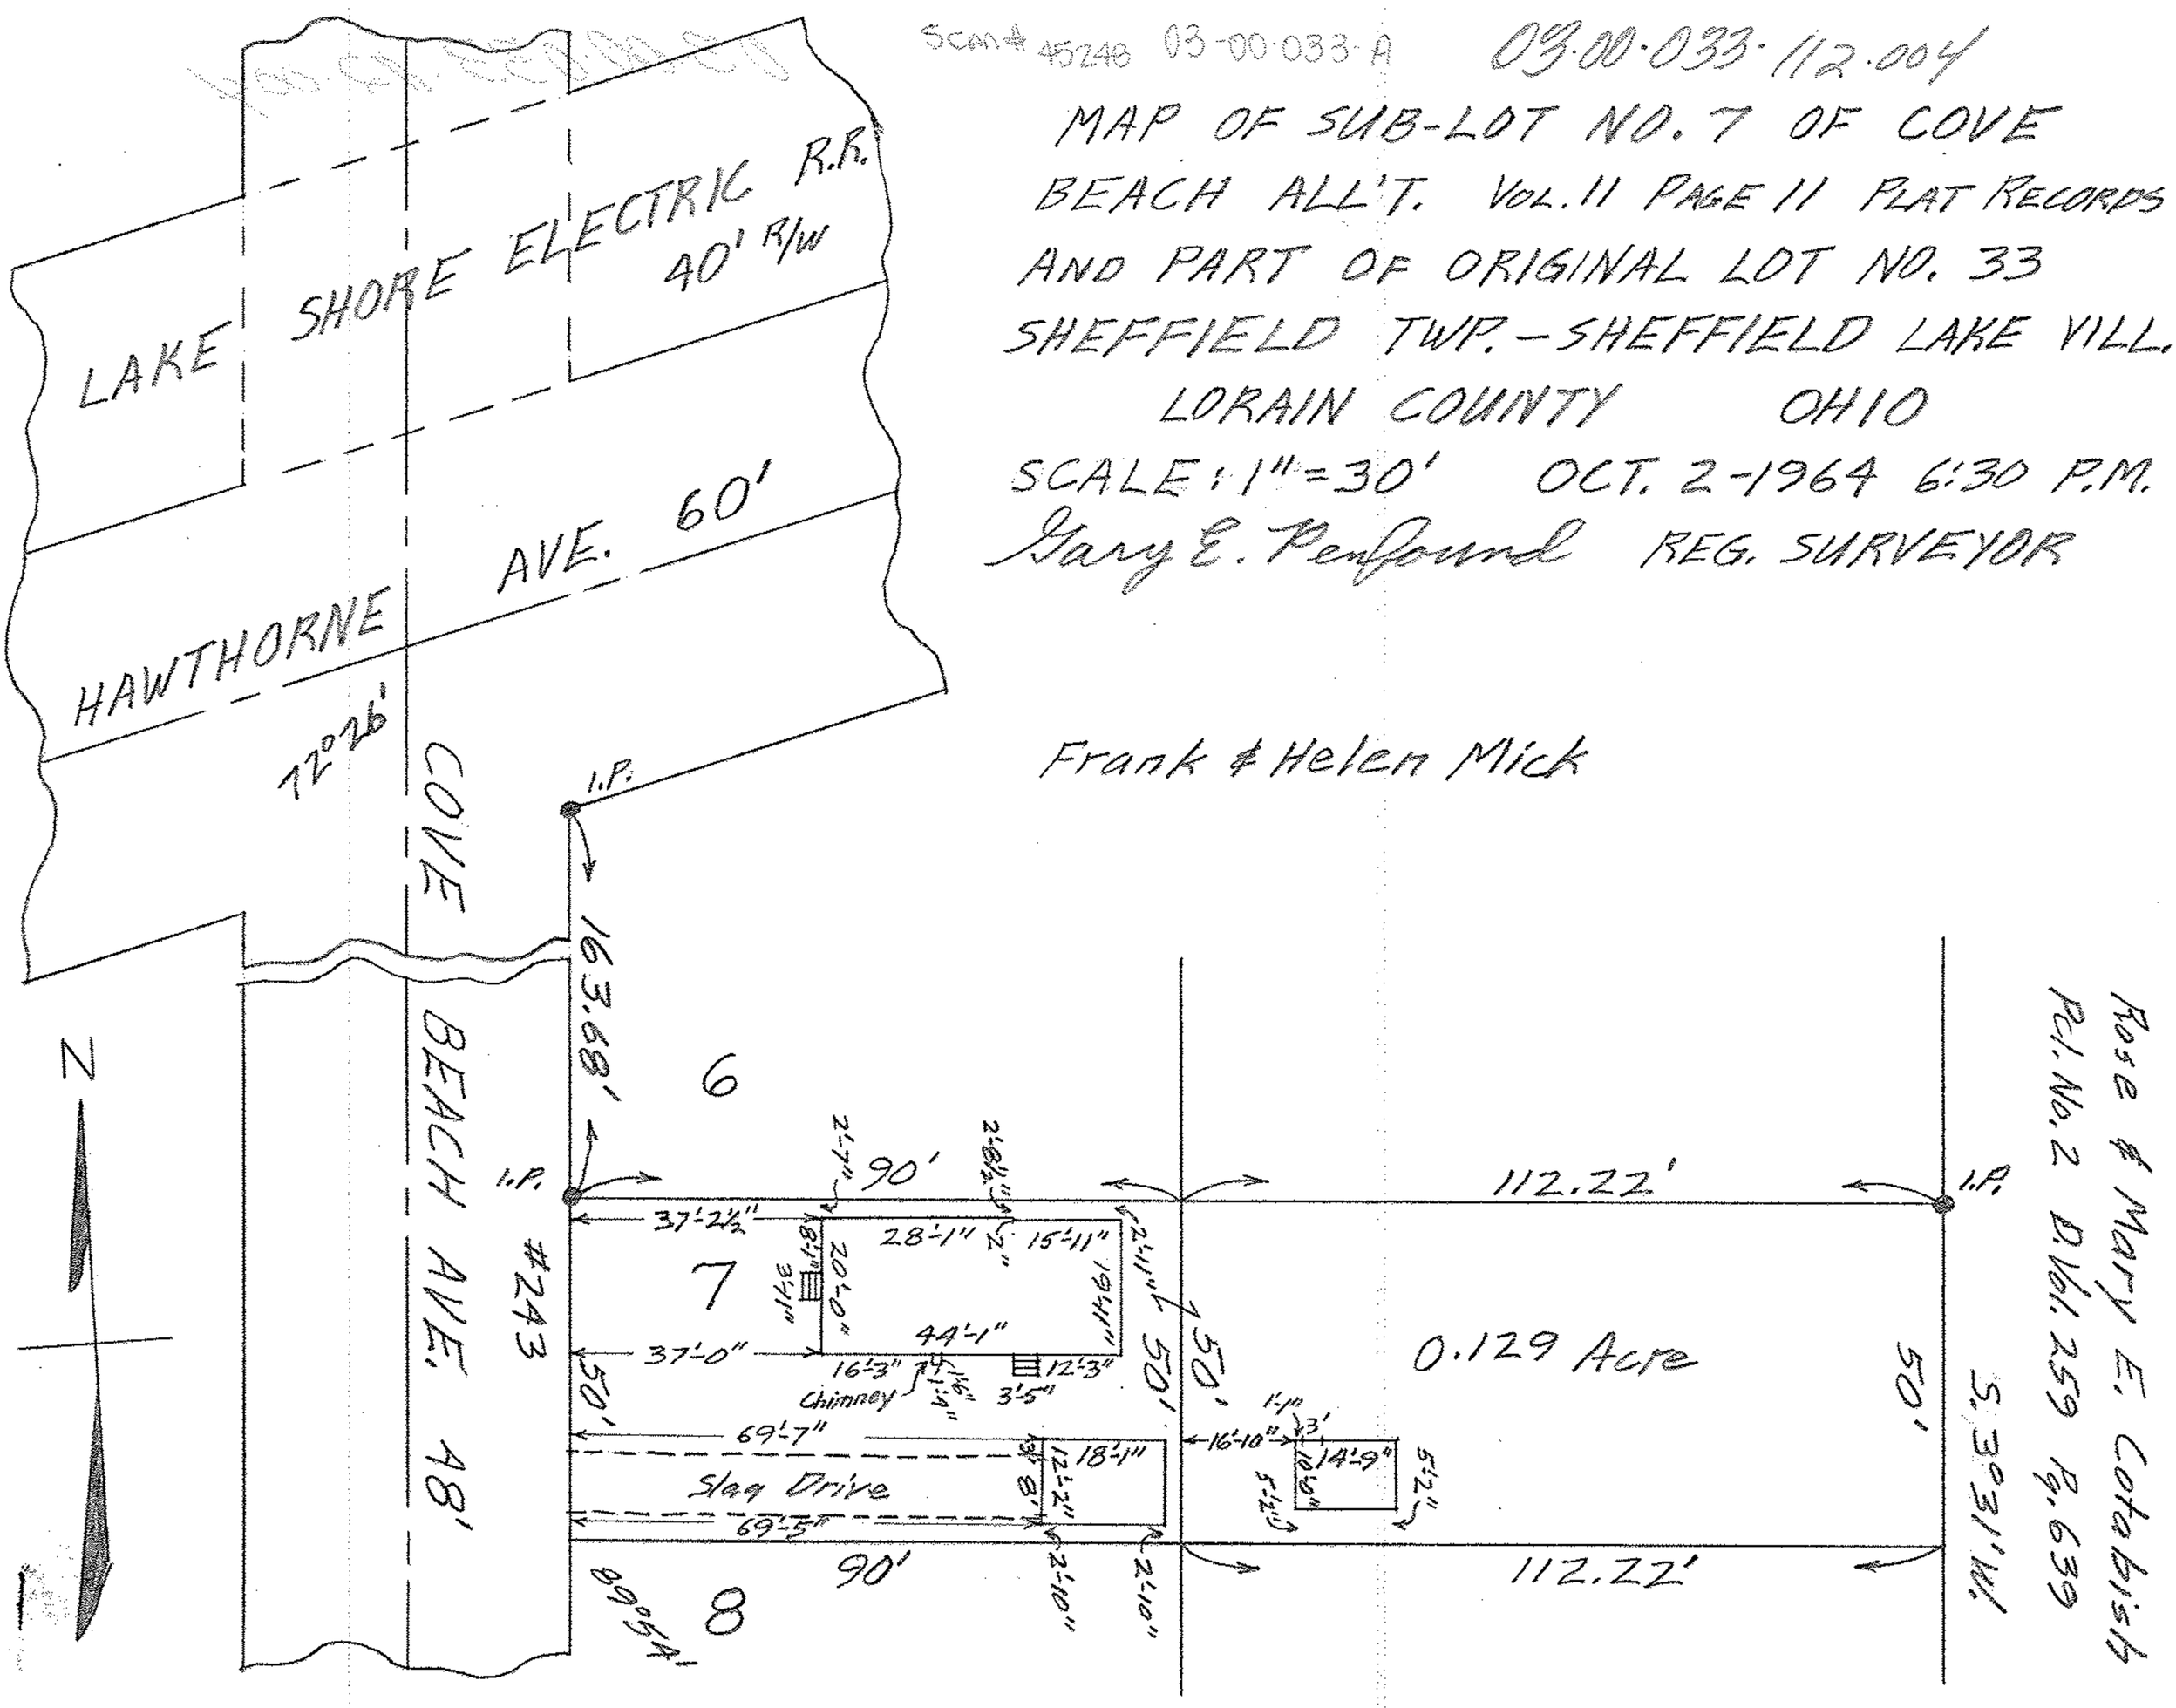
Pcl. No. 2 O.R. 259 P. 639