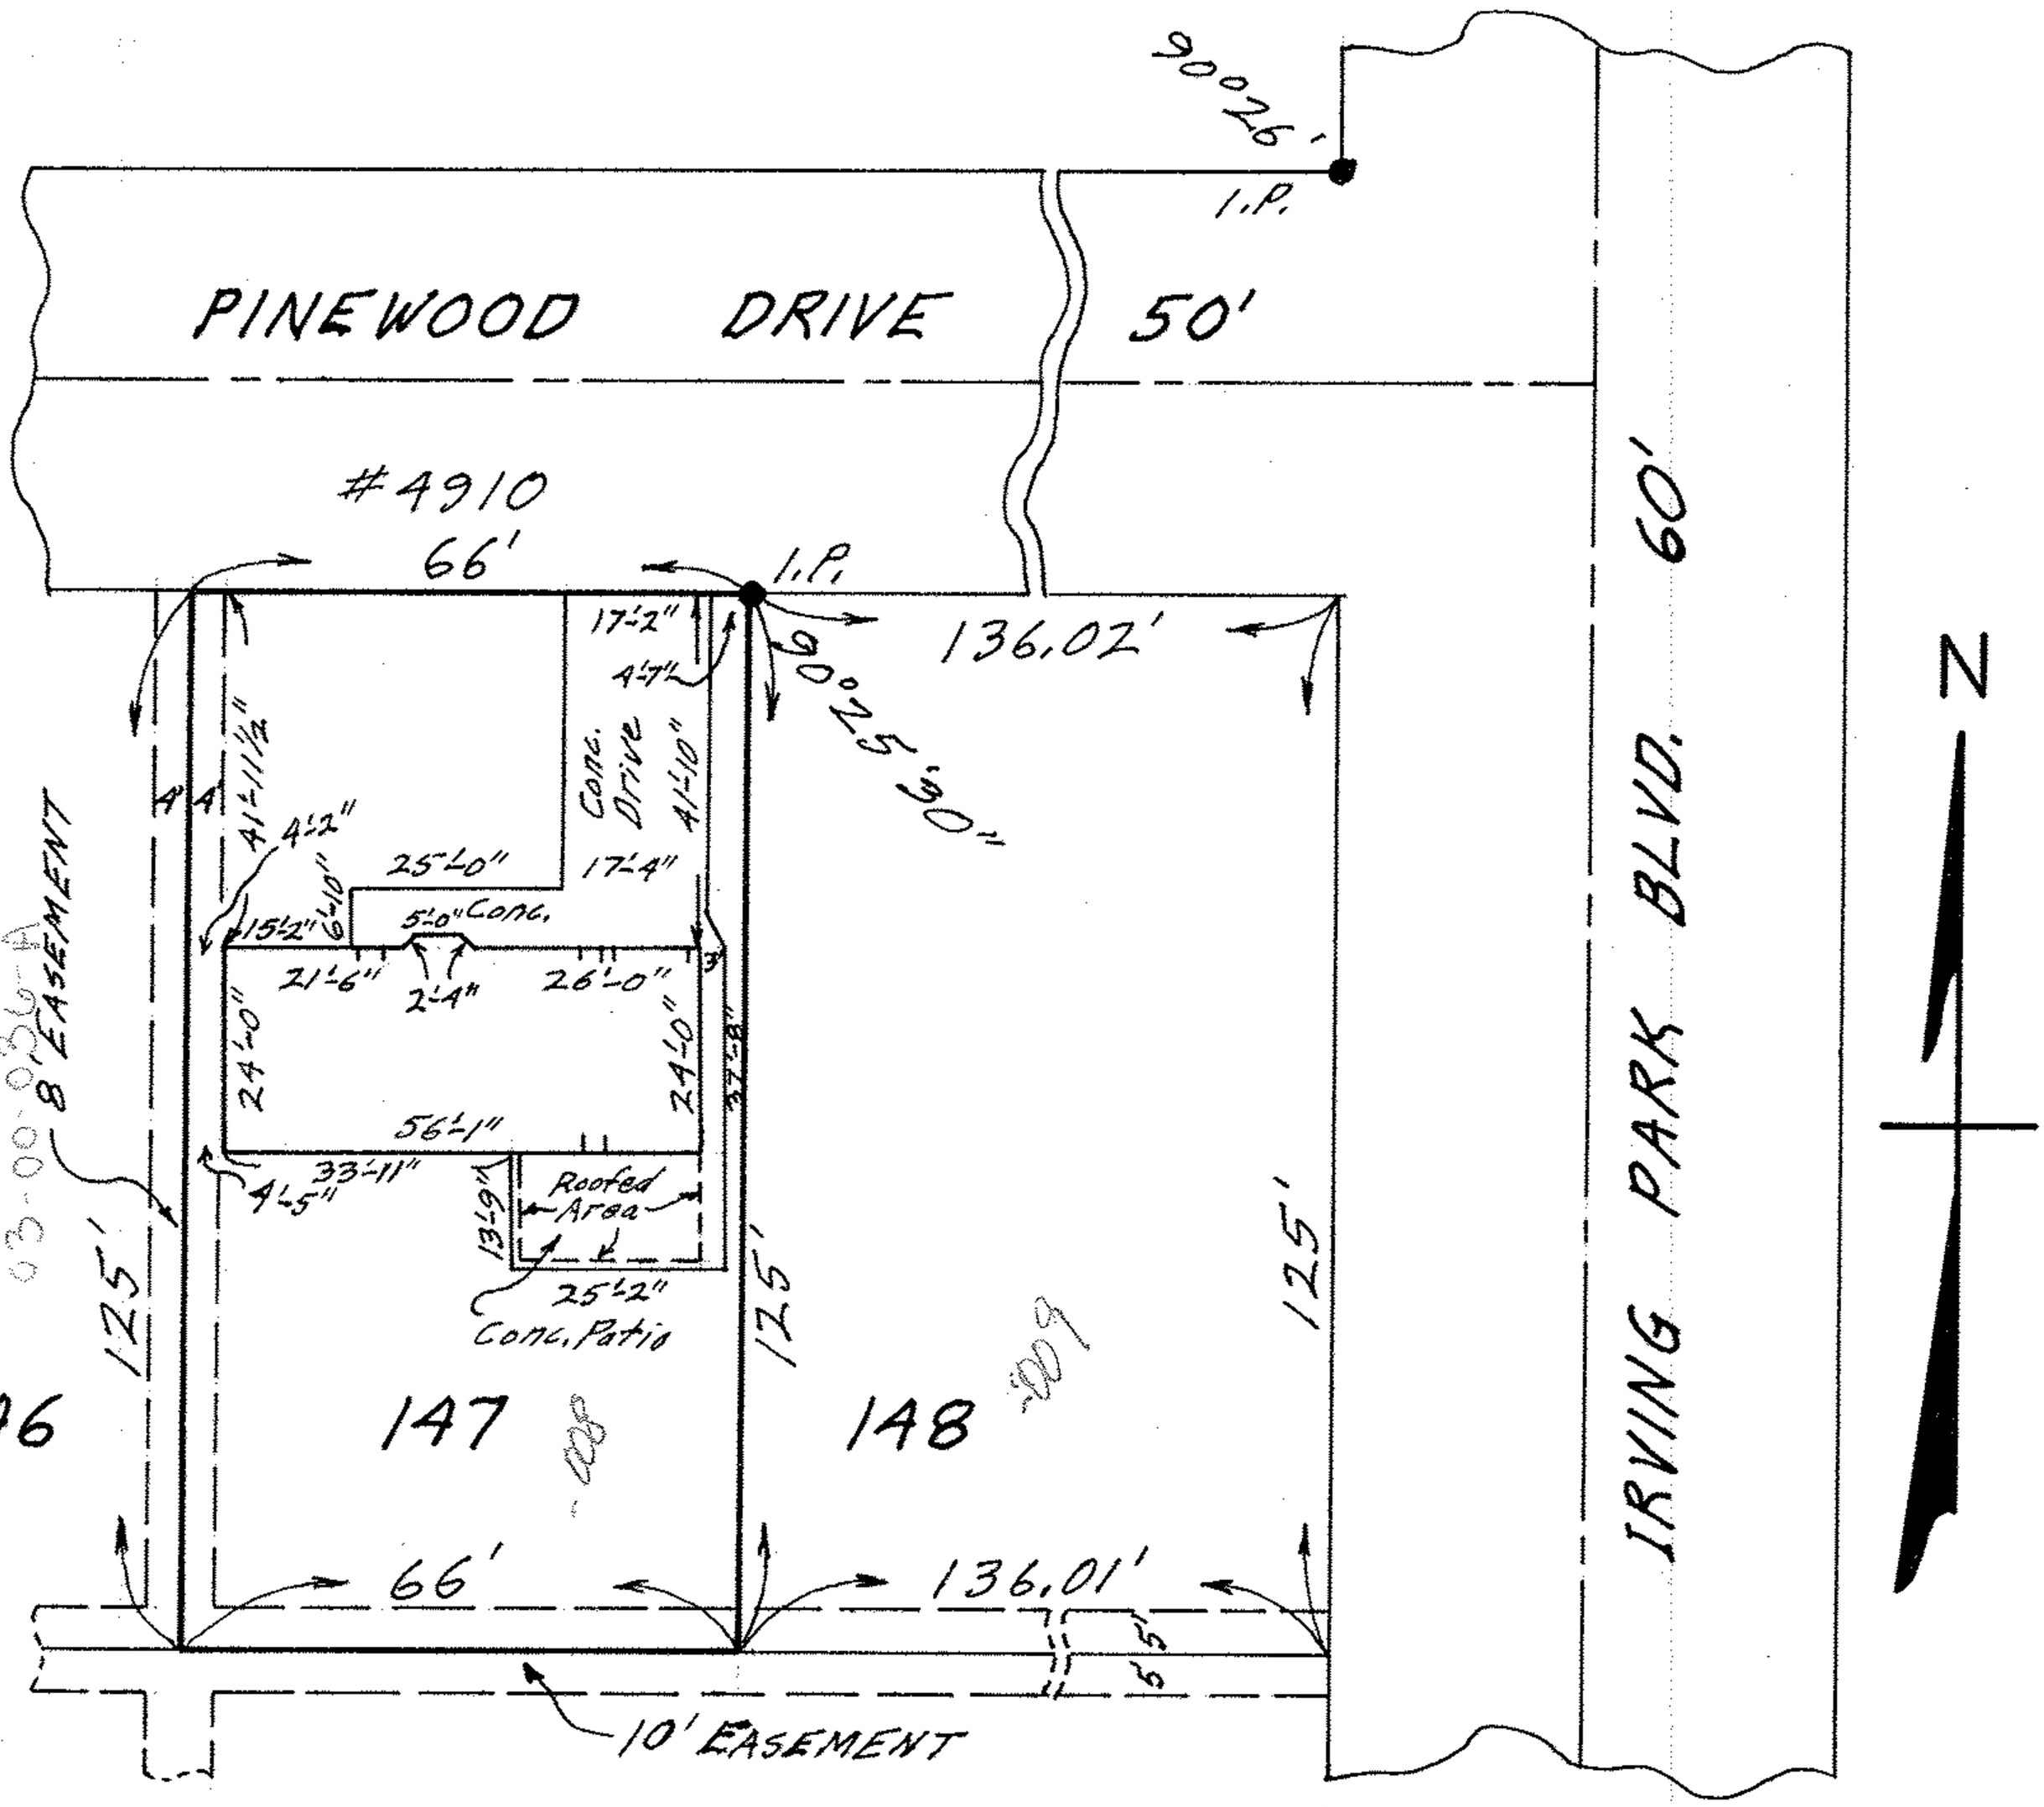

MAP OF SUB-LOT NO. 147

PADWAY ALL'T. SECOND ADD'N. VOL. 17 PG. 16

ORIG. LOT NO. 36 SHEFFIELD TOWNSHIP

SHEFFIELD LAKE CITY - LORAIN COUNTY - OHIO

SCALE: 1"=30' OCTOBER 11-1969 3:30 P.M.

NOTE: There are no encroachments on the above property.

Gary E. Penfound REG. SURVEYOR NO. 4457

CITY TITLE Co. Order No. E-878-9

Walton J. & Iona L. Dean to

Richard J. & Jayne E. Futchko