03-00-039.103.029, 031, 042

03-00-039-A
scan# 45259

MAP OF SUB-LOTS NOS. 52, 53 & 54 OF BLOCK "A" AND ANOTHER PART OF ORIGINAL LOT NO. 39 OF SHEFFIELD TWP. IN CLEVELAND BEACH SUB'N.

VOL. 9 PG. 30 PLATS

SHEFFIELD LAKE CITY

LORAIN COUNTY OHIO

SCALE: 1" = 40' DEC. 1-1970 4:00 P.M.

NOTE: There are no encroachments on this property.

Gary E. Penfound
REG. SURVEYOR NO. 4457

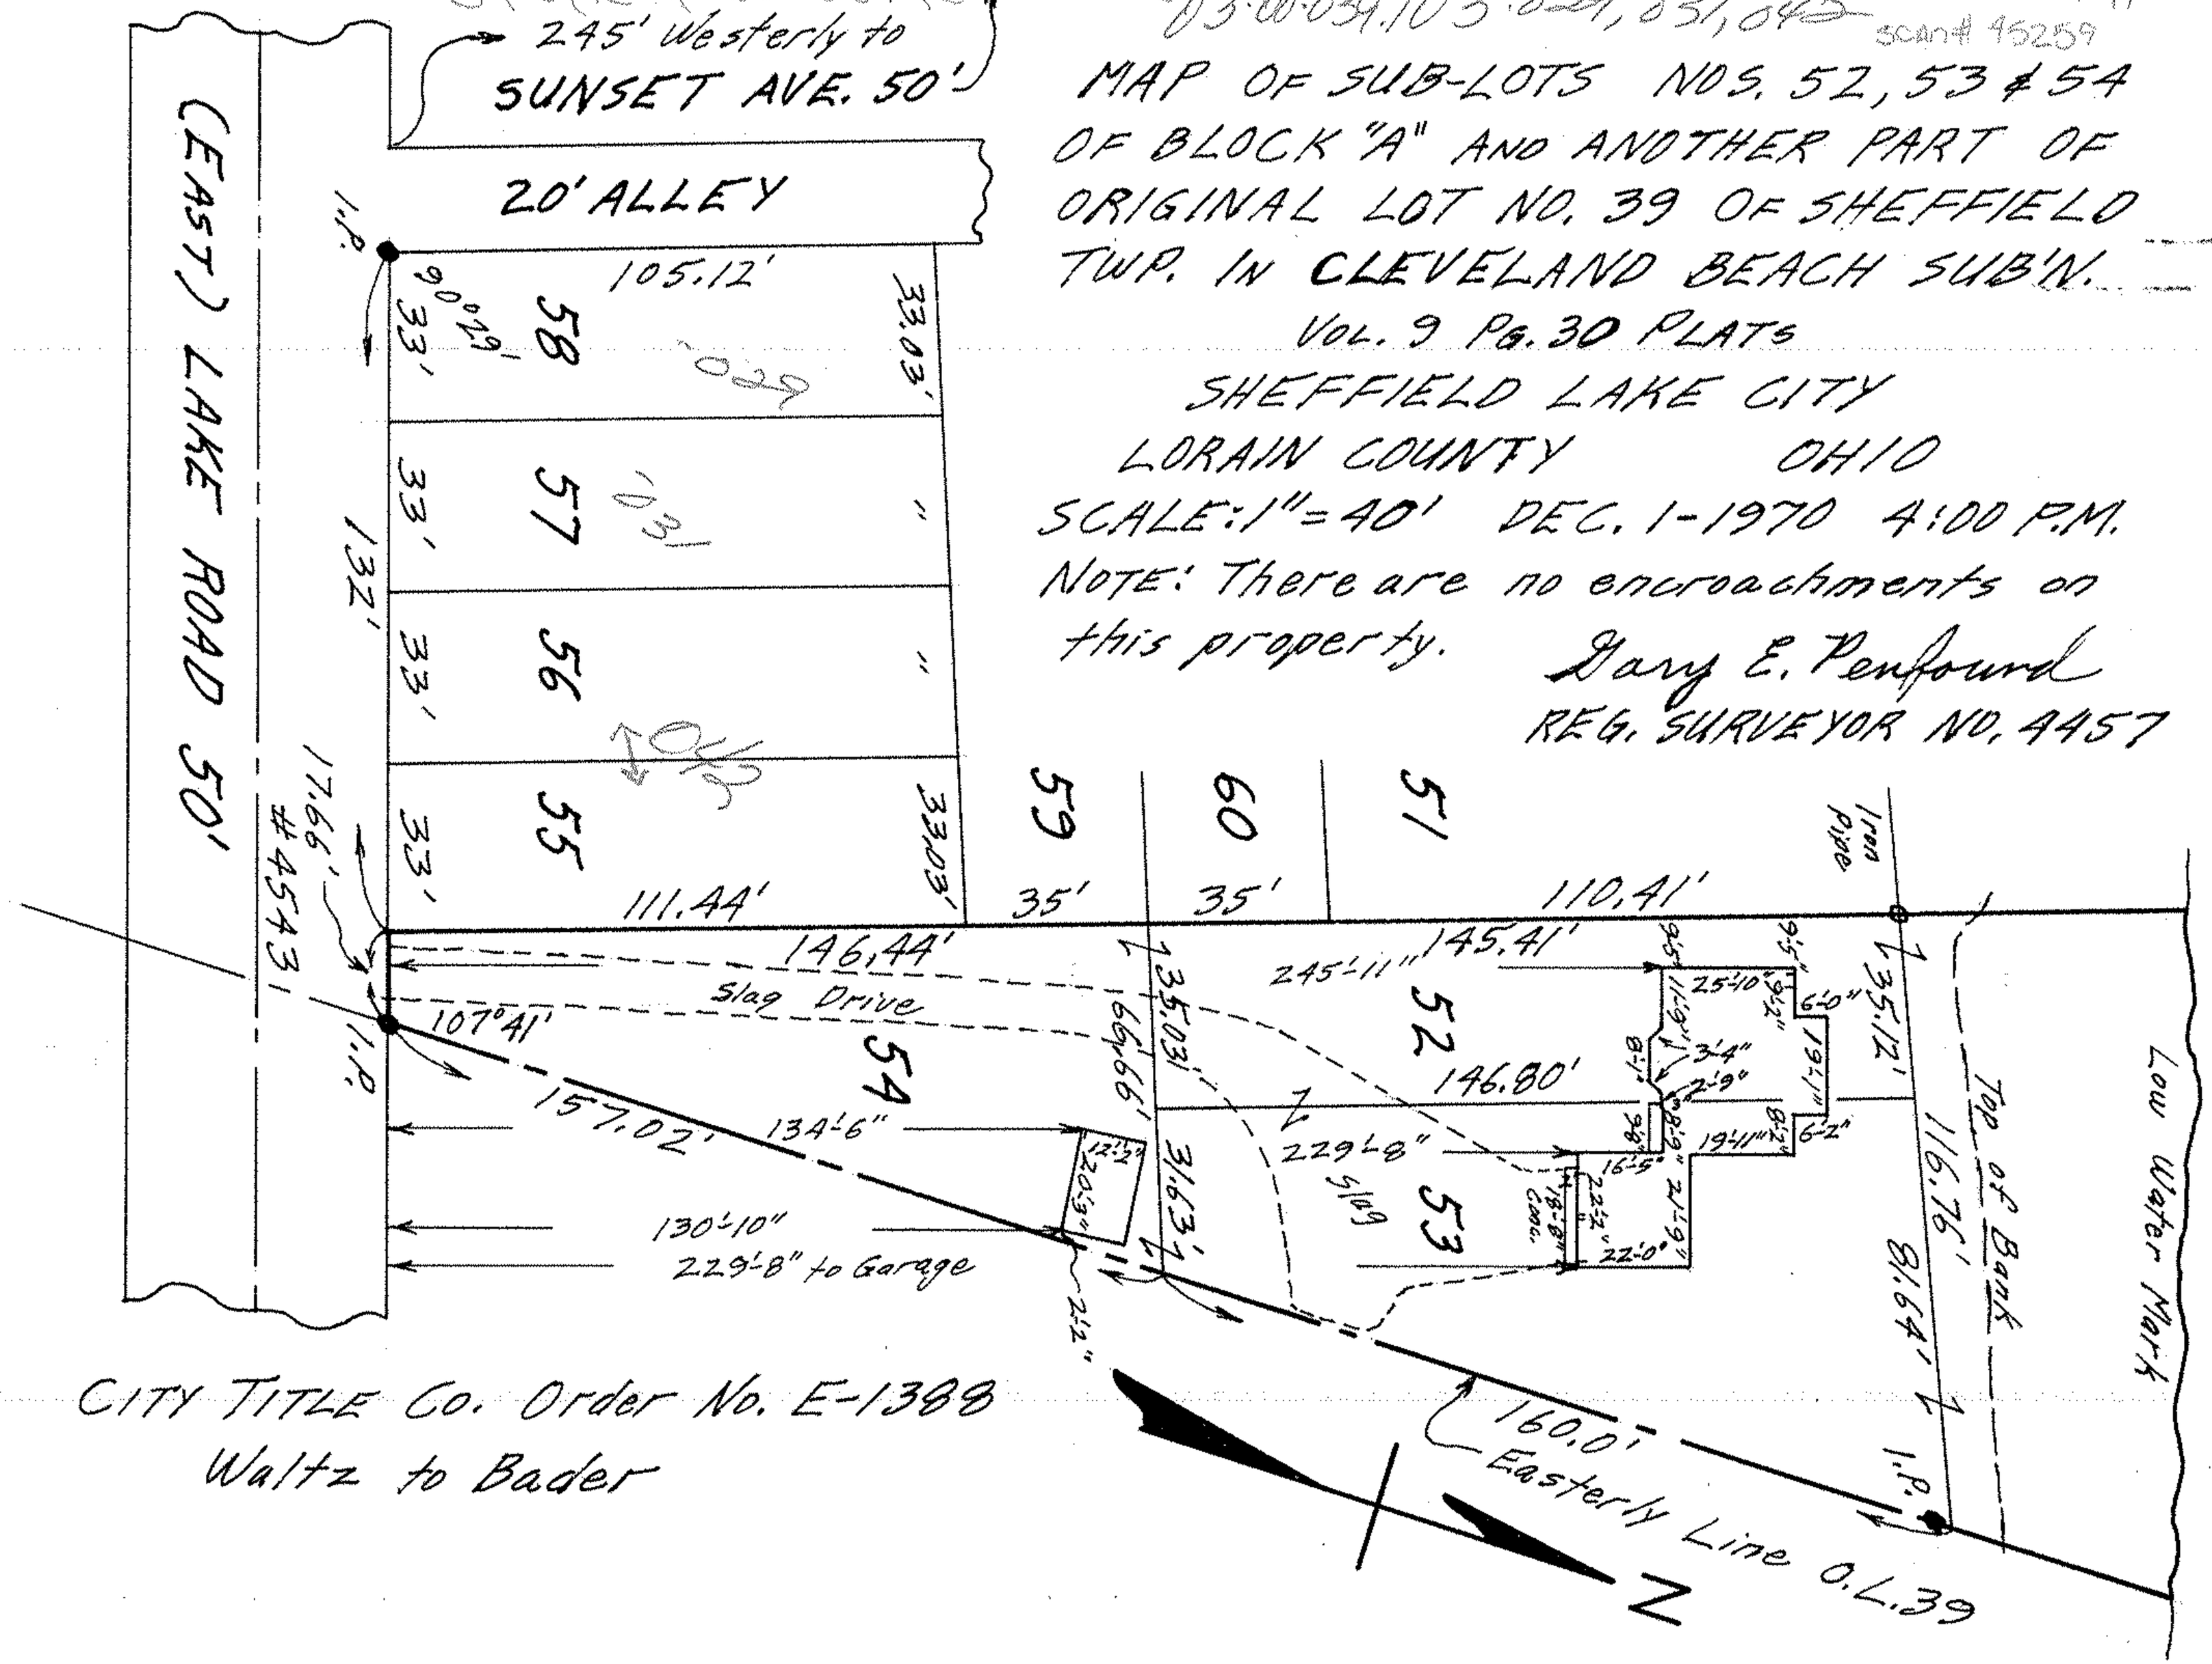

CITY TITLE CO. Order No. E-1388
Waltz to Bader