


THE OHIO BAR TITLE INS. CO.
 Milton Friedman, Agent
 Order No. 2089 - Harland C.
 & Isabel Dolamore

03.00.042.111.638, OHIO
 03.00.042-A

SCAN # 45262

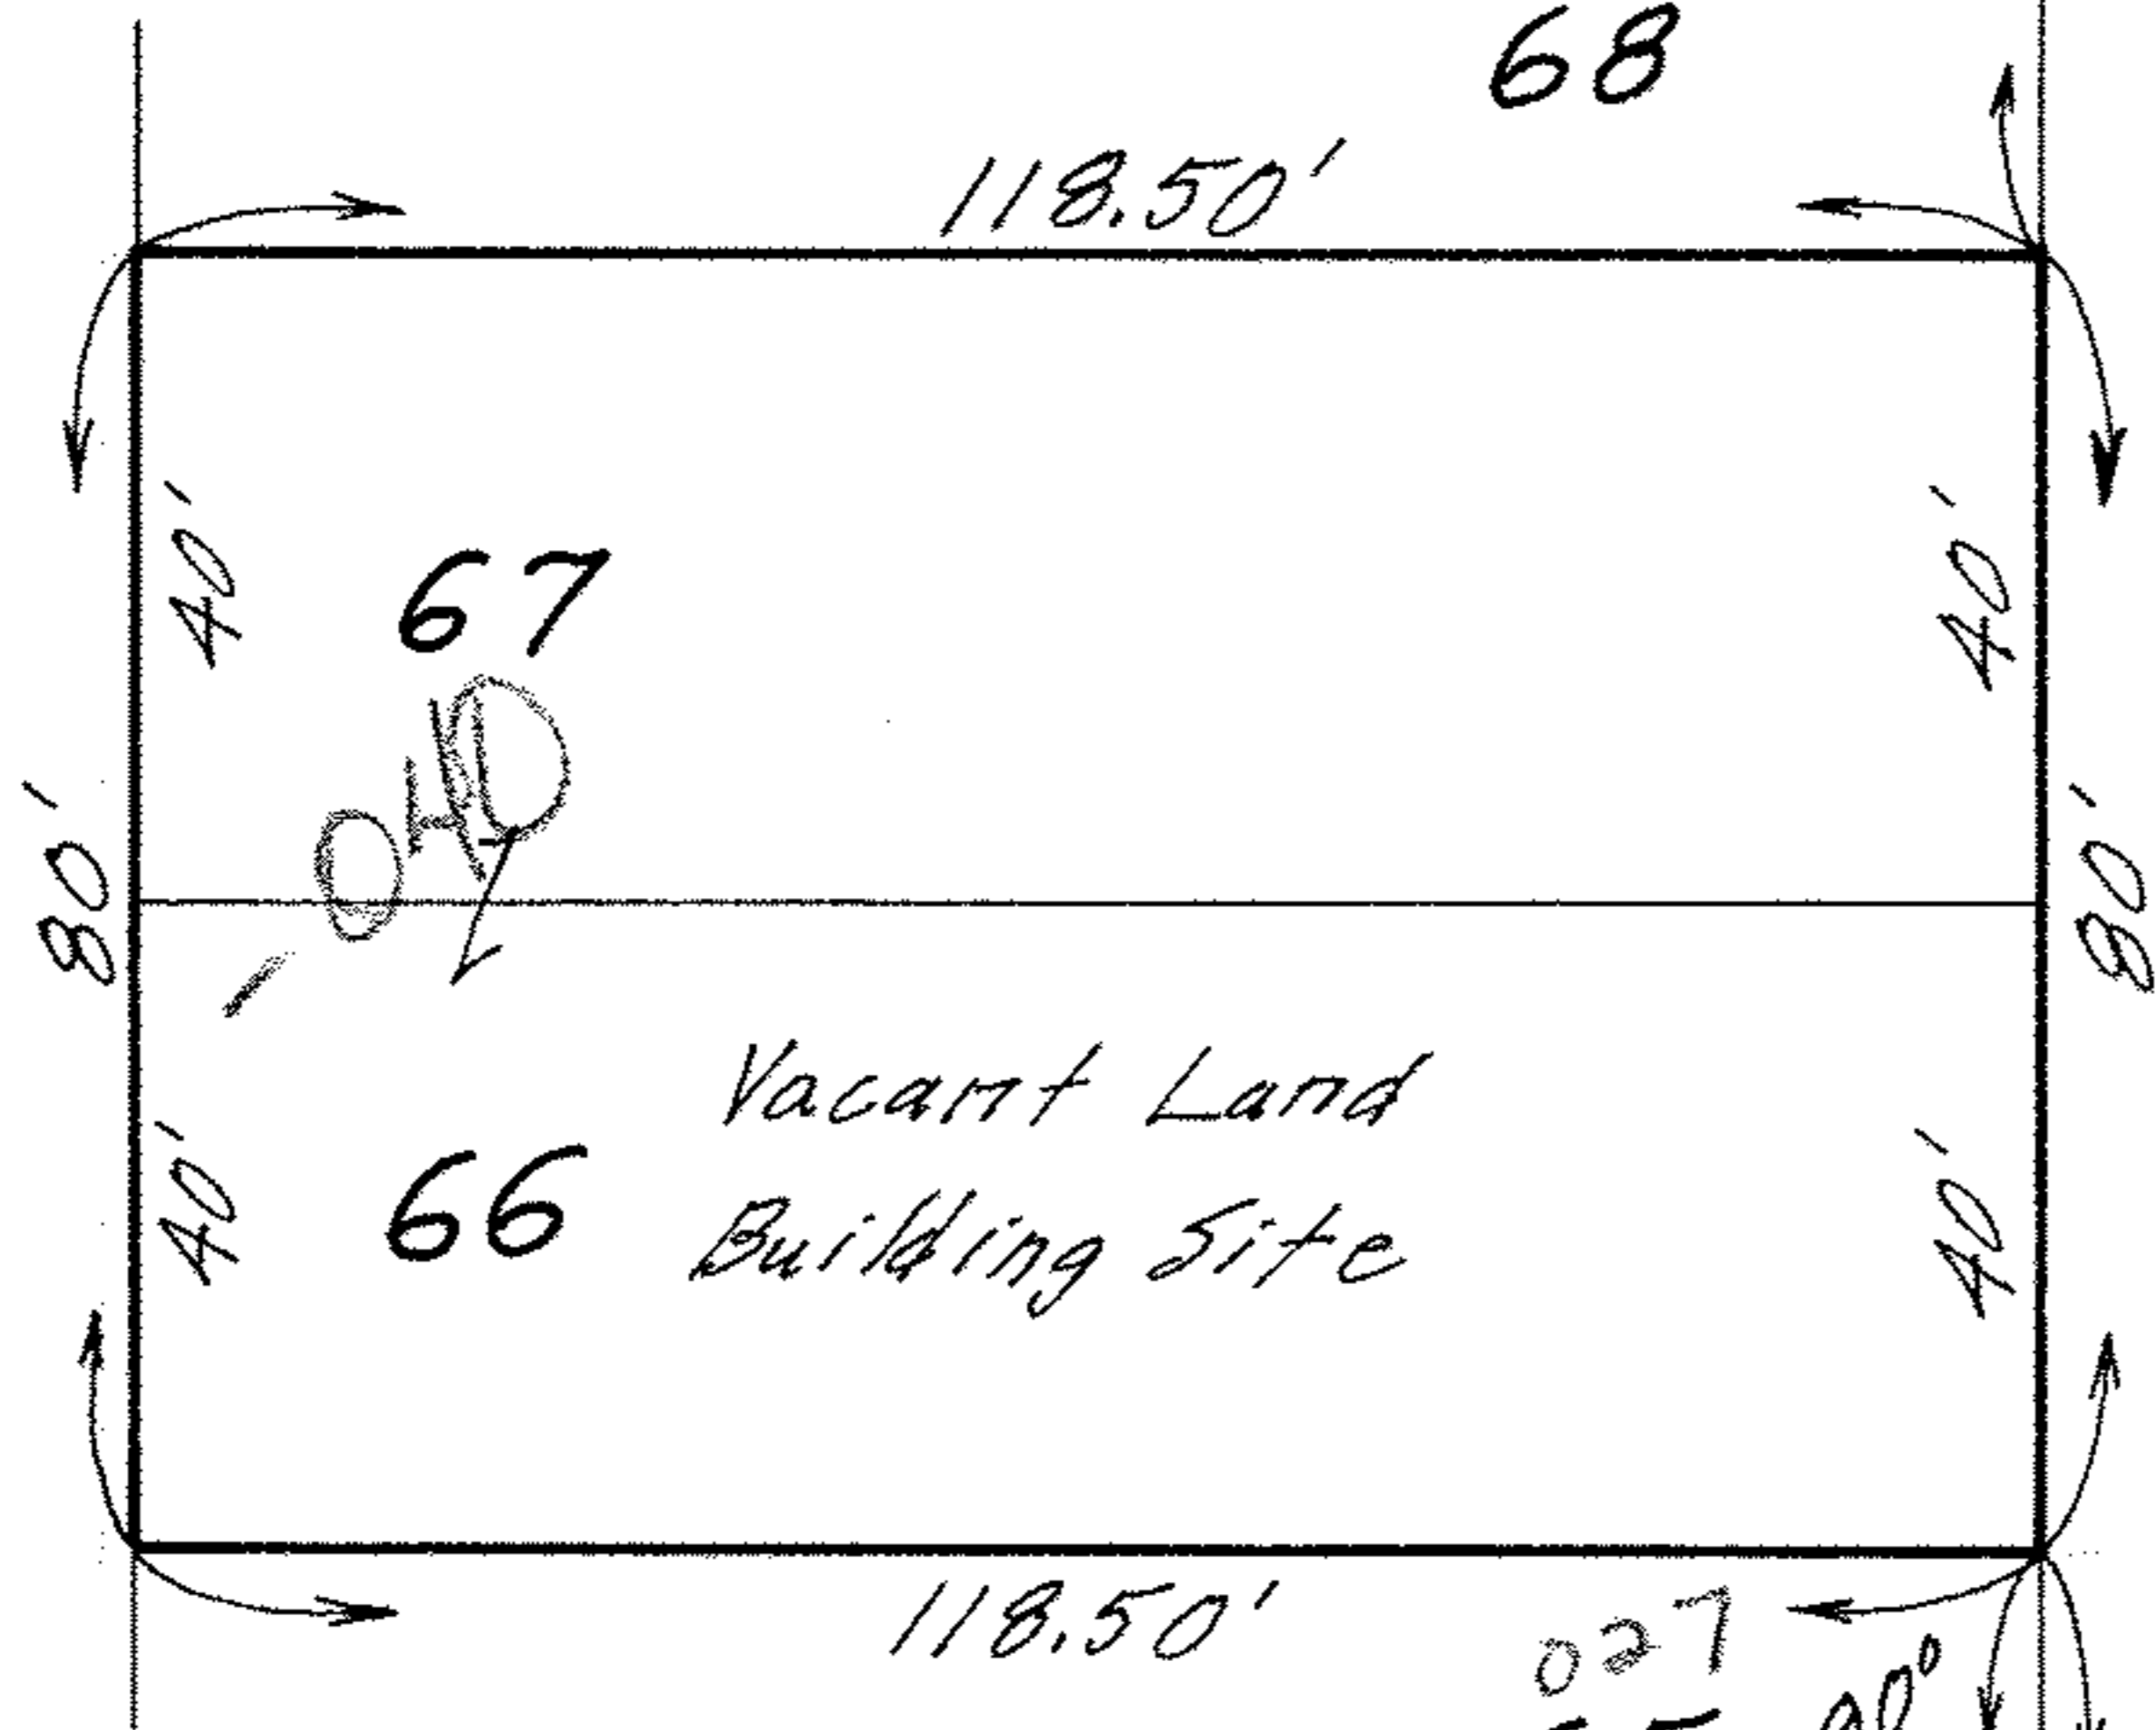

70

I.P.

69

68

027
65

90°

53

-037

I.P.

52

03.00.042.111.638

LAKE BREEZE ROAD 60'

FERNDAL AVE. 60'

MAP OF SUB-LOTS NOS. 66 & 67
 LAKE BREEZE ALL'T. VOL. 10 Pg. 21
 ORIG. LOT 42 SHEFFIELD TWP.
 SHEFFIELD LAKE CITY
 LORAIN COUNTY OHIO

SCALE: 1" = 30' MAY 26-1970 12:45 P.M.
 NOTE: There are no encroachments
 on this property.

Gary E. Penfound
 REG. SURVEYOR NO. 4457