03-00-043.109.035

03-00-043

Scan # 45266

MAP OF SUB-LOT NO. 62

COLONIAL GARDENS ALL'T. VOL. 14 PG. 16

ORIG. LOT 43 SHEFFIELD TOWNSHIP

SHEFFIELD LAKE CITY – LORAIN COUNTY – OHIO

SCALE: 1"=30' JUNE 16-1970 9:00 P.M.

NOTE: There are no encroachments on this property.

Dary E. Penfound REG. SURVEYOR NO. 4457

CITY TITLE Co. Order No. E-1153-4

Harold M. & Judith G. DeNardi to
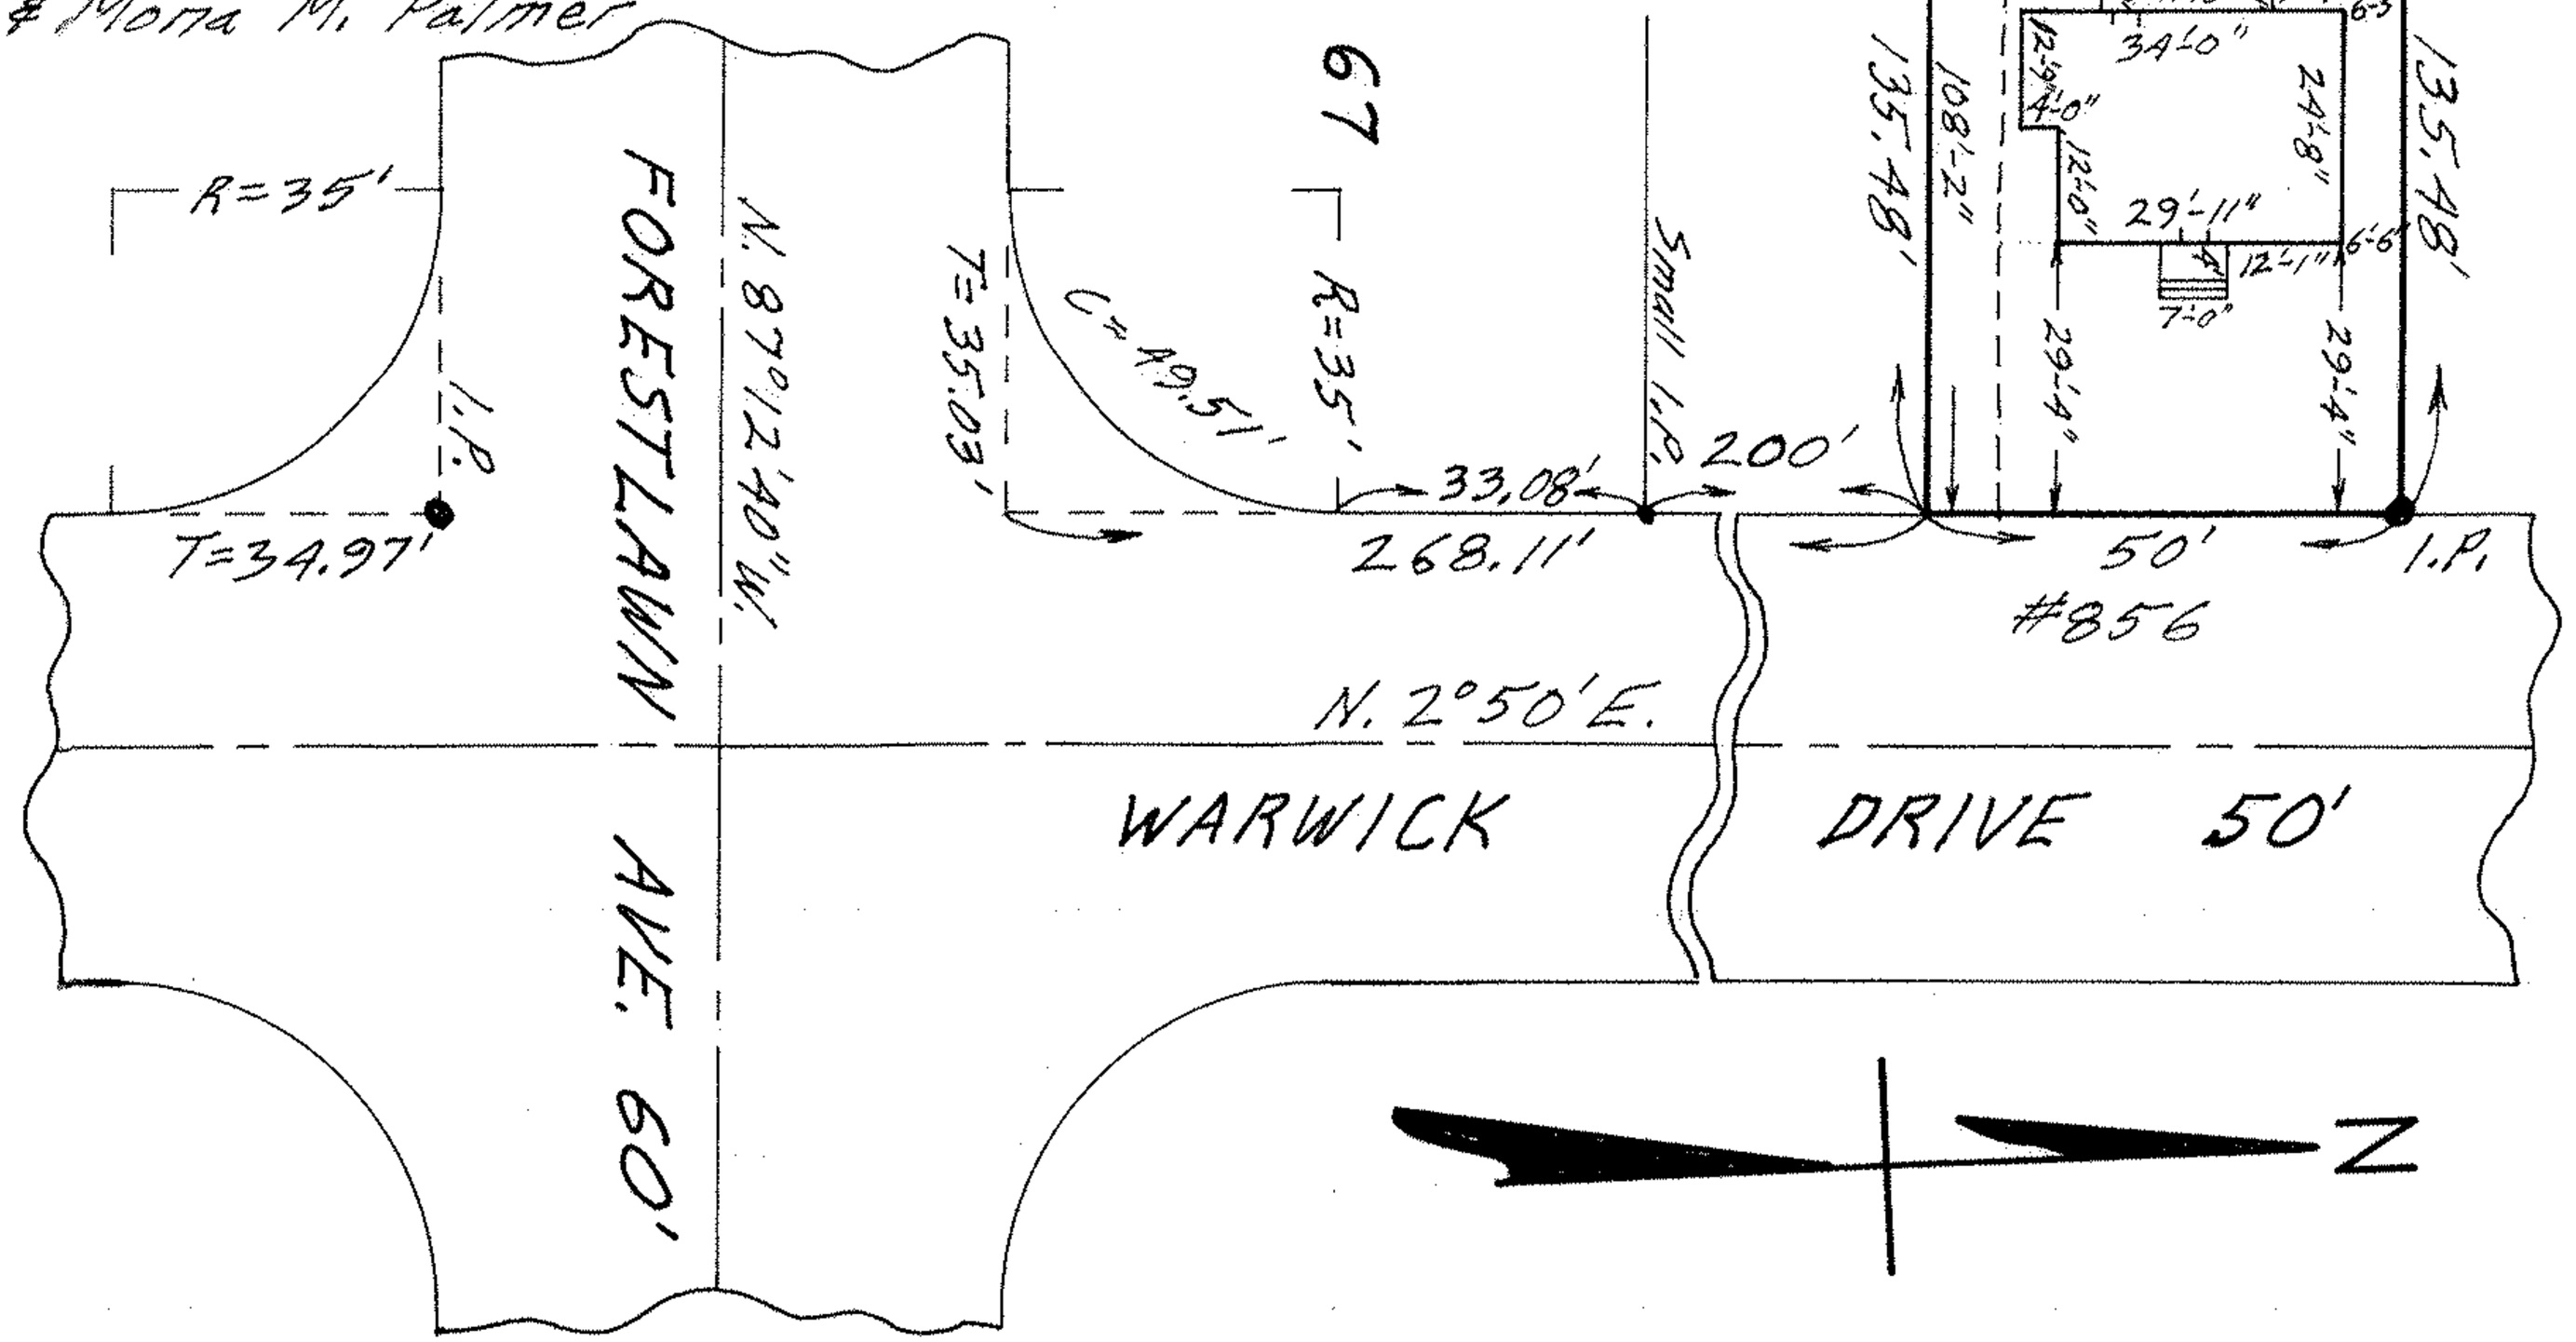
Rudy G. & Mona M. Palmer