03-00-046.111-021
6' Drainage & Utility Easement
03-00-046-021
Scan # 45269

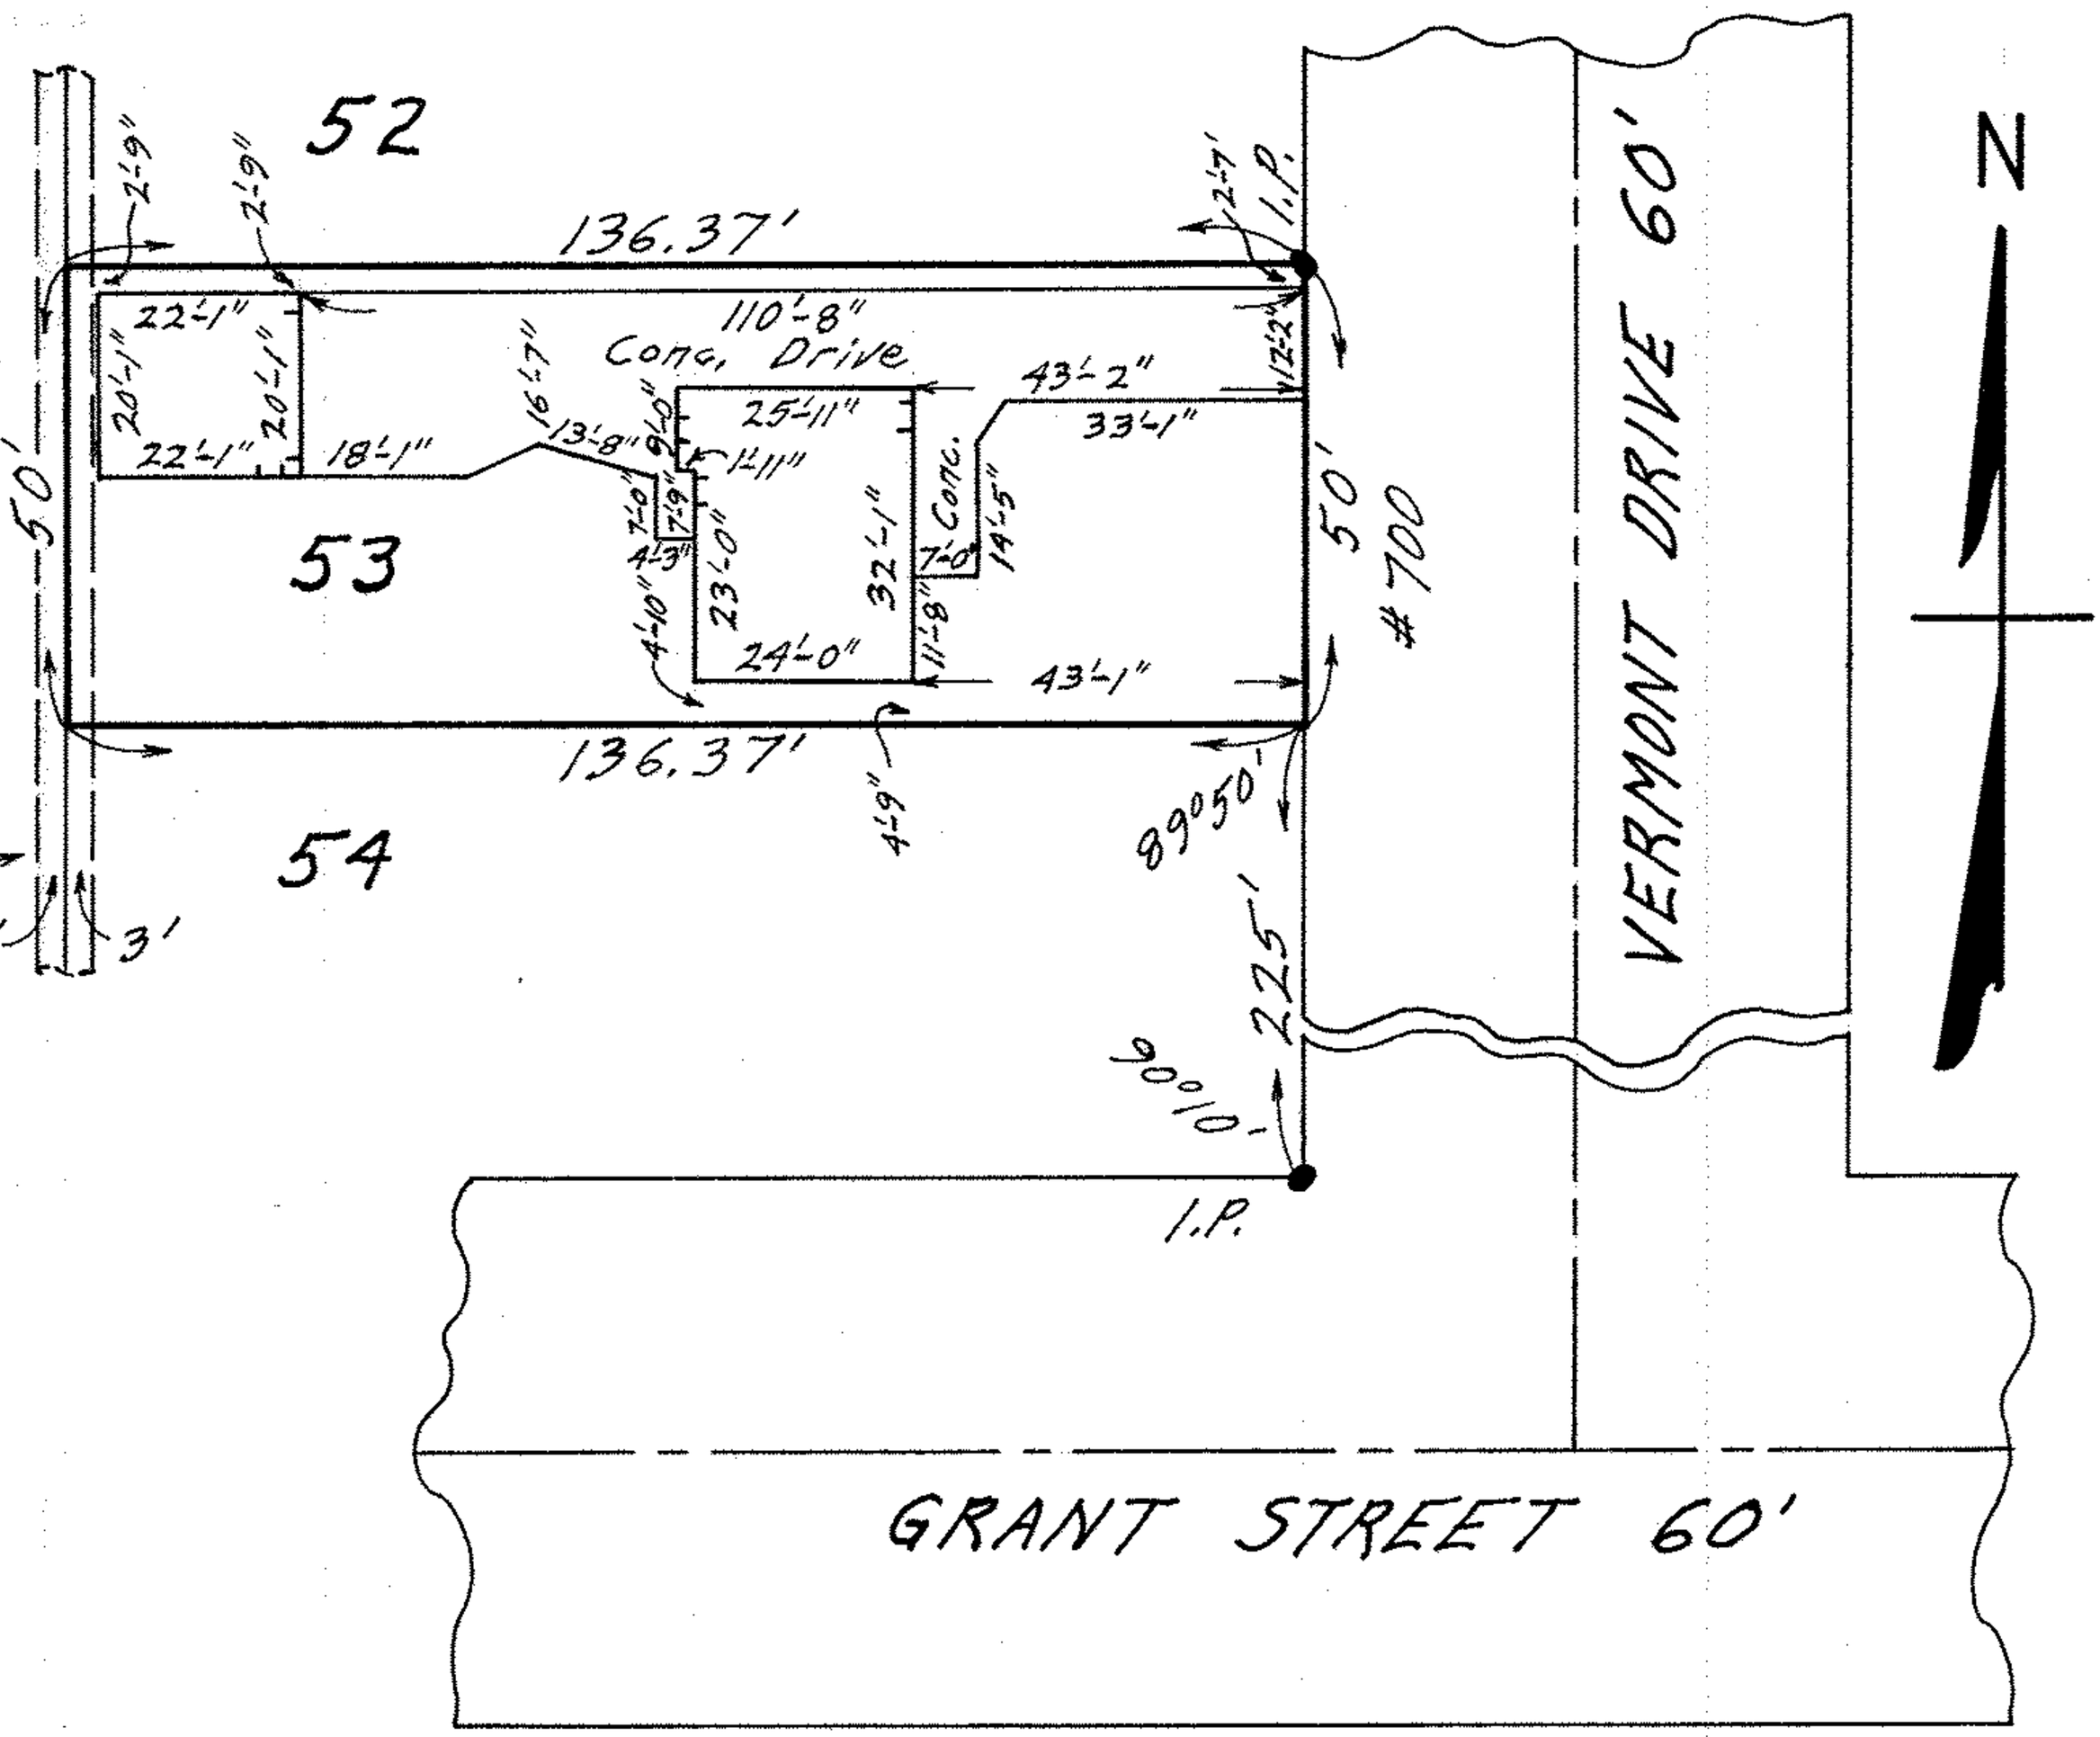

MAP OF SUB-LOT NO. 53

PEASEDALE ALL'T. VOL. 15 PG. 69 PLATS
ORIG. LOT NO. 46 SHEFFIELD TWP.
LORAIN CITY - LORAIN COUNTY - OHIO
SCALE: 1" = 30' JAN. 2-1970 3:45 P.M.
NOTE: There are no encroachments on this property.
Gary E. Penfound REG. SURVEYOR NO. 4457

CITY TITLE Co. Order No. E-1000-1
Walter D. & Audrey A. McDowell to
Robert Allen Long & Barbara G. Long