03-00-047-101-008

03-00-047-A

Scan # 45275

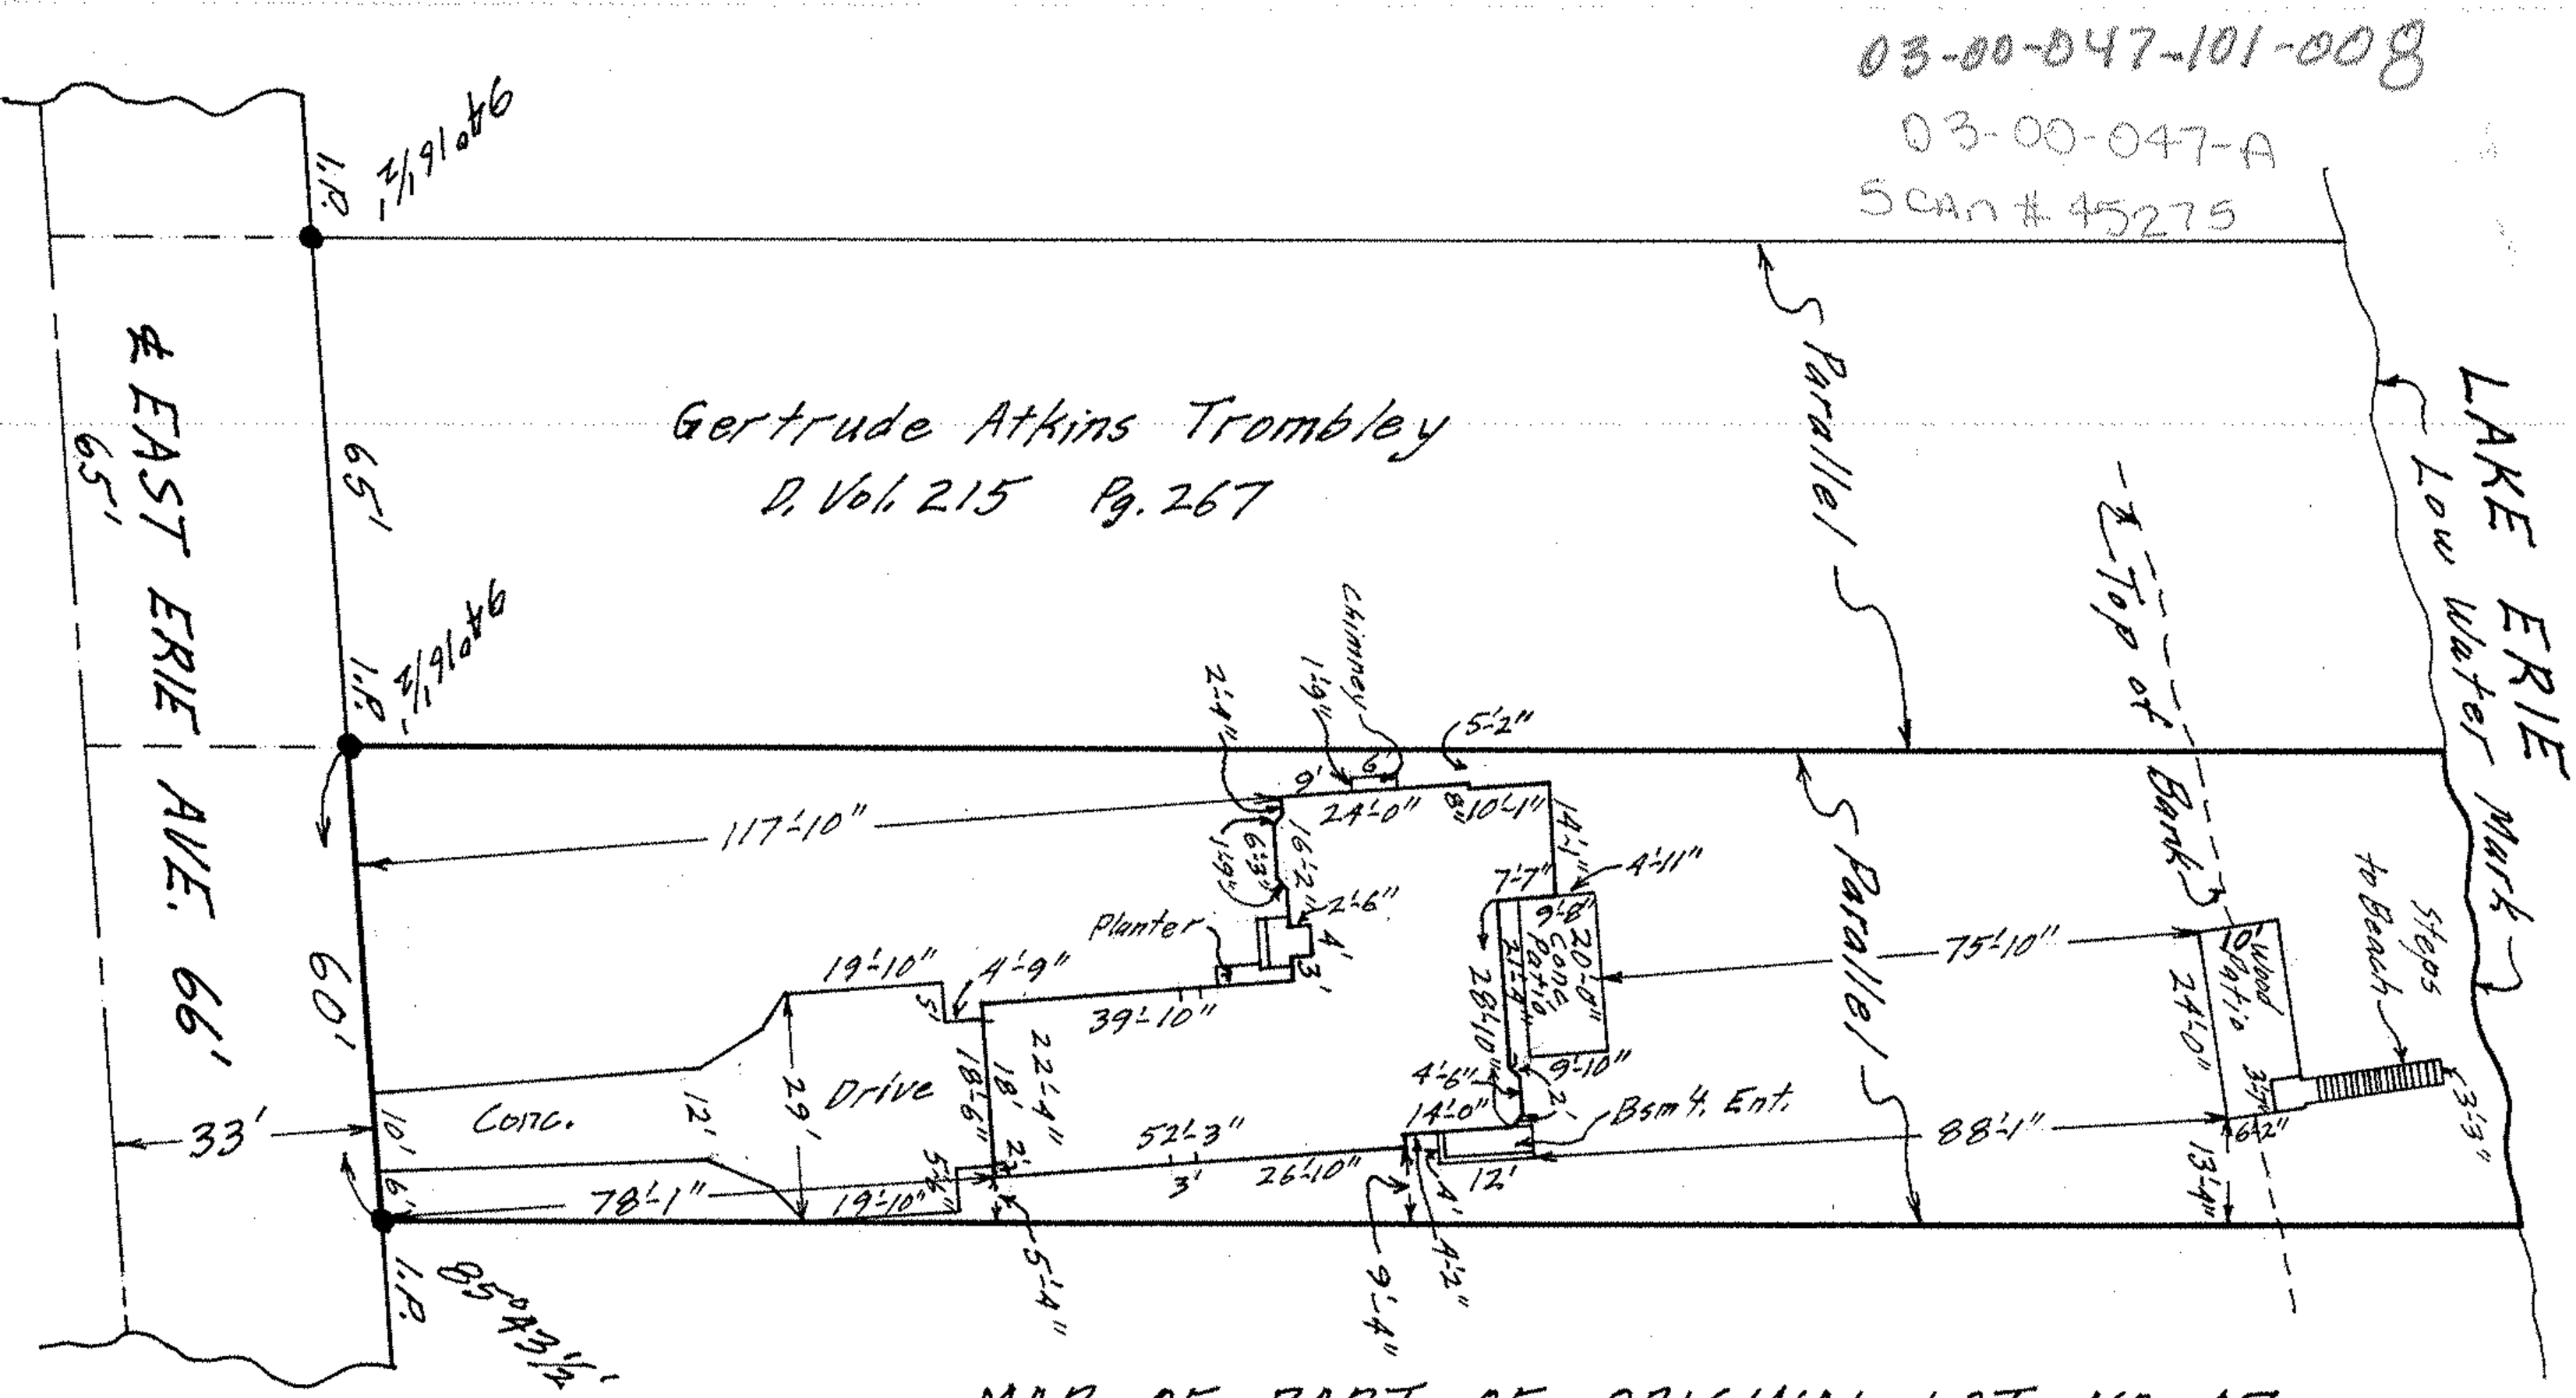

MAP OF PART OF ORIGINAL LOT NO. 47

SHEFFIELD TWP. LORAIN CITY

LORAIN COUNTY OHIO

SCALE: 1" = 30' APRIL 12-1967 12:30 P.M.

Gary E. Penfound REG. SURVEYOR

Robert L. & Martha S. Bentz

03-00-047