03-00-047-102-029

03-00-047-A

Scan#
45276

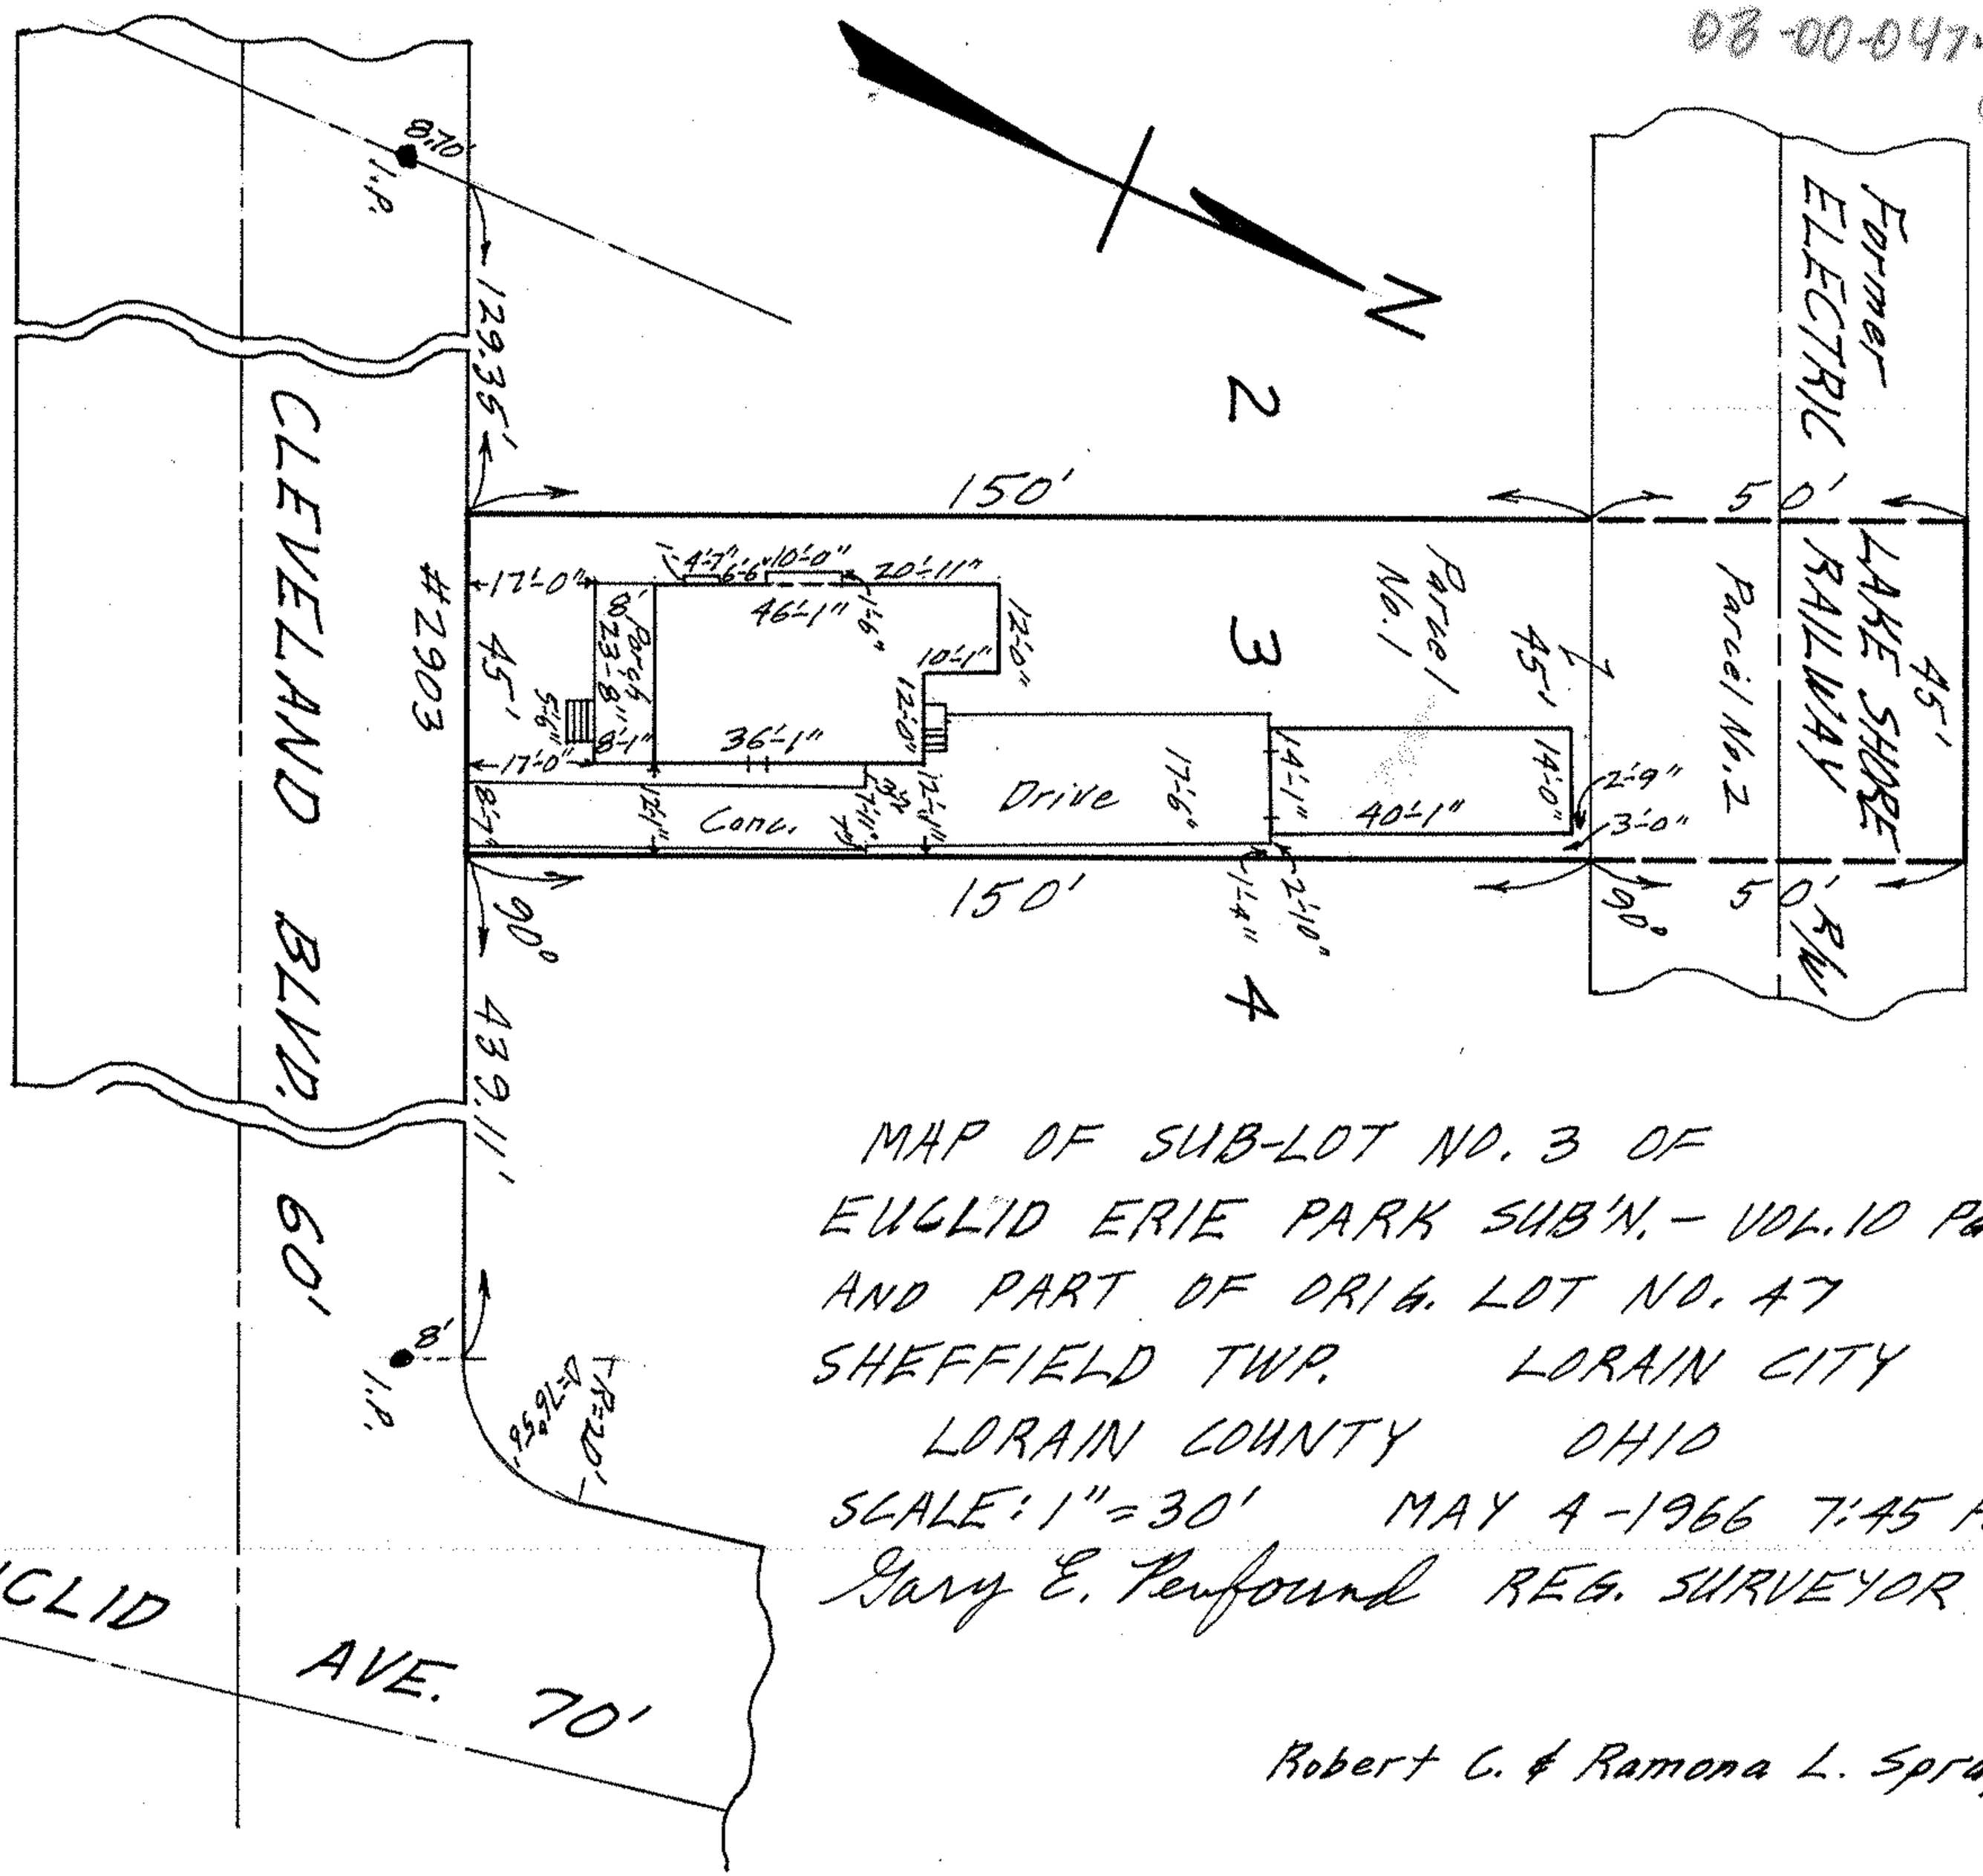

MAP OF SUB-LOT NO. 3 OF
EUCLID ERIE PARK SUB'N. - VOL. 10 Pg. 17
AND PART OF ORIG. LOT NO. 47
SHEFFIELD TWP. LORAIN CITY
LORAIN COUNTY OHIO
SCALE: 1" = 30' MAY 4 - 1966 7:45 P.M.
Gary E. Penfound REG. SURVEYOR

Robert C. & Ramona L. Sprague

PG

03-00-047